




8 TRASH ENCLOSURE TYP. SECTION
SCALE: 1/4" = 1'-0"

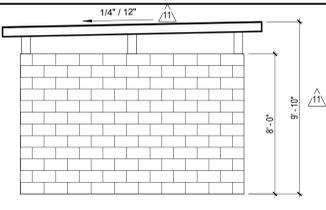


7 TRASH ENCLOSURE SOUTH ELEVATION
SCALE: 1/4" = 1'-0"

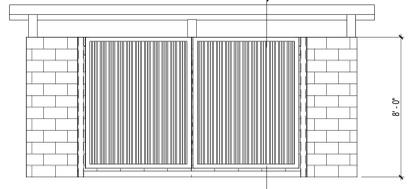


6 TRASH ENCLOSURE EAST ELEVATION
SCALE: 1/4" = 1'-0"

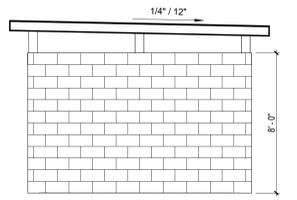


5 TRASH ENCLOSURE NORTH ELEVATION
SCALE: 1/4" = 1'-0"

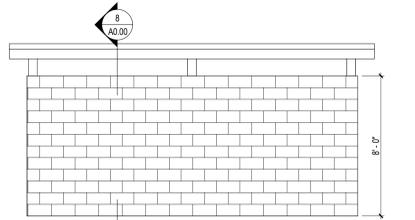


4 TRASH ENCLOSURE WEST ELEVATION
SCALE: 1/4" = 1'-0"

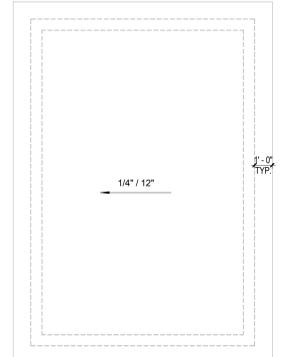


3 TRASH ENCLOSURE ROOF PLAN
SCALE: 1/4" = 1'-0"

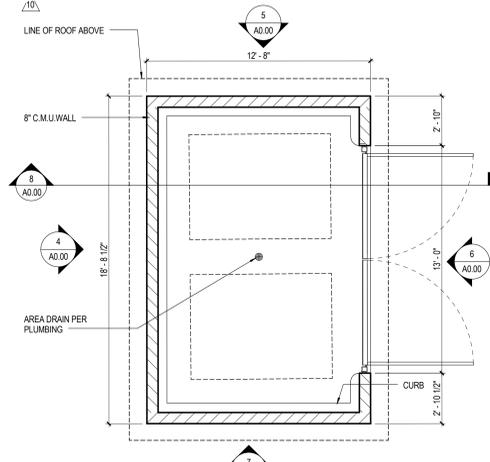


2 TRASH ENCLOSURE PLAN
SCALE: 1/4" = 1'-0"

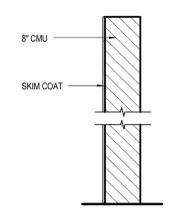

11 ENCLOSURE SECTION
SCALE: 3/4" = 1'-0"

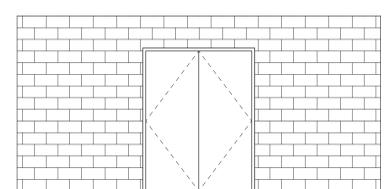


10 GENERATOR ENCLOSURE ELEVATION
SCALE: 1/4" = 1'-0"

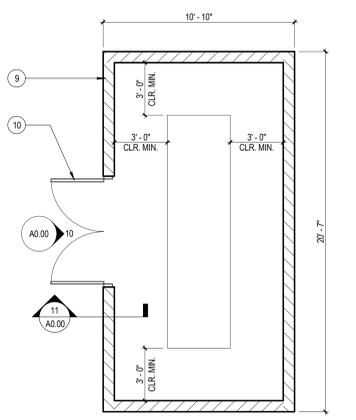

9 GENERATOR ENCLOSURE
SCALE: 1/4" = 1'-0"

HAZMAT NOTES:

1. NORMAL VENT MUST EXTEND AT LEAST 12' ABOVE GRADE AND OUTSIDE THE ENCLOSURE EMERGENCY VENTS OK
2. EMERGENCY VENT MUST BE LISTED AND MECHANICALLY STAMPED WITH REED INFORMATION IN ACCORDANCE W THE CFC
3. OVERFILL PREVENTION SHALL BE PROVIDED IN ACCORDANCE W CFC AND INITIATE AN AUDIBLE AND VISUAL ALARM AT THE TANK TO NOTIFY THE FUEL DELIVERY OPERATOR AT 90% TANK CAPACITY.
4. VEHICLE PROTECTION BOLLARDS SHALL COMPLY WITH CFC SEC 312

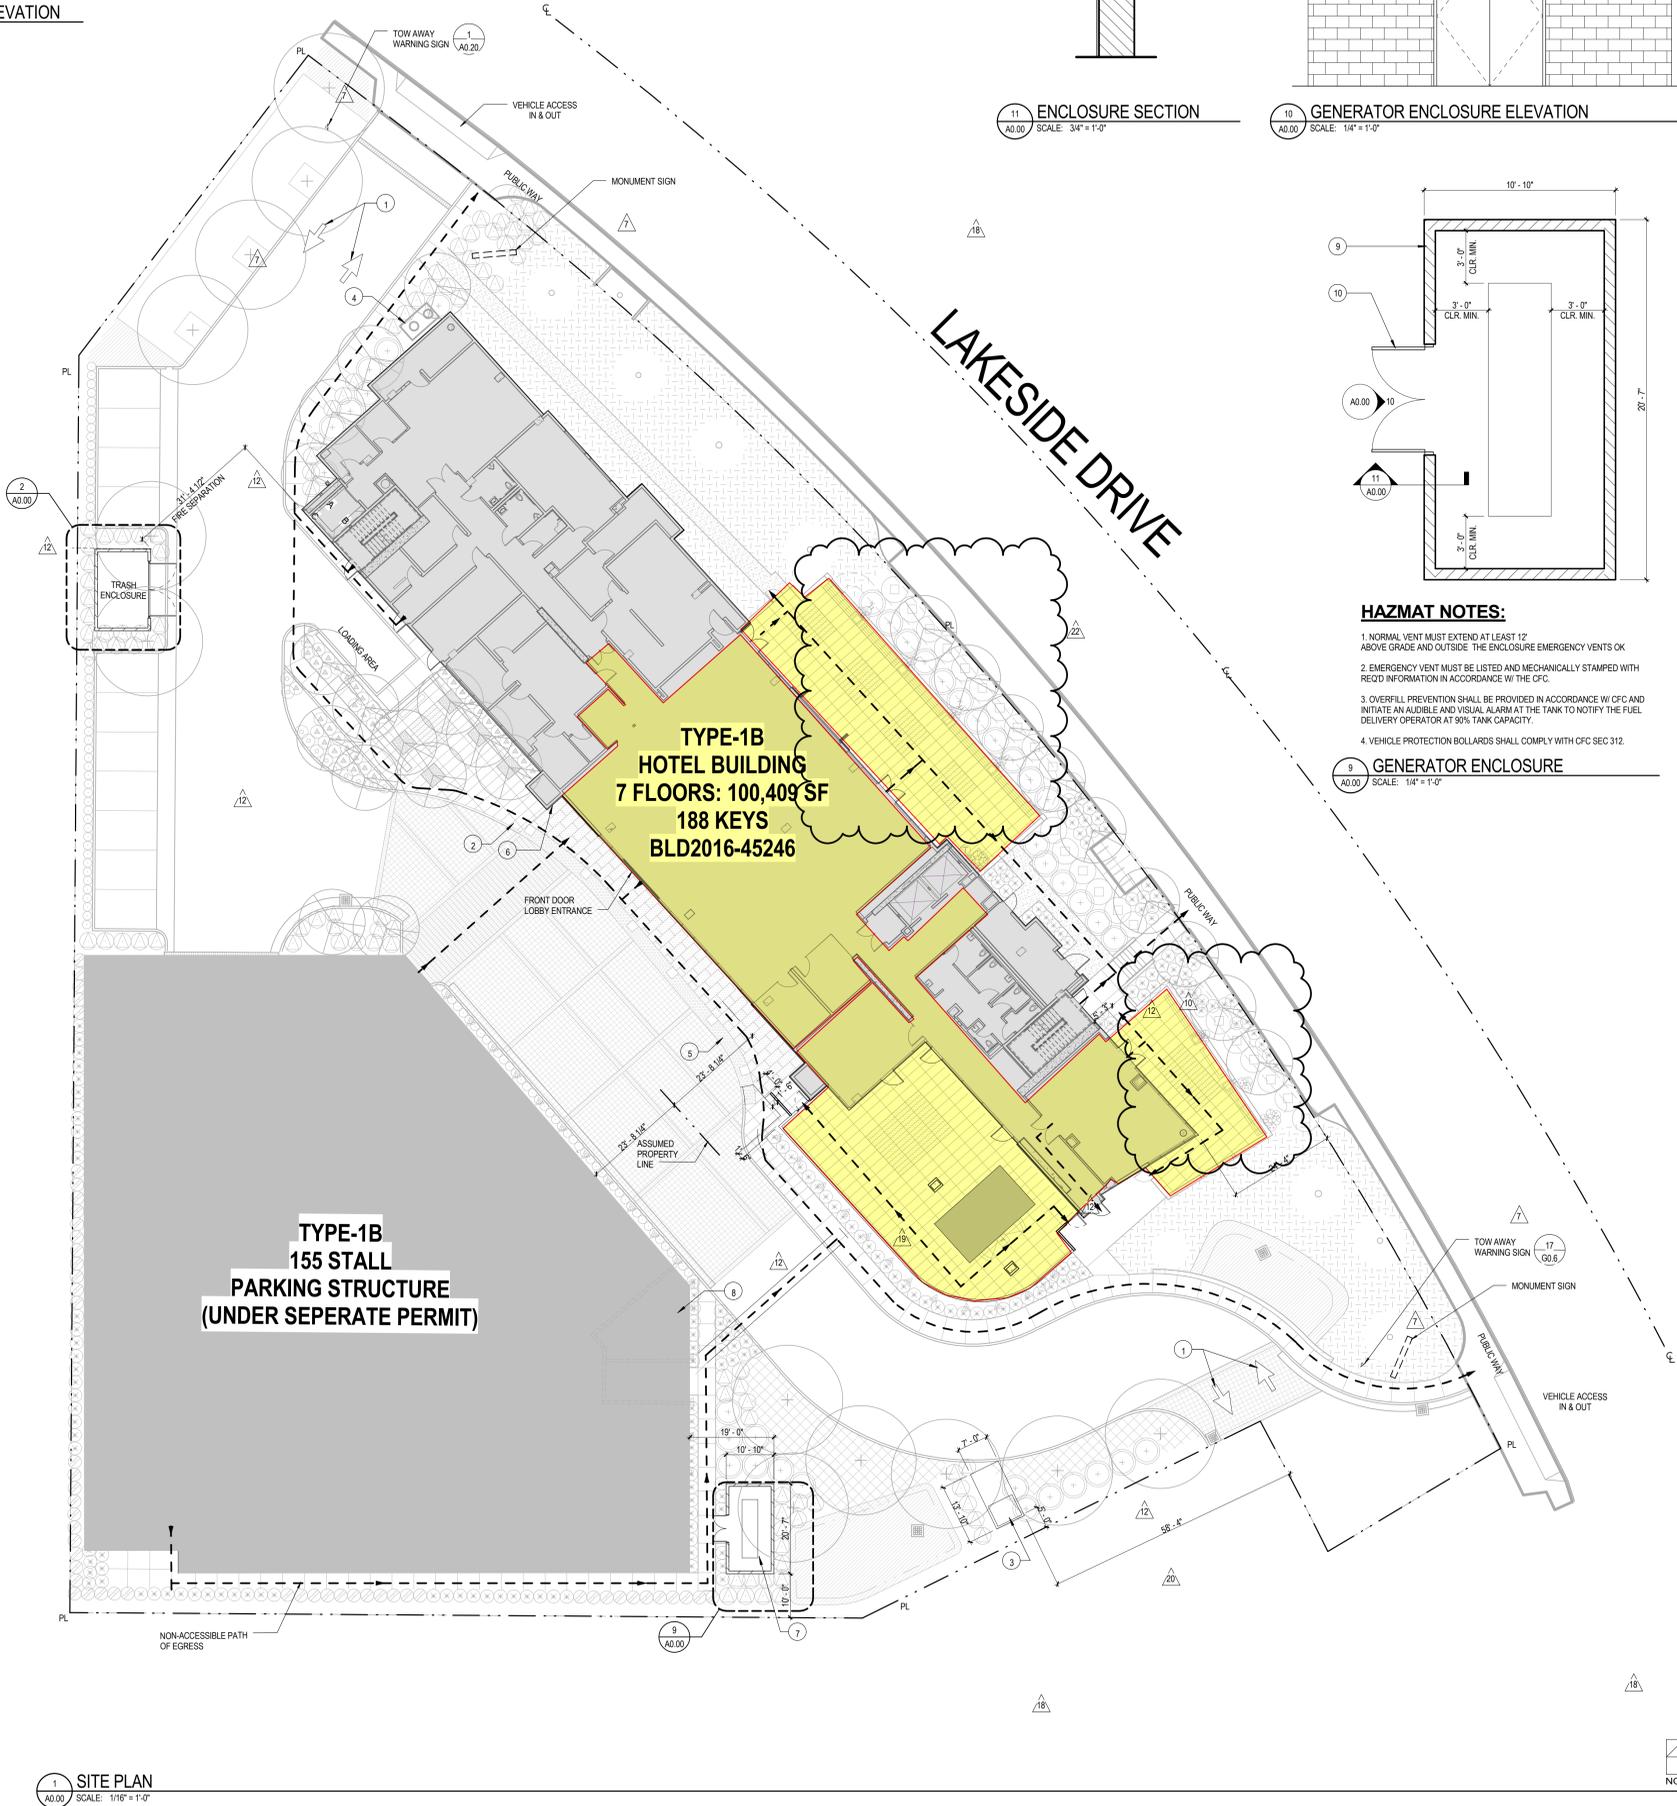

SITE PLAN GENERAL NOTES


1. FOR LANDSCAPE SYMBOLS LEGEND REFER TO LANDSCAPING PLANS
2. SEE ELECTRICAL AND LIGHTING DRAWINGS FOR PARKING LIGHTING

SITE PLAN NOTES

1. PAINTED DRIVE AISLE ENTRY AND EXIT ARROWS
2. PROVIDED TRUNCATED DOME FLOOR STRIPING AT PEDESTRIAN TRANSITIONS TO DRIVEWAYS OR DRIVE AISLES
3. ELECTRICAL TRANSFORMER WITH LANDSCAPING TO BLOCK FROM VIEW
4. UNDERGROUND GREASE INTERCEPTOR
5. BOLLARD, PER LANDSCAPE
6. KNOX BOX
7. EMERGENCY DIESEL GENERATOR ON CONCRETE PAD
8. POOL EQUIPMENT ROOM
9. 10'-0" HIGH 8" CMU ENCLOSURE WITH SKIM COAT, SEE 11.5.02 SIM
10. HOLLOW METAL DOORS


LEGEND

- ACCESSIBLE PATH OF TRAVEL TOPFROM MAIN ENTRANCE, U.O.N.

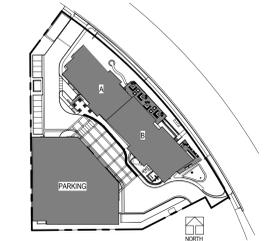

75-15746-00	07/26/2017	Revisions
7	HOTEL ONLY SUBMITTAL	07/26/2017
10	HOTEL ONLY RESUBMITTAL	10/03/2017
11	HOTEL ONLY RESUBMITTAL	11/30/2017
12	HOTEL ONLY RESUBMITTAL	01/23/2018
15	HEALTH POOL PLAN CHECK	03/16/2018
18	BULLETIN #8 OWNER	03/23/2018
19	HEALTH POOL PLAN CHECK	03/23/2018
20	BULLETIN #7 - SITE LIGHTING/GROUND FLOOR HIGH FISSURE ROOM HYDRATION STATION ON LEVEL 2'S	06/10/2018
22	BULLETIN #8 - PATIO WALLS AND DRAINAGE REVISION	08/06/2018

C:\Revit\75-15746-00_AR_2016_CENTRAL_engineer@dlr.com.rvt
8/15/2018 9:11:35 AM

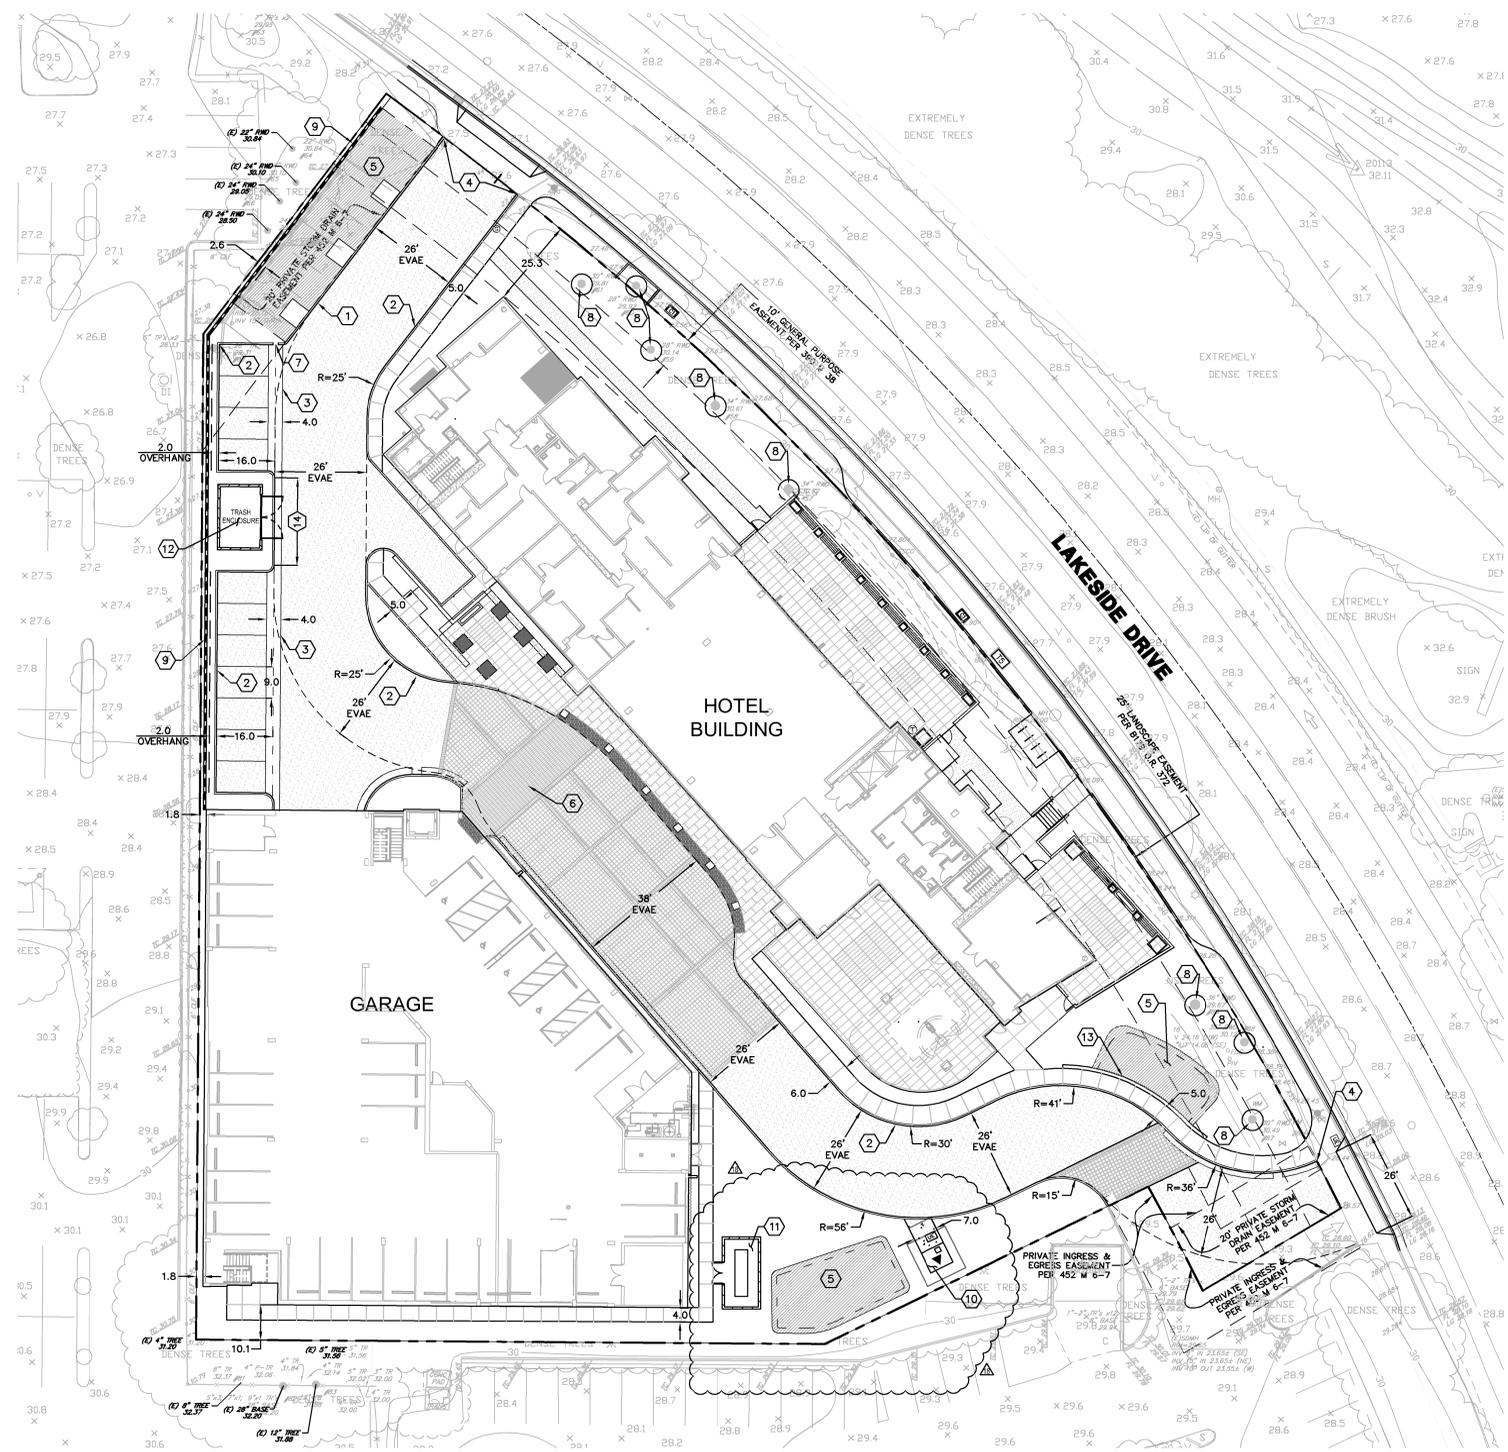

LEGEND

- PROPERTY LINE
- EASEMENT LINE
- PERIMETER WALL
- 6" VERTICAL CURB
- CONCRETE VALLEY GUTTER
- VERTICAL CURB AND GUTTER
- STORM WATER TREATMENT BASIN
- AC PAVEMENT


SITE PLAN GENERAL NOTES


1. SEE LANDSCAPE PLANS FOR SCORING OF DRIVEWAYS, ENTRIES AND WALKWAYS.
2. EXPANSION JOINTS, CONTROL JOINTS AND SCORE MARKS SHALL CONFORM TO THE CITY OF SANTA CLARA STANDARDS AND PROJECT'S GEOTECHNICAL INVESTIGATION REPORT.
3. DIMENSIONS SHOWN FOR BUILDING LOCATIONS ARE TO FACE OF BUILDING
4. ANY EXISTING TRAFFIC STRIPPING, PAVEMENT MARKINGS, PAVEMENT SURFACE, ETC. (NOT IDENTIFIED TO BE REPLACED) DAMAGED OR DESTROYED BY CONTRACTOR'S WORK SHALL BE REPLACED BY CONTRACTOR TO THE SATISFACTION OF THE CITY AT THE CONTRACTOR'S SOLE EXPENSE.
5. PRIOR TO ANY COMBUSTIBLE CONSTRUCTION OR MATERIALS ON SITE, PROVIDE FIRE ACCESS DRIVES AND OPERATIONAL ON-SITE FIRE PROTECTION SYSTEMS (FIRE HYDRANTS).
6. APPROVED FIRE APPARATUS ACCESS ROADS SHALL BE ASPHALT, CONCRETE OR ANOTHER APPROVED ALL WEATHER DRIVING SURFACE CAPABLE OF SUPPORTING THE IMPOSED LOAD OF FIRE APPARATUS WEIGHING AT LEAST 90,000 POUNDS.

SITE PLAN CONSTRUCTION KEY NOTES

- ① CONSTRUCT PRIVATE CURB AND GUTTER PER DETAIL 1, SHEET C9.0.
- ② CONSTRUCT VERTICAL CURB PER DETAIL 2, SHEET C9.0.
- ③ CONSTRUCT VALLEY GUTTER PER DETAIL 3, SHEET C9.0.
- ④ CONSTRUCT 18" TAPER CURB PER DETAIL 4, SHEET C9.0.
- ⑤ CONSTRUCT BIORETENTION BASIN PER DETAIL 8, SHEET C9.0.
- ⑥ ACCESSIBLE PATH. (SEE LANDSCAPE PLANS).
- ⑦ CONSTRUCT CURB CUT PER DETAIL 5, SHEET C9.0.
- ⑧ EXISTING TREE TO BE PROTECTED. (SEE LANDSCAPE PLANS).
- ⑨ CONSTRUCT PERIMETER WALL. (SEE LANDSCAPE PLANS).
- ⑩ CONSTRUCT CONCRETE PAD FOR TRANSFORMER. (SEE JOINT TRENCH PLANS).
- ⑪ CONSTRUCT CONCRETE PAD FOR GENERATOR. (SEE ELECTRICAL PLANS).
- ⑫ INSTALL TRASH ENCLOSURE. (SEE ARCHITECTURAL PLANS).
- ⑬ CONSTRUCT RETAINING WALL. (SEE LANDSCAPE PLANS).
- ⑭ CONSTRUCT FLUSH CURB PER DETAIL 10, SHEET C9.0.

THESE PLANS DO NOT AUTHORIZE ANY
WORK IN THE PUBLIC RIGHT OF WAY

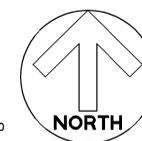

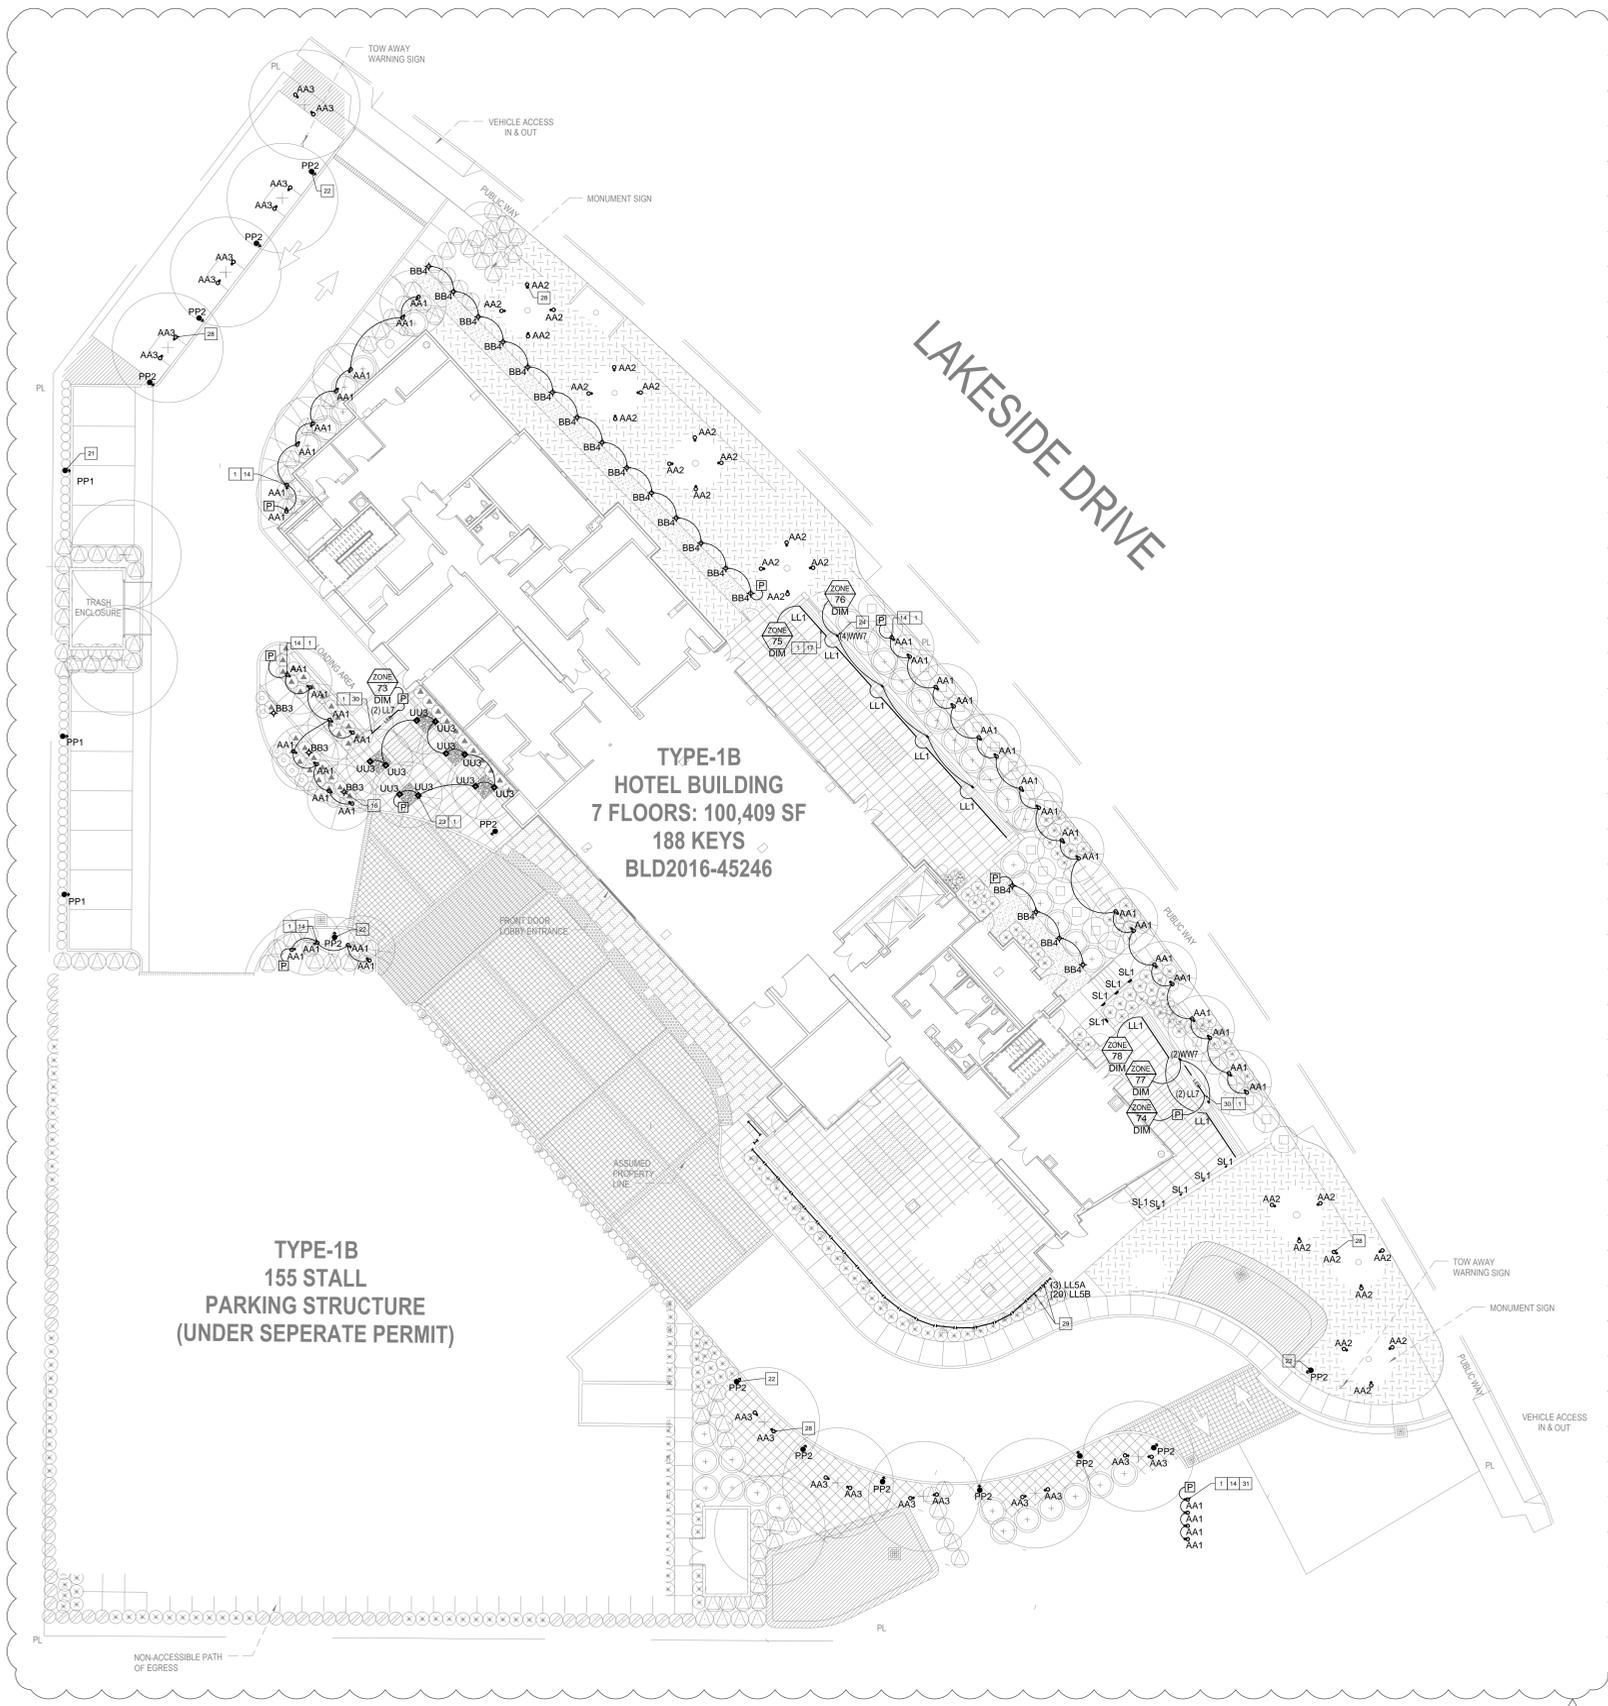

GENERAL SHEET NOTES

1. VERIFY MOUNTING LOCATIONS AND HEIGHTS OF ALL DEVICES WITH ARCHITECT PRIOR TO INSTALLATION.
2. ALL FIXTURE AND CONTROL LOCATIONS MUST BE VERIFIED BY THE LIGHTING CONSULTANT AT THE JOBSITE PRIOR TO ROUGH-IN.
3. LOOPING INDICATES CONTROL ZONE DESIGN INTENT ONLY. REFER TO ELECTRICAL DRAWINGS FOR DIMMING, SWITCHING AND CIRCUITRY INFORMATION.
4. THE CONTRACTOR IS RESPONSIBLE FOR PROVIDING ALL LABOR AND EQUIPMENT THAT IS NECESSARY FOR THE FOCUS AIMING OF ADJUSTABLE LIGHTING FIXTURES AND THE PROGRAMMING OF LIGHTING PRESETS OR EFFECTS PER THE DIRECTION OF THE LIGHTING DESIGN CONSULTANT.
5. ELECTRICAL CONTRACTOR, FIXTURE SUPPLIER, AND LAMP SUPPLIER MUST VERIFY THAT ALL LED LAMPS ARE COMPATIBLE WITH FIXTURE TRIM HOUSINGS, LAMP SOCKETS, LOW VOLTAGE TRANSFORMERS, AND ELECTRICAL DIMMING SYSTEMS PRIOR TO PLACING ANY LIGHTING EQUIPMENT ORDERS AFTER FIXTURE SHOP DRAWING SUBMITTALS ARE APPROVED. LAMPS SHOULD BE OPERABLE AT FULL OR DIMMED INTENSITY WITH NO VISUALLY PERCEIVED FLICKERING WHEN ALL LAMPS ON THE CIRCUIT ARE ENERGIZED.

KEY NOTES

1. LOW VOLTAGE REMOTE POWER SUPPLY [P] TO BE MOUNTED IN A CONCEALED, DRY, WELL VENTILATED, LOCATION WITHIN MANUFACTURER RECOMMENDED DISTANCES AND WITHIN CODE REQUIRED NEUA RATED ENCLOSURE. CONTRACTOR TO ENSURE PROPER WIRE GAUGE AND DISTANCE USED TO SUPPLY 12V OR 24V AT EACH FIXTURE (REFER TO FIXTURE SCHEDULE FOR VOLTAGE REQUIREMENTS FOR EACH FIXTURE). TRANSFORMER LOCATION TO BE VERIFIED AND COORDINATED WITH ARCHITECT PRIOR TO INSTALLATION.
2. TYPE L1 - MARKET, SURFACE MOUNTED LOW VOLTAGE LINEAR LED DOWN LIGHT IN MILLWORK RECESS AT FRONT OF SHELVES. REFER TO DETAILS 1-4LT10.01.
3. TYPE L1 - BACK BAR DISPLAY, SURFACE MOUNTED LOW VOLTAGE LINEAR LED UP LIGHT INSIDE CASE AT THE FRONT AND BACK, AND DOWN LIGHT AT FRONT OF UPPER CABINET. REFER TO DETAILS 7-12LT10.01.
4. TYPE L1 - MEETING ROOM SHELF, SURFACE MOUNTED LOW VOLTAGE LINEAR LED DOWN LIGHT IN MILLWORK RECESS AT FRONT OF SHELF. REFER TO DETAILS 1-3LT10.02.
5. TYPE L4 - TYPICAL LOW VOLTAGE COVE, SURFACE MOUNTED LOW VOLTAGE LINEAR LED COVE LIGHT, REFER TO DETAIL 3LT10.04.
6. TYPE L5 - RECEPTION TOTE KICK, SURFACE MOUNT LOW VOLTAGE LINEAR LED LIGHT AIMED TOWARD TOTE KICK IN BASE OF MILLWORK. REFER TO DETAILS 4-6LT10.02.
7. TYPE L5 - BUFFET BAR, SURFACE MOUNT LOW VOLTAGE LINEAR LED DOWN LIGHT IN MILLWORK RECESS AT FRONT OF SHELVES AND UNDER COUNTER SURFACE TO LIGHT THE BAR DIE BELOW. REMOVABLE PANEL TO HIDE REMOTE POWER SUPPLIES. REFER TO DETAILS 1-4LT10.03.
8. TYPE L5 - BAR DIE, SURFACE MOUNT LOW VOLTAGE LINEAR LED LIGHT IN MILLWORK RECESS, TO GRAZE FRONT OF BAR DIE SURFACE. REFER TO DETAILS 5-8LT10.03.
9. TYPE L6 - CORRIDOR HYDRATION STATIONS, RECESSED LOW VOLTAGE LINEAR LED DOWN LIGHT AT FRONT OF SHELF IN MILLWORK. DETAIL 1LT10.04.
10. TYPE L1 - BUFFET BAR SHELVES, SURFACE MOUNT LINEAR LED DOWN LIGHT IN MILLWORK RECESS. REFER TO DETAILS 9-10LT10.03.
11. TYPE L9 - TYPICAL DRAPERY COVE, SURFACE MOUNTED LINE VOLTAGE LED FIXTURE IN SIDE MOUNTED COVE, REFER TO DETAIL 5LT10.04.
12. TYPE L9 - TOP OF WALL COVE, SURFACE MOUNTED LOW VOLTAGE LINEAR LED LIGHT AIMED UP TO THE CEILING IN WALL HALO MILLWORK. REFER TO DETAIL 2LT10.04.
13. TYPE L9 - TYPICAL COVE LINE VOLTAGE FIXTURE, SURFACE MOUNTED LINEAR LED IN SIDE MOUNTED COVE, REFER TO DETAIL 4LT10.04.
14. TYPE AA1 - STEAK MOUNT, LOW VOLTAGE LED UPLIGHTS WITH ADDITIONAL WIRE FOR FUTURE REVISIONS. REFER TO DETAILS 182LT10.11.
15. TYPES AA4 - CK FACADE WASH, WALL MOUNTED FACADE UP LIGHT. REFER TO ELEVATIONS FOR MOUNTING HEIGHTS. PROVIDE NECESSARY DATA ENABLER MOUNTED IN AN ACCESSIBLE CONCEALED, DRY, AND WELL VENTILATED LOCATION WITHIN MANUFACTURER RECOMMENDED DISTANCES AND WITH CODE REQUIRED ENCLOSURE. PROVIDE DMX SIGNAL/CONTROL WIRING. REFER TO DETAIL 3LT10.11.
16. TYPE BB1 - LED BOLLARD CONCRETE BASE MOUNTING TO BE FLUSH WITH THE ADJACENT SIDE WALK OR GROUND SURFACE. REFER TO DETAIL 4LT10.11. **BB1** NOT USED
17. TYPE LL1 - UNDER BENCH, SURFACE MOUNTED LINEAR LED DOWN LIGHT MOUNTED UNDER BENCH TO LIGHT THE GROUND. REFER TO DETAIL 5LT10.11.
18. TYPE LL1 - EXTERIOR BAR DIE, SURFACE MOUNTED LINEAR LED DOWN LIGHT AT THE BAR DIE. REFER TO DETAILS 182LT10.12.
19. TYPE LL2 - FACADE EYEBROW UPLIGHT, WALL MOUNTED LINEAR UP LIGHT. FIXTURE TO BE ORIENTED UP. SEE ELEVATIONS FOR MOUNTING HEIGHT, REFER TO DETAIL 5LT10.12.
20. TYPE LL4 - PRUDENTIAL WALL GRAZER FIXTURE RECESSED INTO CEILING OR SOFFIT, FIXTURE INSTALLED TO THE NEAREST FOOT LENGTH (ROUND DOWN), ENTIRE LENGTH TO BE CENTERED ON THE WALL, REFER TO FIXTURE CUTSHEETS AND INSTALLATION INSTRUCTIONS.
21. TYPE PP1 - DRIVE / PARKING POLE, MOUNTED LED POLE LIGHT MOUNTED TO CONCRETE BASE. REFER TO DETAIL 3LT10.12.
22. TYPE PP2 - DECORATIVE POLE AT DRIVE ENTRIES, LED POLE LIGHT MOUNTED TO CONCRETE BASE. DETAIL 3LT10.12.
23. TYPE UJ3 - INGRADE TREE UPLIGHT, LOW VOLTAGE LED GROUND RECESSED UPLIGHT TO BE MOUNTED FLUSH WITH THE FINISHED GROUND, WITH PROPER DRAINAGE BELOW THE FIXTURE. REFER TO DETAIL 4LT10.12.
24. TYPE WW1, WW2, WW3, WW7 & WW8 - LED WALL MOUNT FIXTURE, SEE ELEVATIONS FOR MOUNTING HEIGHT, REFER TO DETAIL 5LT10.12. **WW4** NOT USED
25. TYPE LL6 - LOW VOLTAGE LINEAR LED FIXTURE IN FROSTED CORNER MOUNT CHANNEL, TO BE MOUNTED IN PORTE COCHERE CANOPY COVE ORIENTED OUT. SEE ARCHITECTURAL DETAILS FOR COVE CONSTRUCTION.
26. TYPE GR-219 - LINEAR LINE VOLTAGE LED FIXTURE TO ILLUMINATE DRAPERY, TO BE POWERED BY WALL RECEPTACLE, SEE ID SET FOR DETAIL & FIXTURE SPECIFICATION.
27. TYPE WW8 TO BE ON EMERGENCY CIRCUIT ONLY.
28. TYPE AA2 & AA3 TO UPLIGHT SPECIALTY TREES, FIXTURES TO BE SURFACE MOUNTED TO INDIVIDUAL CONCRETE PADS WITH RECESSED J-BOXES. REFER TO DETAIL 3LT10.13.
29. TYPES LL5A & LL5B - SURFACE MOUNTED TO EXTERIOR RATED J-BOXES IN SOLI. J-BOXES REQUIRED PER FIXTURE, FIXTURES TO BE SET BACK FROM GREEN WALL 10'. REFER TO DETAIL 2LT10.13.
30. TYPE LL7 - LOW VOLTAGE LED TAPE IN FROSTED CORNER MOUNT CHANNEL TO ILLUMINATE FIREPLACE TILE. FIXTURE TO BE MOUNTED IN SLOT AT TOP AND BOTTOM OF TILED WALL, REFER TO LANDSCAPE SET FOR DETAILS. REMOTE POWER SUPPLY TO BE CONCEALED IN PLANTING BEHIND FIREPLACE IN A CODE COMPLIANT WEATHER PROOF ENCLOSURE.
31. VERIFY LOCATION OF EXISTING TREES TO UPLIGHT.

HOTEL ONLY
SUBMITTAL

AC MARRIOTT HOTEL
2870 LAKESIDE DRIVE
SANTA CLARA, CALIFORNIA

OVERALL SITE LIGHTING PLAN

DLR Group
Architecture Engineering Planning Interiors
©2015, DLR Group Inc. All rights reserved.

75-15746-00
07/26/2017
Revisions

20 BULLETIN #7
SITE LIGHTING/ GROUND
FLOOR RCP/ FITNESS ROOM/
HYDRATION STATIONS ON
LEVELS 2-7 REVISIONS

08/10/2018

THE
RUZKA
COMPANY
Lighting Designers + Theatre Consultants

2 Executive Circle, Suite 200
Irvine, California 92614
(949) 253-3479
(949) 250-0181 fax
info@ruzka.com
www.ruzka.com

THIS DRAWING RELATES TO LIGHTING DESIGN INTENT ONLY. THE RUZKA COMPANY DOES NOT ASSUME RESPONSIBILITY FOR STRUCTURAL INTEGRITY, BUILDING, RIGGING, CONSTRUCTION, FABRICATION, MATERIAL, OR EQUIPMENT.

THE RUZKA COMPANY WILL NOT BE HELD RESPONSIBLE FOR THE INABILITY OF CONTRACTORS OR BUILDERS TO EXECUTE THE DESIGN PLANS.

ALL ELECTRICAL INFORMATION AND LOCAL ENERGY CODE COMPLIANCE FORMS TO BE PROVIDED BY A LICENSED ELECTRICAL ENGINEER OR ELECTRICAL CONTRACTOR.

ALL EQUIPMENT ATTACHMENT DETAILS AND STRUCTURAL LOAD CALCULATIONS MUST BE PROVIDED BY A LICENSED STRUCTURAL ENGINEER.


FOR LIGHTING DESIGN INFORMATION ONLY

1 OVERALL SITE LIGHTING PLAN
LT.100 1/16" = 1'-0"
BAR IS 3" LONG WHEN PRINTED AT FULL SCALE

LT.100
BULLETIN 7



75-15746-00	07/26/2017	Revisions
4	PERMIT RESPONSE #3	05/11/2017
5	HOTEL ONLY SUBMITTAL	07/26/2017
6	HOTEL ONLY RESUBMITTAL	09/03/2017
7	HOTEL ONLY RESUBMITTAL	11/03/2017
8	POD CORRECTIONS	01/03/2018
9	POD CORRECTIONS	01/03/2018
10	POD CORRECTIONS	01/03/2018
11	POD CORRECTIONS	01/03/2018
12	POD CORRECTIONS	01/03/2018
13	BULLETIN #6 - DOOR AND INTERIOR REVISIONS	03/29/2018
14	BULLETIN #6 - DOOR AND INTERIOR REVISIONS	03/29/2018
15	HEALTH POOL PLAN CHECK	03/29/2018
16	BULLETIN #7 - SITE LIGHTING/GRADING	04/23/2018
17	BULLETIN #7 - SITE LIGHTING/GRADING	04/23/2018
18	BULLETIN #7 - SITE LIGHTING/GRADING	04/23/2018
19	HEALTH POOL PLAN CHECK	05/23/2018
20	BULLETIN #7 - SITE LIGHTING/GRADING	05/23/2018
21	HEALTH POOL PLAN CHECK	05/23/2018
22	BULLETIN #7 - SITE LIGHTING/GRADING	05/23/2018

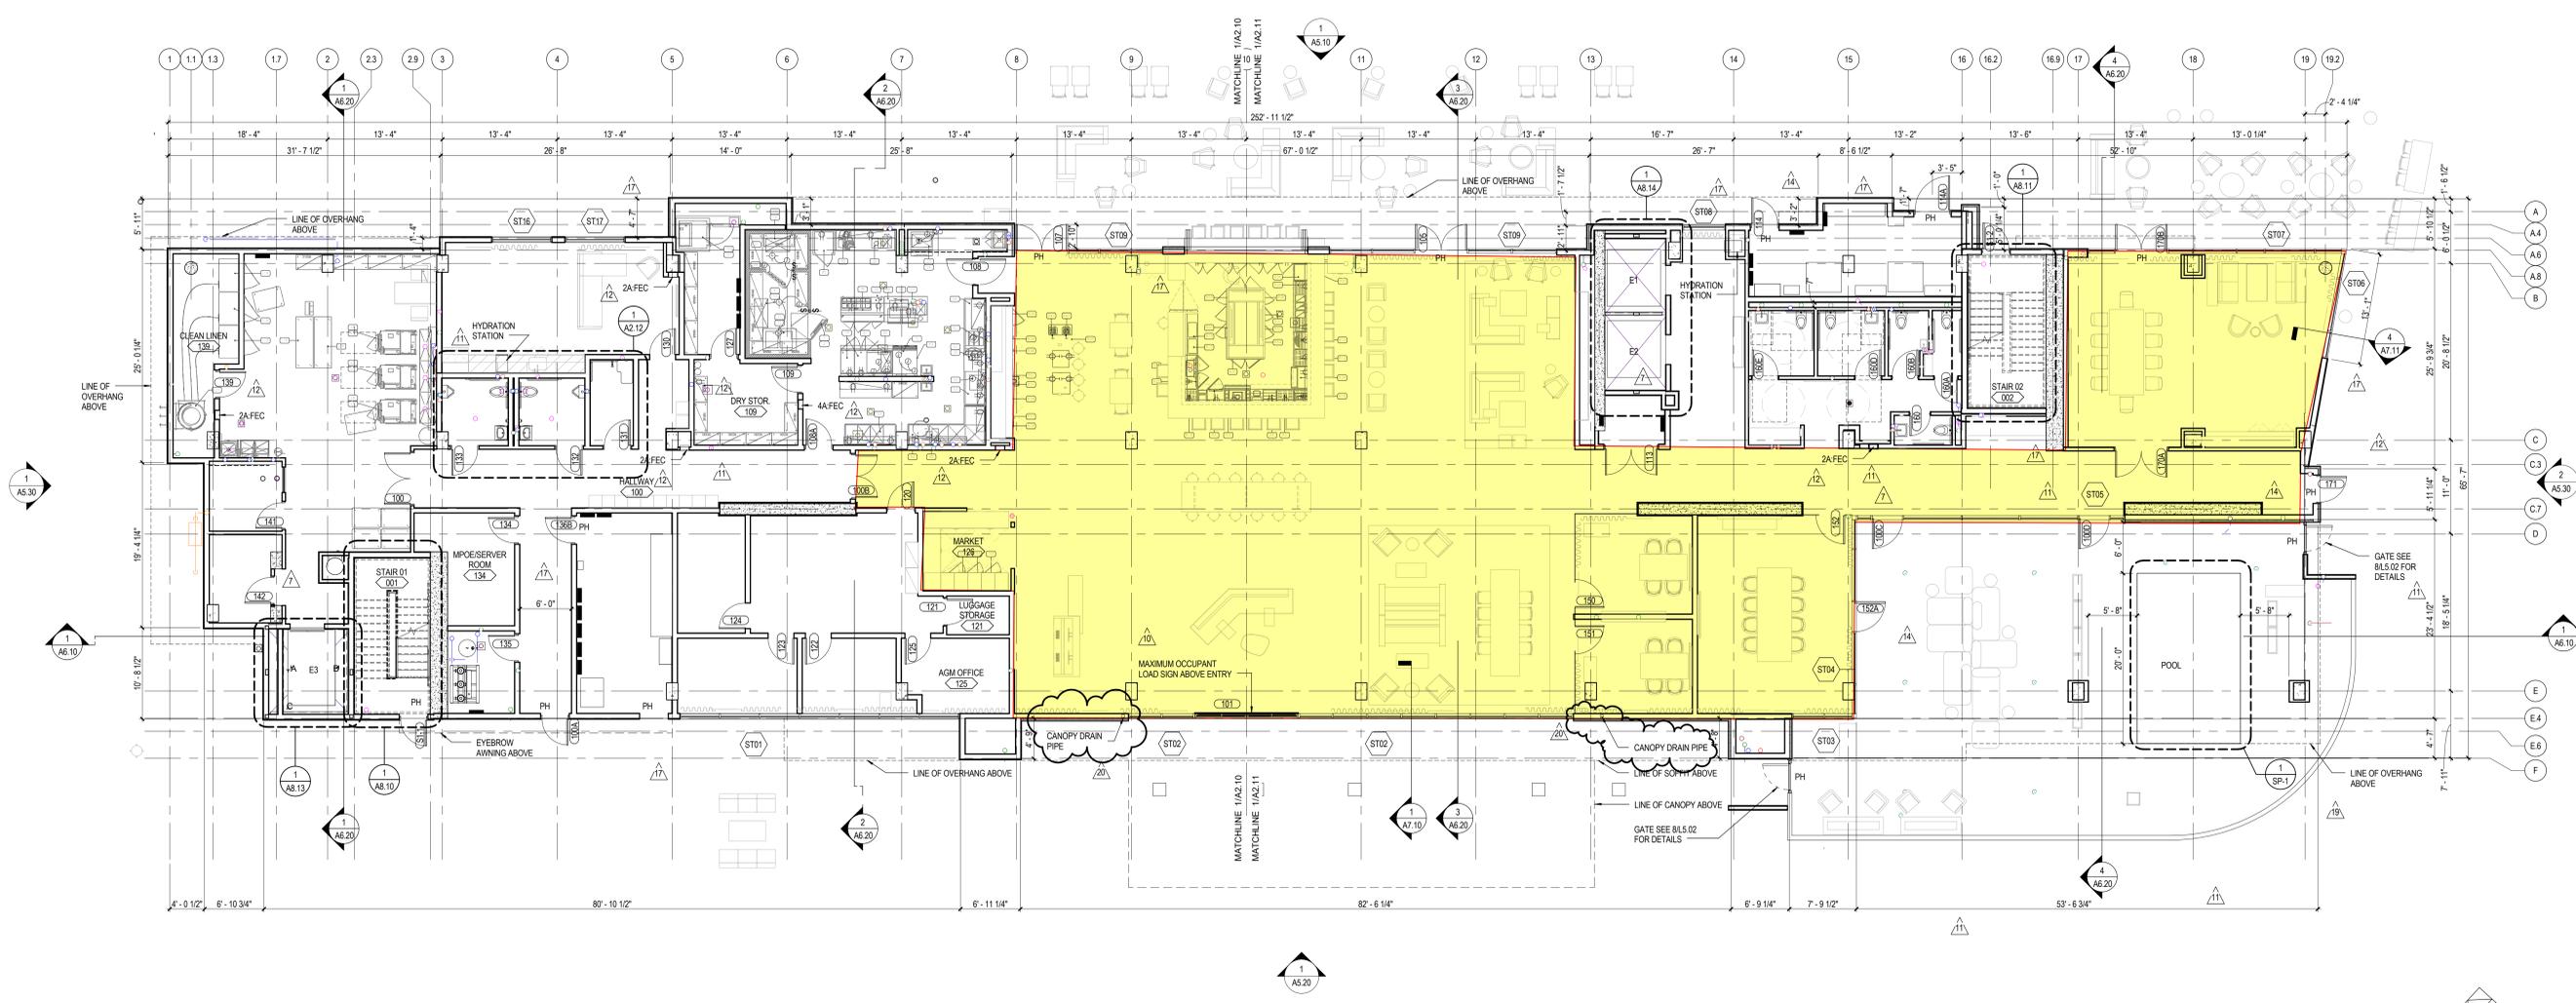

1 1ST LEVEL FLOOR PLAN
A1.10 SCALE: 1/8" = 1'-0"

OVERALL BUILDING NOTES

- A. GENERAL NOTES APPLY TO ALL SHEETS.
- B. ALL DIMENSIONS ARE TO FACE OF STUDS UNLESS OTHERWISE NOTED.
- C. G. C. TO PROVIDE 2HR FIRE RESISTANCE RATED SUPPLY BOX @ ALL SHOWER VALVE LOCATIONS.
- D. WALL TYPES SHALL BE DESIGNATED ON FLOOR PLANS. SEE SHEET A10.00 FOR PARTITION ASSEMBLIES.
- E. INTERIOR STUD WALLS SHALL EXTEND TO UNDERSIDE OF RATED FLOOR/CEILING ASSEMBLIES, OR RATED ROOF/CEILING ASSEMBLIES, UNLESS NOTED OTHERWISE. SEE REFLECTED CEILING PLAN NOTES.
- F. PROVISIONS SHALL BE MADE AT FULL HEIGHT NONBEARING WALLS FOR 1-INCH VERTICAL MOVEMENT OF BUILDING STRUCTURE WITHOUT TRANSFER OF COMPRESSIVE LOADS TO WALL. FILL IRREGULARITIES BETWEEN TOP OF WALL AND DECK ABOVE WITH FIRE SAFING INSULATION OR FIRE STOPPING MATERIALS AS REQUIRED TO MEET FIRE RATING OF RESPECTIVE WALLS.
- G. SEE STRUCTURAL DRAWINGS FOR BRACING OF NON-LOAD BEARING METAL WALLS ON GROUND FLOOR. SEE SHEET A10.00.
- H. FURNISH AND INSTALL METAL BLOCKING IN METAL STUD PARTITIONS FOR PROPER ANCHORAGE OF WALL ATTACHED ITEMS, I.E. TOILET ACCESSORIES, TOILET PARTITIONS, CASEWORK, MILLWORK, WALL-MOUNTED FIXTURES, MARKERBOARDS, TACKBOARDS, DOOR STOPS, AUDIO VISUAL BRACKETS, ETC.
- I. GYPSUM BOARD AND PLASTER SURFACES SHALL BE ISOLATED WITH CONTROL JOINTS WHERE INDICATED ON DRAWINGS AND/OR AS DESCRIBED IN THE SPECIFICATIONS.
- J. PROVIDE 5/8" TYPE-X MOISTURE RESISTANT GYP. BD. @ BATHROOM WALLS AND CEILINGS.
- K. REFER TO PROJECT MANUAL, SECTION 01 11 00, FOR ITEMS THAT ARE: 1. OWNER-FURNISHED / OWNER-INSTALLED 2. OWNER-FURNISHED / CONTRACTOR-INSTALLED
- L. REFER TO PROJECT MANUAL, SECTION 01 11 00, FOR ITEMS THAT ARE: 1. OWNER-FURNISHED / OWNER-INSTALLED 2. OWNER-FURNISHED / CONTRACTOR-INSTALLED
- M. ARCHITECTURAL GROUND FLOOR ELEVATION OF -0'-0" EQUALS FLOOR ELEVATION OF 179.00 FEET, PER CIVIL PLANS.
- N. SCRIBE GYPSUM BOARD OF WALL AND PARTITIONS TO IRREGULARITIES OF DECK ABOVE. SEAL TIGHTLY AROUND PENETRATIONS.

- O. PROVIDE SEISMIC BRACING FOR SUSPENDED CEILINGS OR AS INDICATED ON DRAWINGS.
- P. DOORS TO BE OPENABLE FROM INSIDE WITHOUT A KEY OR ANY SPECIAL KNOWLEDGE.
- Q. ANNULAR SPACES AROUND PIPES, ELECTRIC CABLES, CONDUITS OR OTHER OPENINGS IN SILL OR BOTTOM PLATES AT EXTERIOR WALLS SHALL BE PROTECTED AGAINST THE PASSAGE OF RODENTS BY CLOSING SUCH OPENINGS WITH CEMENT MORTAR, CONCRETE MASONRY, OR SIMILAR ACCEPTABLE METHODS. CGSC SECTION 4.408.1.
- R. BATHROOM EXHAUST FANS MUST BE ENERGY STAR COMPLIANT. MUST BE DUCTED TO TERMINATE OUTSIDE THE BUILDING, AND MUST BE CONTROLLED BY A HUMIDISTAT WHICH SHALL BE READILY ACCESSIBLE. CGSC SECTION 4.508.
- S. FOR MILLWORK PLANS SEE INTERIOR DESIGN PLANS.
- T. G. C. TO PROVIDE MINERAL FIBER FIREBLOCKING AT PENETRATIONS CONNECTING NOT MORE THAN TWO STORIES.
- U. ALL FLOOR CLEAN-OUTS LOCATED IN CARPETED AREAS ARE TO BE FITTED WITH CARPET INSERTS. ALL CLEAN-OUTS TO BE FLUSH TO FLOOR/WALLS. CLEAN-OUTS ARE NOT PERMITTED IN GUEST ROOMS.


- V. ALL WATER CLOSET WASTE LINES TO BE LOCATED WITHIN INTERIOR WALL CHASE.
- W. DESIGNATED ACCESSIBLE GUESTROOMS ARE IDENTIFIED BY THE INTERNATIONAL ACCESSIBILITY SYMBOL ON EACH BUILDING FLOOR PLAN.
- X. PROVIDE MAXIMUM OCCUPANT SIGN IN ALL ASSEMBLY AREAS.
- Y. PURSUANT TO SECTION 703.7 OF THE CALIFORNIA BUILDING CODE, ALL MARKING AND IDENTIFICATION OF FIRE WALLS, FIRE BARRIERS, FIRE PARTITIONS, SMOKE BARRIERS AND SMOKE PARTITIONS OR ANY OTHER WALL REQUIRED TO HAVE PROTECTED OPENINGS OR PENETRATIONS SHALL BE EFFECTIVELY AND PERMANENTLY IDENTIFIED WITH SIGNS OR STENCILING AND SHALL MEET THE THREE FOLLOWING REQUIREMENTS: 1) BE LOCATED IN ACCESSIBLE CONCEALED FLOOR, FLOOR-CEILING OR ATTIC SPACES; 2) BE LOCATED WITHIN 15 FEET (4572 mm) OF THE END OF EACH WALL AND AT INTERVALS NOT EXCEEDING 30 FEET (9144 MM) MEASURED HORIZONTALLY ALONG THE WALL OR PARTITION AND 3) INCLUDE LETTERING NOT LESS THAN 3/8 INCHES (9.5 mm) IN HEIGHT WITH A MINIMUM 3/8" (9.5 mm) STROKE IN A CONTRASTING COLOR OR INCORPORATE THE SUGGESTED WORDING "FIRE AND/OR SMOKE BARRIER-PROTECT ALL OPENINGS," OR OTHER WORDING. EXCEPTION: WALLS IN GROUP R-2 OCCUPANCIES THAT DO NOT HAVE A REMOVABLE DECORATIVE CEILING ALLOWING ACCESS TO THE CONCEALED SPACE.


- Z. FIRE EXTINGUISHER SIZES:
- 4A:90B C RATING SIZE FOR HIGH HAZARD AREAS
- 2A:90B C RATING SIZE FOR MODERATE HAZARD AREAS
- AA. INTERIOR STAIRWAY MEANS OF EGRESS DORRS SHALL BE OPENABLE FROM BOTH SIDES WITHOUT THE USE OF KEY OR SPECIAL KNOWLEDGE OR EFFORT (CBC 1008.1.5.11).

LEGEND

	DOOR TAG (SEE A8.20 FOR MORE INFORMATION)
	STOREFRONT TAG (SEE SHEETS A8.10 & A8.11 FOR MORE INFORMATION)
	ROOM NAME ROOM NUMBER
	ACCESSIBLE GUESTROOM W/ MOBILITY FEATURES - TT (TRANSFER TUB) RS (ROLL-IN SHOWER)
	GUESTROOM W/ COMMUNICATION FEATURE ASSISTED LISTENING DEVICE

LEGEND NOTES

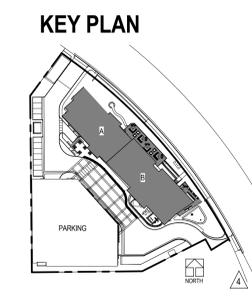

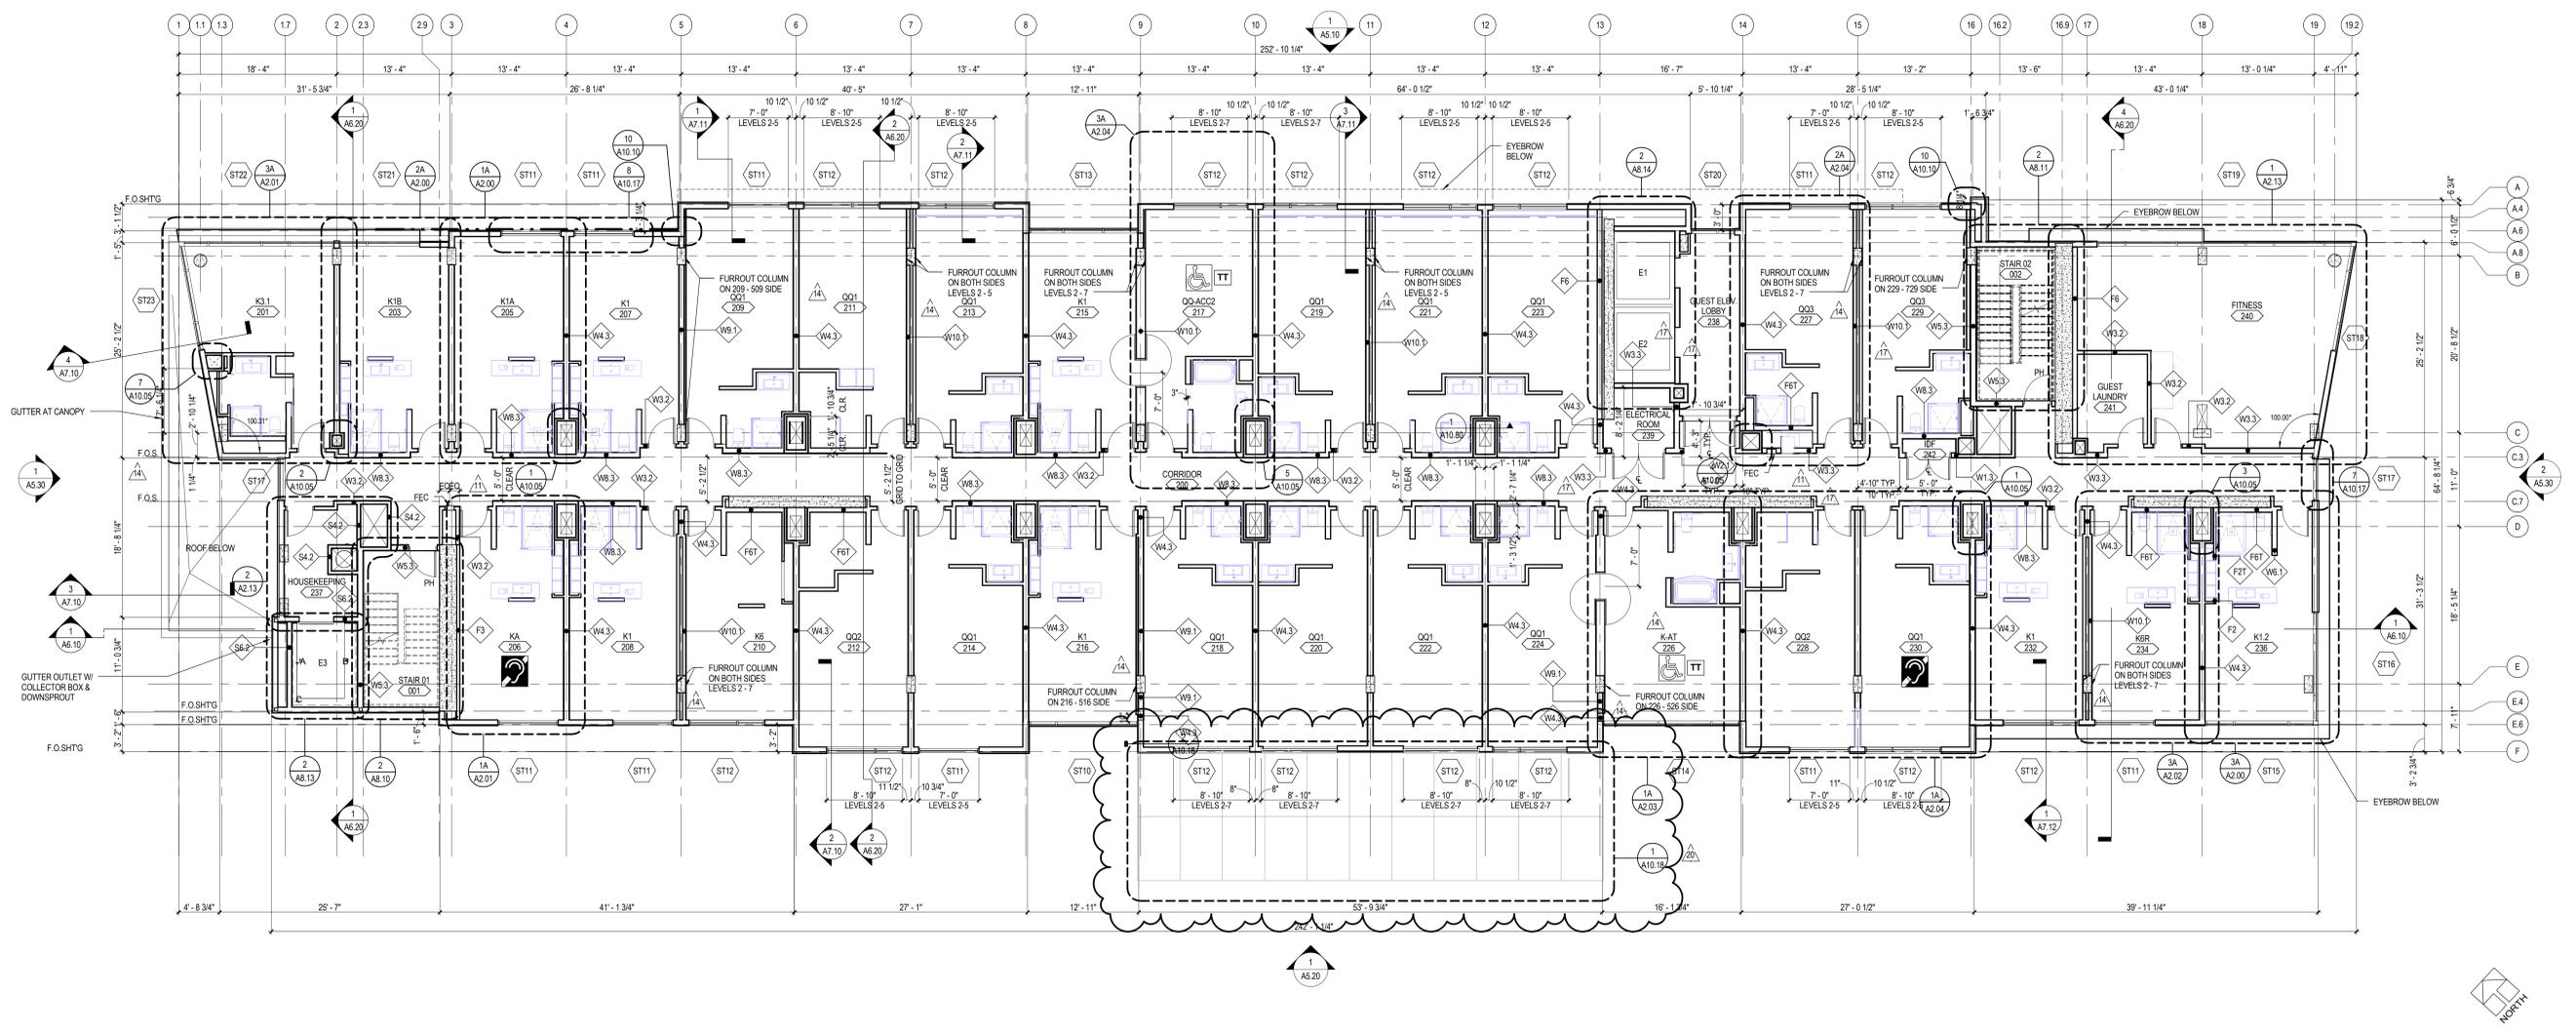

1 2ND LEVEL FLOOR PLAN
A1.20 SCALE: 1/8" = 1'-0"

OVERALL BUILDING NOTES


- A. GENERAL NOTES APPLY TO ALL SHEETS.
- B. ALL DIMENSIONS ARE TO FACE OF STUDS UNLESS OTHERWISE NOTED.
- C. G.C. TO PROVIDE 2HR FIRE RESISTANCE RATED SUPPLY BOX @ ALL SHOWER VALVE LOCATIONS.
- D. WALL TYPES SHALL BE DESIGNATED ON FLOOR PLANS. SEE SHEET A10.00 FOR PARTITION ASSEMBLIES.
- E. INTERIOR STUD WALLS SHALL EXTEND TO UNDERSIDE OF RATED FLOOR/CEILING ASSEMBLIES, OR RATED ROOF/CEILING ASSEMBLIES, UNLESS NOTED OTHERWISE. SEE REFLECTED CEILING PLAN NOTES.
- F. PROVISIONS SHALL BE MADE AT FULL HEIGHT NONBEARING WALLS FOR 1/4" VERTICAL MOVEMENT OF BUILDING STRUCTURE WITHOUT TRANSFER OF COMPRESSIVE LOADS TO WALL. FILL IRREGULARITIES BETWEEN TOP OF WALL AND DECK ABOVE WITH FIRE SAFING INSULATION OR FIRE STOPPING MATERIALS AS REQUIRED TO MEET FIRE RATINGS OF RESPECTIVE WALLS.
- G. SEE STRUCTURAL DRAWINGS FOR BRACING OF NON-LOAD BEARING METAL WALLS ON GROUND FLOOR. SEE SHEET A10.00.
- H. FURNISH AND INSTALL METAL BLOCKING IN METAL STUD PARTITIONS FOR PROPER ANCHORAGE OF WALL ATTACHED ITEMS, I.E. TOILET ACCESSORIES, TOILET PARTITIONS, CASEWORK, MILLWORK, WALL MOUNTED FIXTURES, MARKERBOARDS, TACKBOARDS, DOOR STOPS, AUDIO VISUAL BRACKETS, ETC.
- I. GYPSUM BOARD AND PLASTER SURFACES SHALL BE ISOLATED WITH CONTROL JOINTS WHERE INDICATED ON DRAWINGS AND/OR AS DESCRIBED IN THE SPECIFICATIONS.
- J. PROVIDE 5/8" TYPE-X MOISTURE RESISTANT GYP. BD. @ BATHROOM WALLS AND CEILINGS.
- K. REFER TO PROJECT MANUAL, SECTION 01 11 00, FOR ITEMS THAT ARE: 1. OWNER-FURNISHED / OWNER-INSTALLED 2. OWNER-FURNISHED / CONTRACTOR-INSTALLED
- L. REFER TO PROJECT MANUAL, SECTION 01 11 00, FOR ITEMS THAT ARE: 1. OWNER-FURNISHED / OWNER-INSTALLED 2. OWNER-FURNISHED / CONTRACTOR-INSTALLED
- M. ARCHITECTURAL GROUND FLOOR ELEVATION OF -0'-0" EQUALS FLOOR ELEVATION OF 179.00 FEET, PER CIVIL PLANS.
- N. SCRIBE GYPSUM BOARD OF WALL AND PARTITIONS TO IRREGULARITIES OF DECK ABOVE. SEAL TIGHTLY AROUND PENETRATIONS.
- O. PROVIDE SEISMIC BRACING FOR SUSPENDED CEILINGS OR AS INDICATED ON DRAWINGS.
- P. DOORS TO BE OPENABLE FROM INSIDE WITHOUT A KEY OR ANY SPECIAL KNOWLEDGE.
- Q. ANNULAR SPACES AROUND PIPES, ELECTRIC CABLES, CONDUITS OR OTHER OPENINGS IN SILL OR BOTTOM PLATES AT EXTERIOR WALLS SHALL BE PROTECTED AGAINST THE PASSAGE OF RODENTS BY CLOSING SUCH OPENINGS WITH CEMENT MORTAR, CONCRETE MASONRY, OR SIMILAR ACCEPTABLE METHODS. CGSBC SECTION 4.4.6.1.
- R. BATHROOM EXHAUST FANS MUST BE ENERGY STAR COMPLIANT. MUST BE DIRECTED TO TERMINATE OUTSIDE THE BUILDING, AND MUST BE CONTROLLED BY A HUMIDISTAT WHICH SHALL BE READILY ACCESSIBLE. CGSBC SECTION 4.5.6.
- S. FOR MILLWORK PLANS SEE INTERIOR DESIGN PLANS
- T. G.C. TO PROVIDE MINERAL FIBER FIREBLOCKING AT PENETRATIONS CONNECTING NOT MORE THAN TWO STORIES
- U. ALL FLOOR CLEAN-OUTS LOCATED IN CARPETED AREAS ARE TO BE FITTED WITH CARPET INSERTS. ALL CLEAN-OUTS TO BE FLUSH TO FLOOR/WALLS. CLEAN-OUTS ARE NOT PERMITTED IN GUEST ROOMS.
- V. ALL WATER CLOSET WASTE LINES TO BE LOCATED WITHIN INTERIOR WALL CHASE.
- W. DESIGNATED ACCESSIBLE GUESTROOMS ARE IDENTIFIED BY THE INTERNATIONAL ACCESSIBILITY SYMBOL ON EACH BUILDING FLOOR PLAN.
- X. PROVIDE MAXIMUM OCCUPANT SIGN IN ALL ASSEMBLY AREAS
- Y. PURSUANT TO SECTION 703.77 OF THE CALIFORNIA BUILDING CODE, ALL MARKING AND IDENTIFICATION OF FIRE WALLS, FIRE BARRIERS, FIRE PARTITIONS, SMOKE BARRIERS AND SMOKE PARTITIONS OR ANY OTHER WALL REQUIRED TO HAVE PROTECTED OPENINGS OR PENETRATIONS SHALL BE EFFECTIVELY AND PERMANENTLY IDENTIFIED WITH SIGNS OR STENCILING AND SHALL MEET THE THREE FOLLOWING REQUIREMENTS: 1) BE LOCATED IN ACCESSIBLE CONCEALED FLOOR, FLOOR-CEILING OR ATTIC SPACES; 2) BE LOCATED WITHIN 15 FEET (4572 mm) OF THE END OF EACH WALL AND AT INTERVALS NOT EXCEEDING 30 FEET (9144 MM) MEASURED HORIZONTALLY ALONG THE WALL OR PARTITION AND 3) INCLUDE LETTERING NOT LESS THAN 3 INCHES (76 mm) IN HEIGHT WITH A MINIMUM 3/8" (9.5 mm) STROKE IN A CONTRASTING COLOR OR INCORPORATE THE SUGGESTED WORKING "FIRE AND/OR SMOKE BARRIER-PROTECT ALL OPENINGS," OR OTHER WORKING. EXCEPTION: WALLS IN GROUP R-2 OCCUPANCIES THAT DO NOT HAVE A REMOVABLE DECORATIVE CEILING ALLOWING ACCESS TO THE CONCEALED SPACE.
- Z. FIRE EXTINGUISHER SIZES:
- 4A:80B C RATING SIZE FOR HIGH HAZARD AREAS
- 2A:90B C RATING SIZE FOR MODERATE HAZARD AREAS
AA. INTERIOR STAIRWAY MEANS OF EGRESS DORRS SHALL BE OPENABLE FROM BOTH SIDES WITHOUT THE USE OF KEY OR SPECIAL KNOWLEDGE OR EFFORT (CBC 1008.1.5.11).

LEGEND

- DOOR TAG (SEE A9.20 FOR MORE INFORMATION)
- STOREFRONT TAG (SEE SHEETS A8.10 & A9.11 FOR MORE INFORMATION)
- ROOM NAME
ROOM NUMBER
- ACCESSIBLE GUESTROOM W/ MOBILITY FEATURES - TT (TRANSFER TUB) RS (ROLL-IN SHOWER)
- GUESTROOM W/ COMMUNICATION FEATURE ASSISTED LISTENING DEVICE


LEGEND NOTES

KEY PLAN

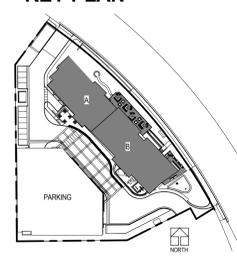

DLR Group
Architecture Engineering Planning Interiors
© 2016, DLR Group, Inc., a California corporation. ALL RIGHTS RESERVED.

- 75-15746-00
07/26/2017
Revisions
- 11 HOTEL ONLY RESUBMITTAL 11/30/2017
- 12 HOTEL ONLY RESUBMITTAL 01/23/2018
- 13 HOTEL ONLY RESUBMITTAL 02/28/2018
- 14 BULLETIN #1: DOOR AND INTERIOR REVISIONS 04/23/2018
- 17 BULLETIN #5 LEVEL 1 REVISIONS & DOOR HARDWARE 08/10/2018
- 20 BULLETIN #7: SITE LIGHTING/GROUND FLOOR FOR FITNESS ROOM HYDRATION STATION ON LEVELS 2-7

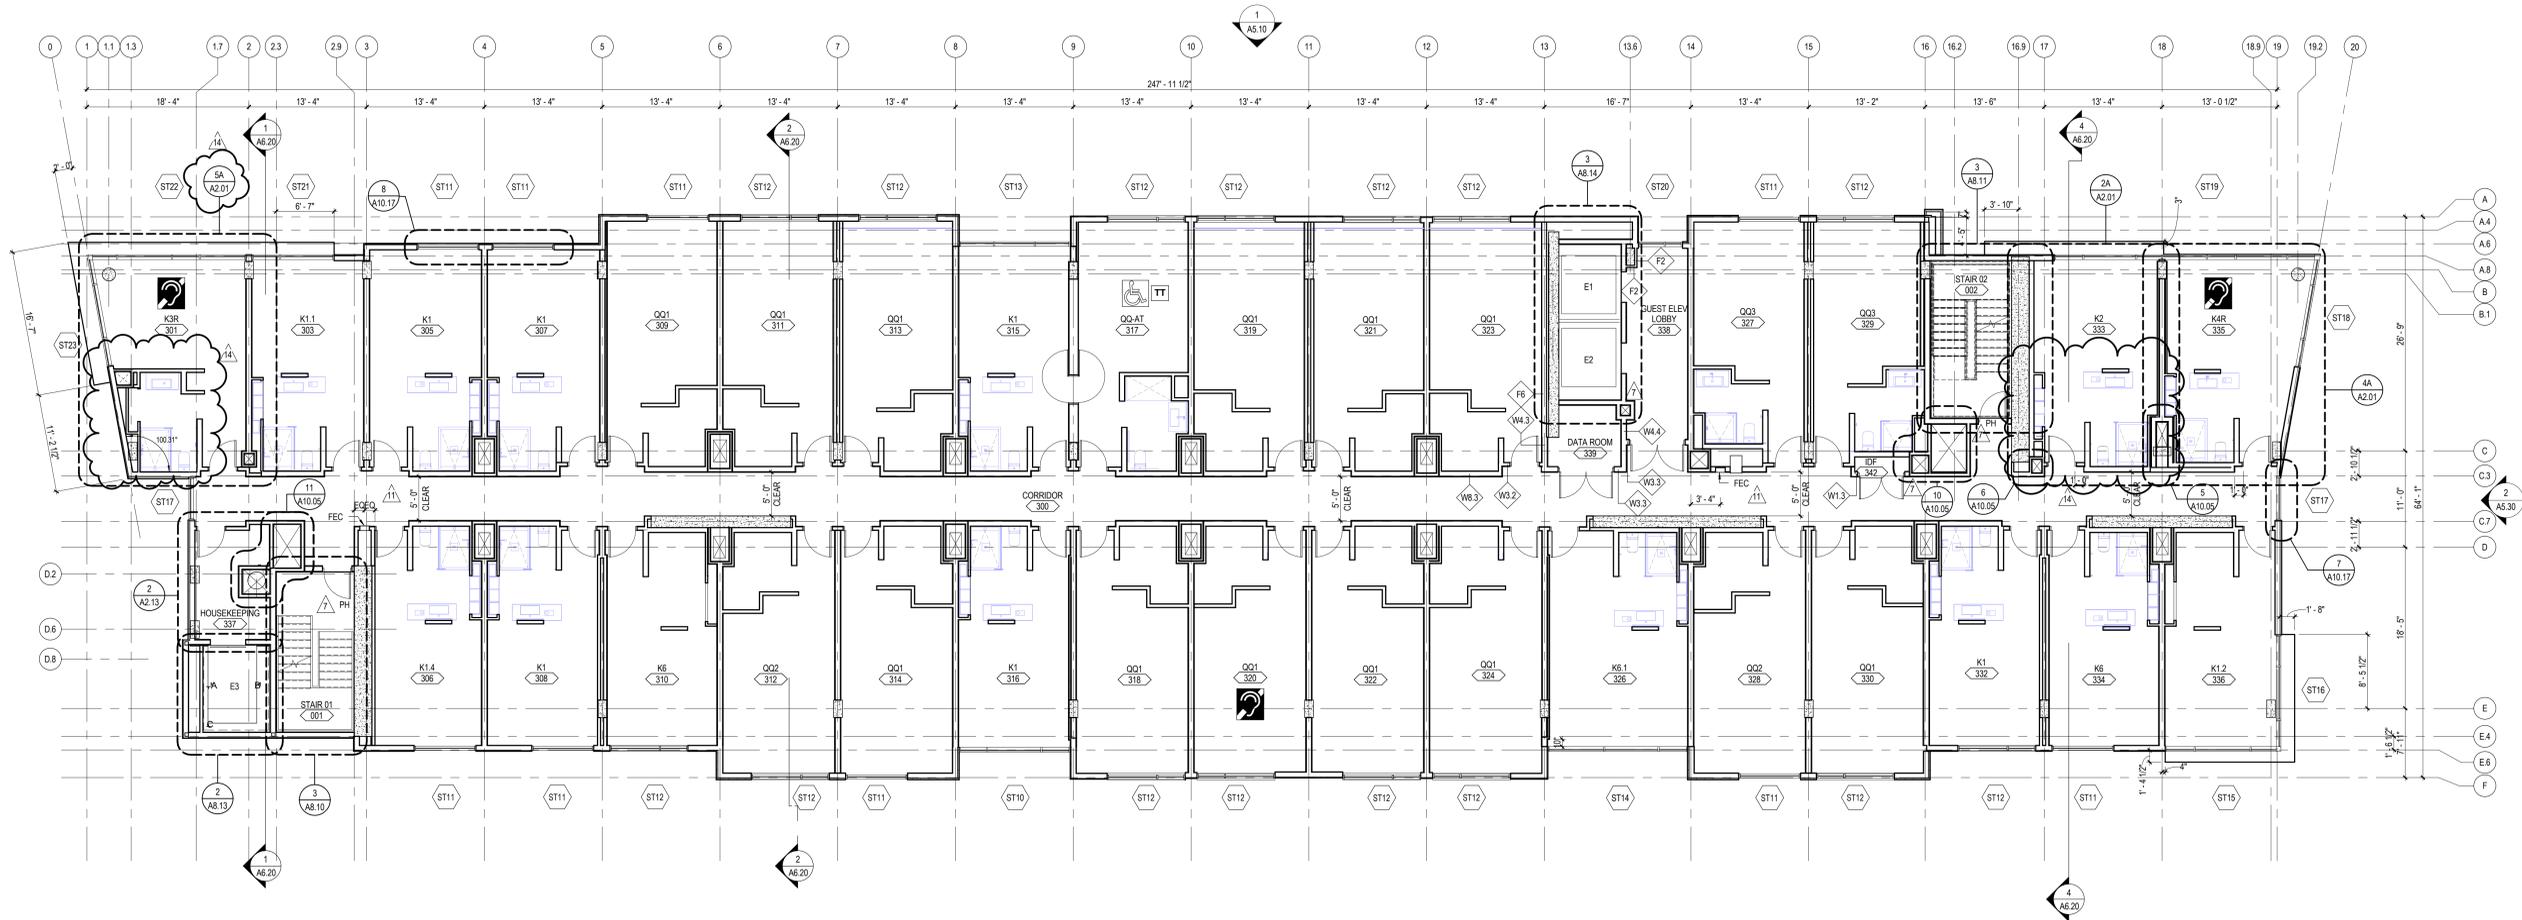

1 3RD LEVEL FLOOR PLAN
A1.30 SCALE: 1/8" = 1'-0"

REFER TO SHEET A1.20 2ND LEVEL FLOORPLAN FOR
ADDITIONAL SIMILAR BUILDING EXTERIOR DIMENSIONS

OVERALL BUILDING NOTES

- A. GENERAL NOTES APPLY TO ALL SHEETS.
- B. ALL DIMENSIONS ARE TO FACE OF STUDS UNLESS OTHERWISE NOTED.
- C. G. C. TO PROVIDE 2 HR FIRE RESISTANCE RATED SUPPLY BOX @ ALL SHOWER VALVE LOCATIONS.
- D. WALL TYPES SHALL BE DESIGNATED ON FLOOR PLANS. SEE SHEET A10.00 FOR PARTITION ASSEMBLIES.
- E. INTERIOR STUD WALLS SHALL EXTEND TO UNDERSIDE OF RATED FLOOR/CEILING ASSEMBLIES, OR RATED ROOF/CEILING ASSEMBLIES, UNLESS NOTED OTHERWISE. SEE REFLECTED CEILING PLAN NOTES.
- F. PROVISIONS SHALL BE MADE AT FULL HEIGHT NONBEARING WALLS FOR 1/4" VERTICAL MOVEMENT OF BUILDING STRUCTURE WITHOUT TRANSFER OF COMPRESSIVE LOADS TO WALL. FILL IRREGULARITIES BETWEEN TOP OF WALL AND DECK ABOVE WITH FIRE SAFING INSULATION OR FIRE STOPPING MATERIALS AS REQUIRED TO MEET FIRE RATINGS OF RESPECTIVE WALLS.
- G. SEE STRUCTURAL DRAWINGS FOR BRACING OF NON-LOAD BEARING METAL WALLS ON GROUND FLOOR. SEE SHEET A10.00.
- H. FURNISH AND INSTALL METAL BLOCKING IN METAL STUD PARTITIONS FOR PROPER ANCHORAGE OF WALL ATTACHED ITEMS, I.E. TOILET ACCESSORIES, TOILET PARTITIONS, CASEWORK, MILLWORK, WALL MOUNTED FIXTURES, MARKERBOARDS, TACKBOARDS, DOOR STOPS, AUDIO VISUAL BRACKETS, ETC.
- I. GYPSUM BOARD AND PLASTER SURFACES SHALL BE ISOLATED WITH CONTROL JOINTS WHERE INDICATED ON DRAWINGS AND/OR AS DESCRIBED IN THE SPECIFICATIONS.
- J. PROVIDE 5/8" TYPE-X MOISTURE RESISTANT GYP. BD. @ BATHROOM WALLS AND CEILINGS.
- K. REFER TO PROJECT MANUAL, SECTION 01 11 00, FOR ITEMS THAT ARE:
1. OWNER-FURNISHED / OWNER-INSTALLED
2. OWNER-FURNISHED / CONTRACTOR-INSTALLED
- L. REFER TO PROJECT MANUAL, SECTION 01 11 00, FOR ITEMS THAT ARE:
1. OWNER-FURNISHED / OWNER-INSTALLED
2. OWNER-FURNISHED / CONTRACTOR-INSTALLED
- M. ARCHITECTURAL GROUND FLOOR ELEVATION OF -0'-0" EQUALS FLOOR ELEVATION OF -179.00' FEET, PER CIVIL PLANS.
- N. SCRIBE GYPSUM BOARD OF WALL AND PARTITIONS TO IRREGULARITIES OF DECK ABOVE. SEAL TIGHTLY AROUND PENETRATIONS.

- O. PROVIDE SEISMIC BRACING FOR SUSPENDED CEILINGS OR AS INDICATED ON DRAWINGS.
- P. DOORS TO BE OPENABLE FROM INSIDE WITHOUT A KEY OR ANY SPECIAL KNOWLEDGE.
- Q. ANNULAR SPACES AROUND PIPES, ELECTRIC CABLES, CONDUITS OR OTHER OPENINGS IN SILL OR BOTTOM PLATES AT EXTERIOR WALLS SHALL BE PROTECTED AGAINST THE PASSAGE OF RODENTS BY CLOSING SUCH OPENINGS WITH CEMENT MORTAR, CONCRETE MASONRY, OR SIMILAR ACCEPTABLE METHODS. CGSBC SECTION 4.4.6.1.1
- R. BATHROOM EXHAUST FANS MUST BE ENERGY STAR COMPLIANT. MUST BE DUCTED TO TERMINATE OUTSIDE THE BUILDING, AND MUST BE CONTROLLED BY A HUMIDISTAT WHICH SHALL BE READILY ACCESSIBLE. CGSBC SECTION 4.5.6
- S. FOR MILLWORK PLANS SEE INTERIOR DESIGN PLANS
- T. G. C. TO PROVIDE MINERAL FIBER FIREBLOCKING AT PENETRATIONS CONNECTING NOT MORE THAN TWO STORIES
- U. ALL FLOOR CLEAN-OUTS LOCATED IN CARPETED AREAS ARE TO BE FITTED WITH CARPET INSERTS. ALL CLEAN-OUTS TO BE FLUSH TO FLOOR/WALLS. CLEAN-OUTS ARE NOT PERMITTED IN GUEST ROOMS

- V. ALL WATER CLOSET WASTE LINES TO BE LOCATED WITHIN INTERIOR WALL CHASE
- W. DESIGNATED ACCESSIBLE GUESTROOMS ARE IDENTIFIED BY THE INTERNATIONAL ACCESSIBILITY SYMBOL ON EACH BUILDING FLOOR PLAN
- X. PROVIDE MAXIMUM OCCUPANT SIGN IN ALL ASSEMBLY AREAS
- Y. PURSUANT TO SECTION 703.7 OF THE CALIFORNIA BUILDING CODE, ALL MARKING AND IDENTIFICATION OF FIRE WALLS, FIRE BARRIERS, FIRE PARTITIONS, SMOKE BARRIERS AND SMOKE PARTITIONS OR ANY OTHER WALL REQUIRED TO HAVE PROTECTED OPENINGS OR PENETRATIONS SHALL BE EFFECTIVELY AND PERMANENTLY IDENTIFIED WITH SIGNS OR STENCILING AND SHALL MEET THE THREE FOLLOWING REQUIREMENTS:
1) BE LOCATED IN ACCESSIBLE CONCEALED FLOOR, FLOOR-CEILING OR ATTIC SPACES;
2) BE LOCATED WITHIN 15 FEET (4572 mm) OF THE END OF EACH WALL AND AT INTERVALS NOT EXCEEDING 30 FEET (9144 mm) MEASURED HORIZONTALLY ALONG THE WALL OR PARTITION AND;
3) INCLUDE LETTERING NOT LESS THAN 3 INCHES (76 mm) IN HEIGHT WITH A MINIMUM 3/8" (9.5 mm) STROKE IN A CONTRASTING COLOR OR INCORPORATE THE SUGGESTED WORDING "FIRE AND/OR SMOKE BARRIER-PROTECT ALL OPENINGS," OR OTHER WORDING.
EXCEPTION: WALLS IN GROUP R-2 OCCUPANCIES THAT DO NOT HAVE A REMOVABLE DECORATIVE CEILING ALLOWING ACCESS TO THE CONCEALED SPACE.


- Z. FIRE EXTINGUISHER SIZES:
- 4A:80B-C RATING SIZE FOR HIGH HAZARD AREAS
- 2A:80B-C RATING SIZE FOR MODERATE HAZARD AREAS
- AA. INTERIOR STAIRWAY MEANS OF EGRESS DORRS SHALL BE OPENABLE FROM BOTH SIDES WITHOUT THE USE OF KEY OR SPECIAL KNOWLEDGE OR EFFORT (CBC 1008.1.9.11).

LEGEND

	DOOR TAG (SEE A9.20 FOR MORE INFORMATION)
	STOREFRONT TAG (SEE SHEETS A8.10 & A9.11 FOR MORE INFORMATION)
	ROOM NAME ROOM NUMBER
	ACCESSIBLE GUESTROOM W/ MOBILITY FEATURES - TT (TRANSFER TUB) RS (ROLL-IN SHOWER)
	GUESTROOM W/ COMMUNICATION FEATURE ASSISTED LISTENING DEVICE


LEGEND NOTES

1. LEGEND NOTES ARE COMMON TO ALL SHEETS. SOME NOTES MAY NOT APPLY TO THIS SHEET.
2. SEE DWG. A2.00 SERIES FOR GUESTROOM CEILING

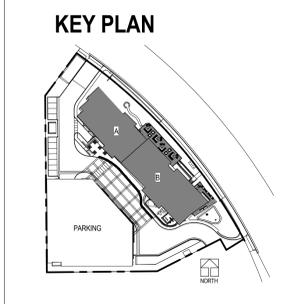



75-15746-00	07/26/2017	Revisions
7	HOTEL ONLY SUBMITTAL	07/26/2017
11	HOTEL ONLY RESUBMITTAL - POST CORRECTIONS	11/30/2017
12	HOTEL ONLY RESUBMITTAL - POST CORRECTIONS	01/23/2018
14	BULLETIN #2 - DOORS AND INTERIOR REVISIONS	03/29/2018

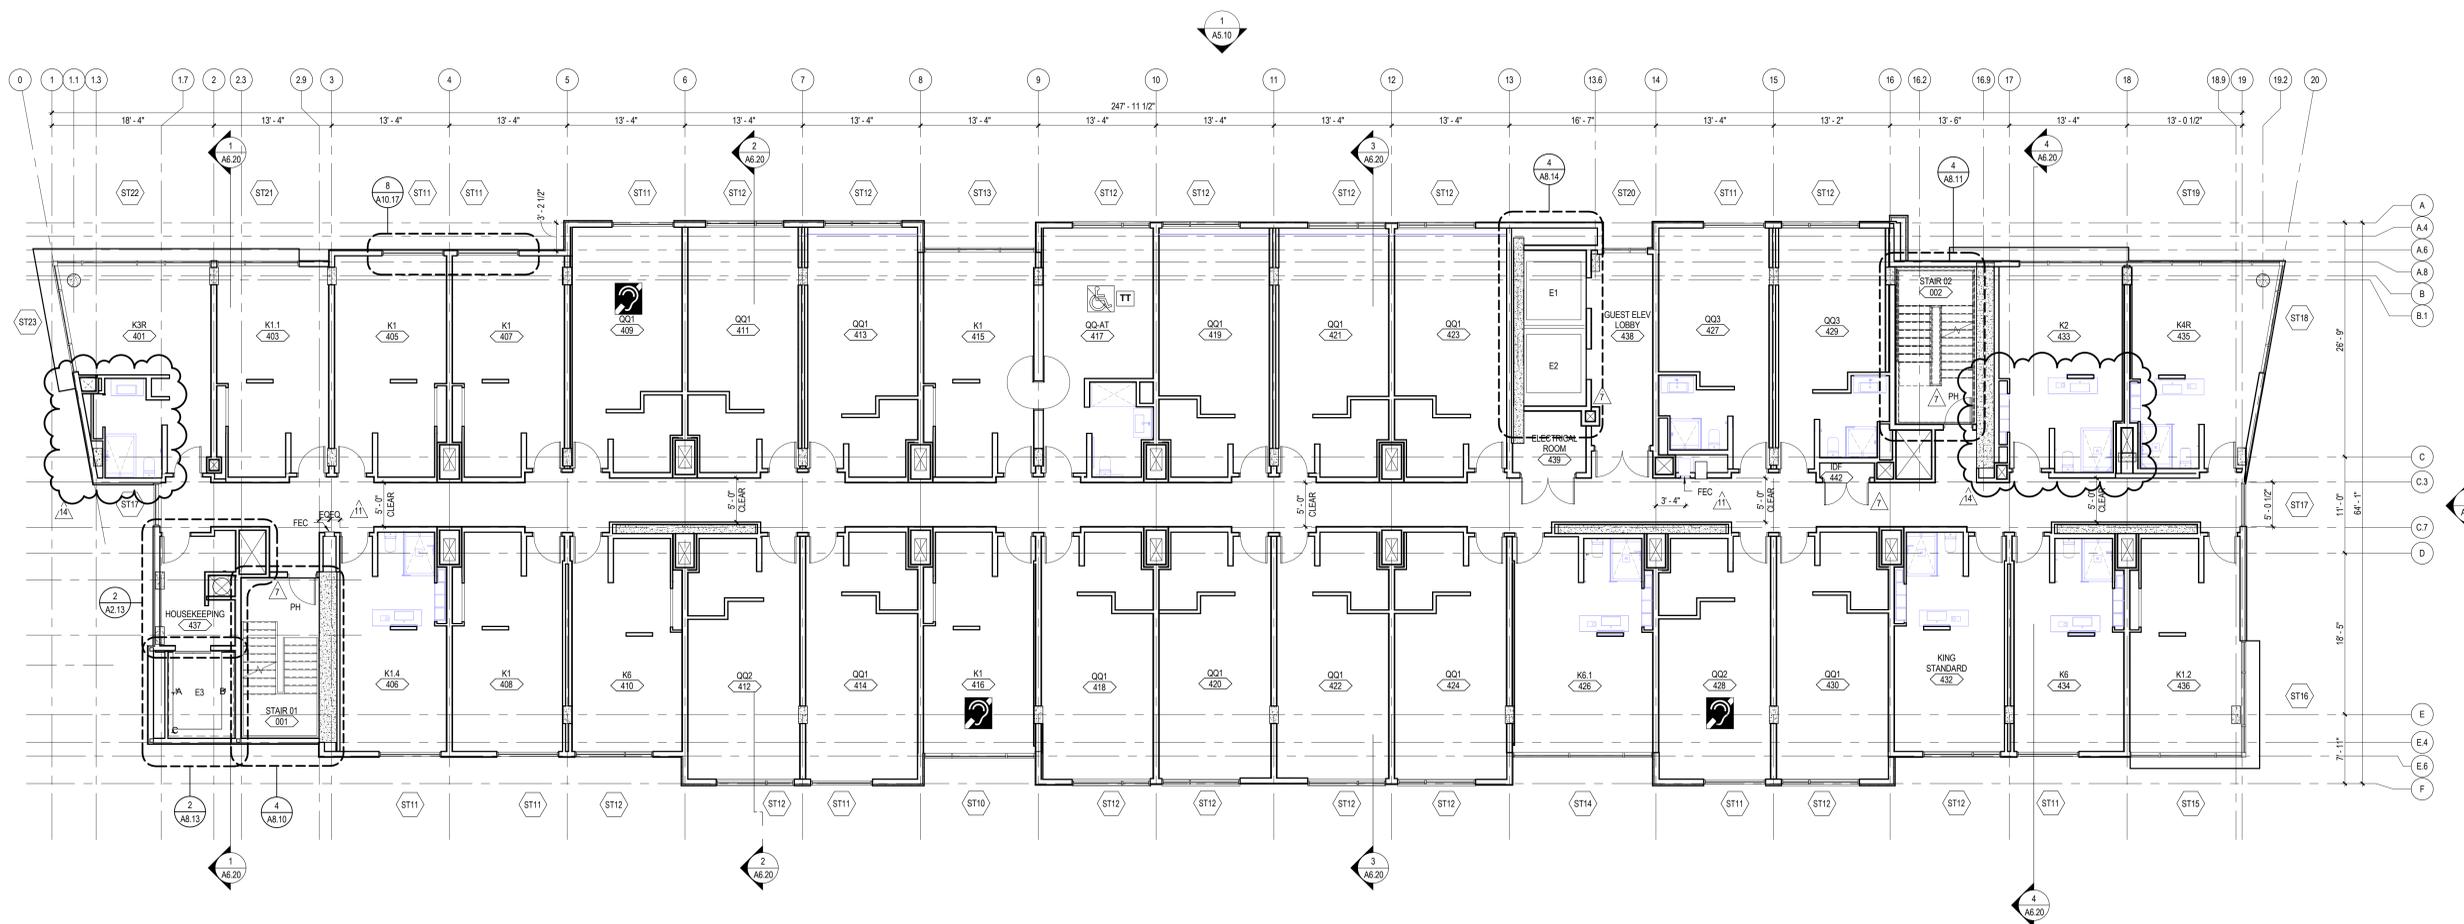

1 4TH LEVEL FLOOR PLAN
A1.40 SCALE: 1/8" = 1'-0"

REFER TO SHEET A1.20 2ND LEVEL FLOORPLAN FOR ADDITIONAL SIMILAR BUILDING EXTERIOR DIMENSIONS

OVERALL BUILDING NOTES

- A. GENERAL NOTES APPLY TO ALL SHEETS.
- B. ALL DIMENSIONS ARE TO FACE OF STUDS UNLESS OTHERWISE NOTED.
- C. G. C. TO PROVIDE 2 HR FIRE RESISTANCE RATED SUPPLY BOX @ ALL SHOWER VALVE LOCATIONS.
- D. WALL TYPES SHALL BE DESIGNATED ON FLOOR PLANS. SEE SHEET A10.00 FOR PARTITION ASSEMBLIES.
- E. INTERIOR STUD WALLS SHALL EXTEND TO UNDERSIDE OF RATED FLOOR/CEILING ASSEMBLIES, OR RATED ROOF/CEILING ASSEMBLIES, UNLESS NOTED OTHERWISE. SEE REFLECTED CEILING PLAN NOTES.
- F. PROVISIONS SHALL BE MADE AT FULL HEIGHT NONBEARING WALLS FOR 1-INCH VERTICAL MOVEMENT OF BUILDING STRUCTURE WITHOUT TRANSFER OF COMPRESSIVE LOADS TO WALL. FILL IRREGULARITIES BETWEEN TOP OF WALL AND DECK ABOVE WITH FIRE SAFING INSULATION OR FIRE STOPPING MATERIALS AS REQUIRED TO MEET FIRE RATINGS OF RESPECTIVE WALLS.
- G. SEE STRUCTURAL DRAWINGS FOR BRACING OF NON-LOAD BEARING METAL WALLS ON GROUND FLOOR. SEE SHEET A10.00.
- H. FURNISH AND INSTALL METAL BLOCKING IN METAL STUD PARTITIONS FOR PROPER ANCHORAGE OF WALL ATTACHED ITEMS, I.E. TOILET ACCESSORIES, TOILET PARTITIONS, CASEWORK, MILLWORK, WALL MOUNTED FIXTURES, MARKERBOARDS, TACKBOARDS, DOOR STOPS, AUDIO VISUAL BRACKETS, ETC.
- I. GYPSUM BOARD AND PLASTER SURFACES SHALL BE ISOLATED WITH CONTROL JOINTS WHERE INDICATED ON DRAWINGS AND/OR AS DESCRIBED IN THE SPECIFICATIONS.
- J. PROVIDE 5/8" TYPE-X MOISTURE RESISTANT GYP. BD. @ BATHROOM WALLS AND CEILINGS.
- K. REFER TO PROJECT MANUAL, SECTION 01 11 00, FOR ITEMS THAT ARE: 1. OWNER-FURNISHED / OWNER-INSTALLED 2. OWNER-FURNISHED / CONTRACTOR-INSTALLED
- L. REFER TO PROJECT MANUAL, SECTION 01 11 00, FOR ITEMS THAT ARE: 1. OWNER-FURNISHED / OWNER-INSTALLED 2. OWNER-FURNISHED / CONTRACTOR-INSTALLED
- M. ARCHITECTURAL GROUND FLOOR ELEVATION OF -0'-0" EQUALS FLOOR ELEVATION OF -179.00' FEET, PER CIVIL PLANS.
- N. SCRIBE GYPSUM BOARD OF WALL AND PARTITIONS TO IRREGULARITIES OF DECK ABOVE. SEAL TIGHTLY AROUND PENETRATIONS.

- O. PROVIDE SEISMIC BRACING FOR SUSPENDED CEILINGS OR AS INDICATED ON DRAWINGS.
- P. DOORS TO BE OPENABLE FROM INSIDE WITHOUT A KEY OR ANY SPECIAL KNOWLEDGE.
- Q. ANNULAR SPACES AROUND PIPES, ELECTRIC CABLES, CONDUITS OR OTHER OPENINGS IN SILL OR BOTTOM PLATES AT EXTERIOR WALLS SHALL BE PROTECTED AGAINST THE PASSAGE OF RODENTS BY CLOSING SUCH OPENINGS WITH CEMENT MORTAR, CONCRETE MASONRY, OR SIMILAR ACCEPTABLE METHODS. CGSBC SECTION 4.4.6.1.
- R. BATHROOM EXHAUST FANS MUST BE ENERGY STAR COMPLIANT. MUST BE DUCTED TO TERMINATE OUTSIDE THE BUILDING, AND MUST BE CONTROLLED BY A HUMIDISTAT WHICH SHALL BE READILY ACCESSIBLE. CGSBC SECTION 4.5.6.
- S. FOR MILLWORK PLANS SEE INTERIOR DESIGN PLANS
- T. G. C. TO PROVIDE MINERAL FIBER FIREBLOCKING AT PENETRATIONS CONNECTING NOT MORE THAN TWO STORIES
- U. ALL FLOOR CLEAN-OUTS LOCATED IN CARPETED AREAS ARE TO BE FITTED WITH CARPET INSERTS. ALL CLEAN-OUTS TO BE FLUSH TO FLOOR/WALLS. CLEAN-OUTS ARE NOT PERMITTED IN GUEST ROOMS

- V. ALL WATER CLOSET WASTE LINES TO BE LOCATED WITHIN INTERIOR WALL CHASE
- W. DESIGNATED ACCESSIBLE GUESTROOMS ARE IDENTIFIED BY THE INTERNATIONAL ACCESSIBILITY SYMBOL ON EACH BUILDING FLOOR PLAN.
- X. PROVIDE MAXIMUM OCCUPANT SIGN IN ALL ASSEMBLY AREAS
- Y. PURSUANT TO SECTION 703.7 OF THE CALIFORNIA BUILDING CODE, ALL MARKING AND IDENTIFICATION OF FIRE WALLS, FIRE BARRIERS, FIRE PARTITIONS, SMOKE BARRIERS AND SMOKE PARTITIONS OR ANY OTHER WALL REQUIRED TO HAVE PROTECTED OPENINGS OR PENETRATIONS SHALL BE EFFECTIVELY AND PERMANENTLY IDENTIFIED WITH SIGNS OR STENCILING AND SHALL MEET THE THREE FOLLOWING REQUIREMENTS: 1) BE LOCATED IN ACCESSIBLE CONCEALED FLOOR, FLOOR-CEILING OR ATTIC SPACES; 2) BE LOCATED WITHIN 15 FEET (4572 mm) OF THE END OF EACH WALL AND AT INTERVALS NOT EXCEEDING 30 FEET (9144 MM) MEASURED HORIZONTALLY ALONG THE WALL OR PARTITION AND 3) INCLUDE LETTERING NOT LESS THAN 3 INCHES (76 mm) IN HEIGHT WITH A MINIMUM 3/8" (9.5 mm) STROKE IN A CONTRASTING COLOR OR INCORPORATE THE SUGGESTED WORDING "FIRE AND/OR SMOKE BARRIER-PROTECT ALL OPENINGS," OR OTHER WORDING. EXCEPTION: WALLS IN GROUP R-2 OCCUPANCIES THAT DO NOT HAVE A REMOVABLE DECORATIVE CEILING ALLOWING ACCESS TO THE CONCEALED SPACE.

- Z. FIRE EXTINGUISHER SIZES:
- 4A:80B:C RATING SIZE FOR HIGH HAZARD AREAS
- 2A:80B:C RATING SIZE FOR MODERATE HAZARD AREAS
- AA. INTERIOR STAIRWAY MEANS OF EGRESS DORRS SHALL BE OPENABLE FROM BOTH SIDES WITHOUT THE USE OF KEY OR SPECIAL KNOWLEDGE OR EFFORT (CBC 1008.1.9.11).


LEGEND

- DOOR TAG (SEE A9.20 FOR MORE INFORMATION)
- STOREFRONT TAG (SEE SHEETS A8.10 & A9.11 FOR MORE INFORMATION)
- ROOM NAME
ROOM NUMBER
- ACCESSIBLE GUESTROOM W/ MOBILITY FEATURES - TT (TRANSFER TUB) RS (ROLL-IN SHOWER)
- GUESTROOM W/ COMMUNICATION FEATURE ASSISTED LISTENING DEVICE

LEGEND NOTES

- 1. LEGEND NOTES ARE COMMON TO ALL SOME NOTES MAY NOT APPLY TO THIS SHEET
- 2. SEE DWG. A2.00 SERIES FOR GUESTROOM CEILING

KEY PLAN

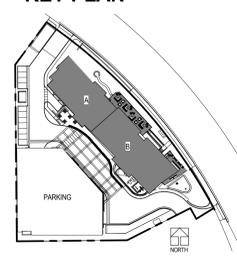



1 5TH LEVEL FLOOR PLAN
SCALE: 1/8" = 1'-0"

REFER TO SHEET A1.20 2ND LEVEL FLOORPLAN FOR
ADDITIONAL SIMILAR BUILDING EXTERIOR DIMENSIONS

OVERALL BUILDING NOTES

A. GENERAL NOTES APPLY TO ALL SHEETS.
B. ALL DIMENSIONS ARE TO FACE OF STUDS UNLESS OTHERWISE NOTED.
C. G. C. TO PROVIDE 2 HR FIRE RESISTANCE RATED SUPPLY BOX @ ALL SHOWER VALVE LOCATIONS.
D. WALL TYPES SHALL BE DESIGNATED ON FLOOR PLANS. SEE SHEET A10.00 FOR PARTITION ASSEMBLIES.
E. INTERIOR STUD WALLS SHALL EXTEND TO UNDERSIDE OF RATED FLOOR/CEILING ASSEMBLIES, OR RATED ROOF/CEILING ASSEMBLIES, UNLESS NOTED OTHERWISE. SEE REFLECTED CEILING PLAN NOTES.
F. PROVISIONS SHALL BE MADE AT FULL HEIGHT NONBEARING WALLS FOR 1/4" VERTICAL MOVEMENT OF BUILDING STRUCTURE WITHOUT TRANSFER OF COMPRESSIVE LOADS TO WALL. FILL IRREGULARITIES BETWEEN TOP OF WALL AND DECK ABOVE WITH FIRE SAFING INSULATION OR FIRE STOPPING MATERIALS AS REQUIRED TO MEET FIRE RATINGS OF RESPECTIVE WALLS.
G. SEE STRUCTURAL DRAWINGS FOR BRACING OF NON-LOAD BEARING METAL WALLS ON GROUND FLOOR. SEE SHEET A10.00.
H. FURNISH AND INSTALL METAL BLOCKING IN METAL STUD PARTITIONS FOR PROPER ANCHORAGE OF WALL ATTACHED ITEMS, I.E. TOILET ACCESSORIES, TOILET PARTITIONS, CASEWORK, MILLWORK, WALL-MOUNTED FIXTURES, MARKERBOARDS, TACKBOARDS, DOOR STOPS, AUDIO VISUAL BRACKETS, ETC.
I. GYPSUM BOARD AND PLASTER SURFACES SHALL BE ISOLATED WITH CONTROL JOINTS WHERE INDICATED ON DRAWINGS AND/OR AS DESCRIBED IN THE SPECIFICATIONS.
J. PROVIDE 5/8" TYPE-X MOISTURE RESISTANT GYP. BD. @ BATHROOM WALLS AND CEILINGS.
K. REFER TO PROJECT MANUAL, SECTION 01 11 00, FOR ITEMS THAT ARE:
1. OWNER-FURNISHED / OWNER-INSTALLED
2. OWNER-FURNISHED / CONTRACTOR-INSTALLED
L. REFER TO PROJECT MANUAL, SECTION 01 11 00, FOR ITEMS THAT ARE:
1. OWNER-FURNISHED / OWNER-INSTALLED
2. OWNER-FURNISHED / CONTRACTOR-INSTALLED
M. ARCHITECTURAL GROUND FLOOR ELEVATION OF -0'-0" EQUALS FLOOR ELEVATION OF -179.00' FEET, PER CIVIL PLANS.
N. SCRIBE GYPSUM BOARD OF WALL AND PARTITIONS TO IRREGULARITIES OF DECK ABOVE. SEAL TIGHTLY AROUND PENETRATIONS.

O. PROVIDE SEISMIC BRACING FOR SUSPENDED CEILINGS OR AS INDICATED ON DRAWINGS.
P. DOORS TO BE OPENABLE FROM INSIDE WITHOUT A KEY OR ANY SPECIAL KNOWLEDGE.
Q. ANNULAR SPACES AROUND PIPES, ELECTRIC CABLES, CONDUITS OR OTHER OPENINGS IN SILL OR BOTTOM PLATES AT EXTERIOR WALLS SHALL BE PROTECTED AGAINST THE PASSAGE OF RODENTS BY CLOSING SUCH OPENINGS WITH CEMENT MORTAR, CONCRETE MASONRY, OR SIMILAR ACCEPTABLE METHODS. CGSC SECTION 4.408.1.
R. BATHROOM EXHAUST FANS MUST BE ENERGY STAR COMPLIANT. MUST BE DUCTED TO TERMINATE OUTSIDE THE BUILDING, AND MUST BE CONTROLLED BY A HUMIDISTAT WHICH SHALL BE READILY ACCESSIBLE. CGSC SECTION 4.508.
S. FOR MILLWORK PLANS SEE INTERIOR DESIGN PLANS
T. G. C. TO PROVIDE MINERAL FIBER FIREBLOCKING AT PENETRATIONS CONNECTING NOT MORE THAN TWO STORIES
U. ALL FLOOR CLEAN-OUTS LOCATED IN CARPETED AREAS ARE TO BE FITTED WITH CARPET INSERTS. ALL CLEAN-OUTS TO BE FLUSH TO FLOOR/WALLS. CLEAN-OUTS ARE NOT PERMITTED IN GUEST ROOMS

V. ALL WATER CLOSET WASTE LINES TO BE LOCATED WITHIN INTERIOR WALL CHASE
W. DESIGNATED ACCESSIBLE GUESTROOMS ARE IDENTIFIED BY THE INTERNATIONAL ACCESSIBILITY SYMBOL ON EACH BUILDING FLOOR PLAN.
X. PROVIDE MAXIMUM OCCUPANT SIGN IN ALL ASSEMBLY AREAS
Y. PURSUANT TO SECTION 703.7 OF THE CALIFORNIA BUILDING CODE, ALL MARKING AND IDENTIFICATION OF FIRE WALLS, FIRE BARRIERS, FIRE PARTITIONS, SMOKE BARRIERS AND SMOKE PARTITIONS OR ANY OTHER WALL REQUIRED TO HAVE PROTECTED OPENINGS OR PENETRATIONS SHALL BE EFFECTIVELY AND PERMANENTLY IDENTIFIED WITH SIGNS OR STENCILING AND SHALL MEET THE THREE FOLLOWING REQUIREMENTS:
1) BE LOCATED IN ACCESSIBLE CONCEALED FLOOR, FLOOR-CEILING OR ATTIC SPACES;
2) BE LOCATED WITHIN 15 FEET (4572 mm) OF THE END OF EACH WALL AND AT INTERVALS NOT EXCEEDING 30 FEET (9144 mm) MEASURED HORIZONTALLY ALONG THE WALL OR PARTITION AND;
3) INCLUDE LETTERING NOT LESS THAN 3 INCHES (76 mm) IN HEIGHT WITH A MINIMUM 3/8" (9.5 mm) STROKE IN A CONTRASTING COLOR OR INCORPORATE THE SUGGESTED WORDING "FIRE AND/OR SMOKE BARRIER-PROTECT ALL OPENINGS," OR OTHER WORDING.
EXCEPTION: WALLS IN GROUP R-2 OCCUPANCIES THAT DO NOT HAVE A REMOVABLE DECORATIVE CEILING ALLOWING ACCESS TO THE CONCEALED SPACE.

Z. FIRE EXTINGUISHER SIZES:
- 4A:80B-C RATING SIZE FOR HIGH HAZARD AREAS
- 2A:80B-C RATING SIZE FOR MODERATE HAZARD AREAS
AA. INTERIOR STAIRWAY MEANS OF EGRESS DORRS SHALL BE OPENABLE FROM BOTH SIDES WITHOUT THE USE OF KEY OR SPECIAL KNOWLEDGE OR EFFORT (CBC 1008.1.9.11).


LEGEND


	DOOR TAG (SEE A9.20 FOR MORE INFORMATION)
	STOREFRONT TAG (SEE SHEETS A9.10 & A9.11 FOR MORE INFORMATION)
	ROOM NAME ROOM NUMBER
	ACCESSIBLE GUESTROOM W/ MOBILITY FEATURES - TT (TRANSFER TUB) RS (ROLL-IN SHOWER)
	GUESTROOM W/ COMMUNICATION FEATURE ASSISTED LISTENING DEVICE

LEGEND NOTES

1. LEGEND NOTES ARE COMMON TO ALL SHEETS. SOME NOTES MAY NOT APPLY TO THIS SHEET.
2. SEE DWG. A2.00 SERIES FOR GUESTROOM CEILING

KEY PLAN

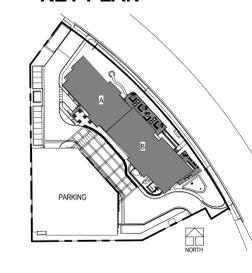

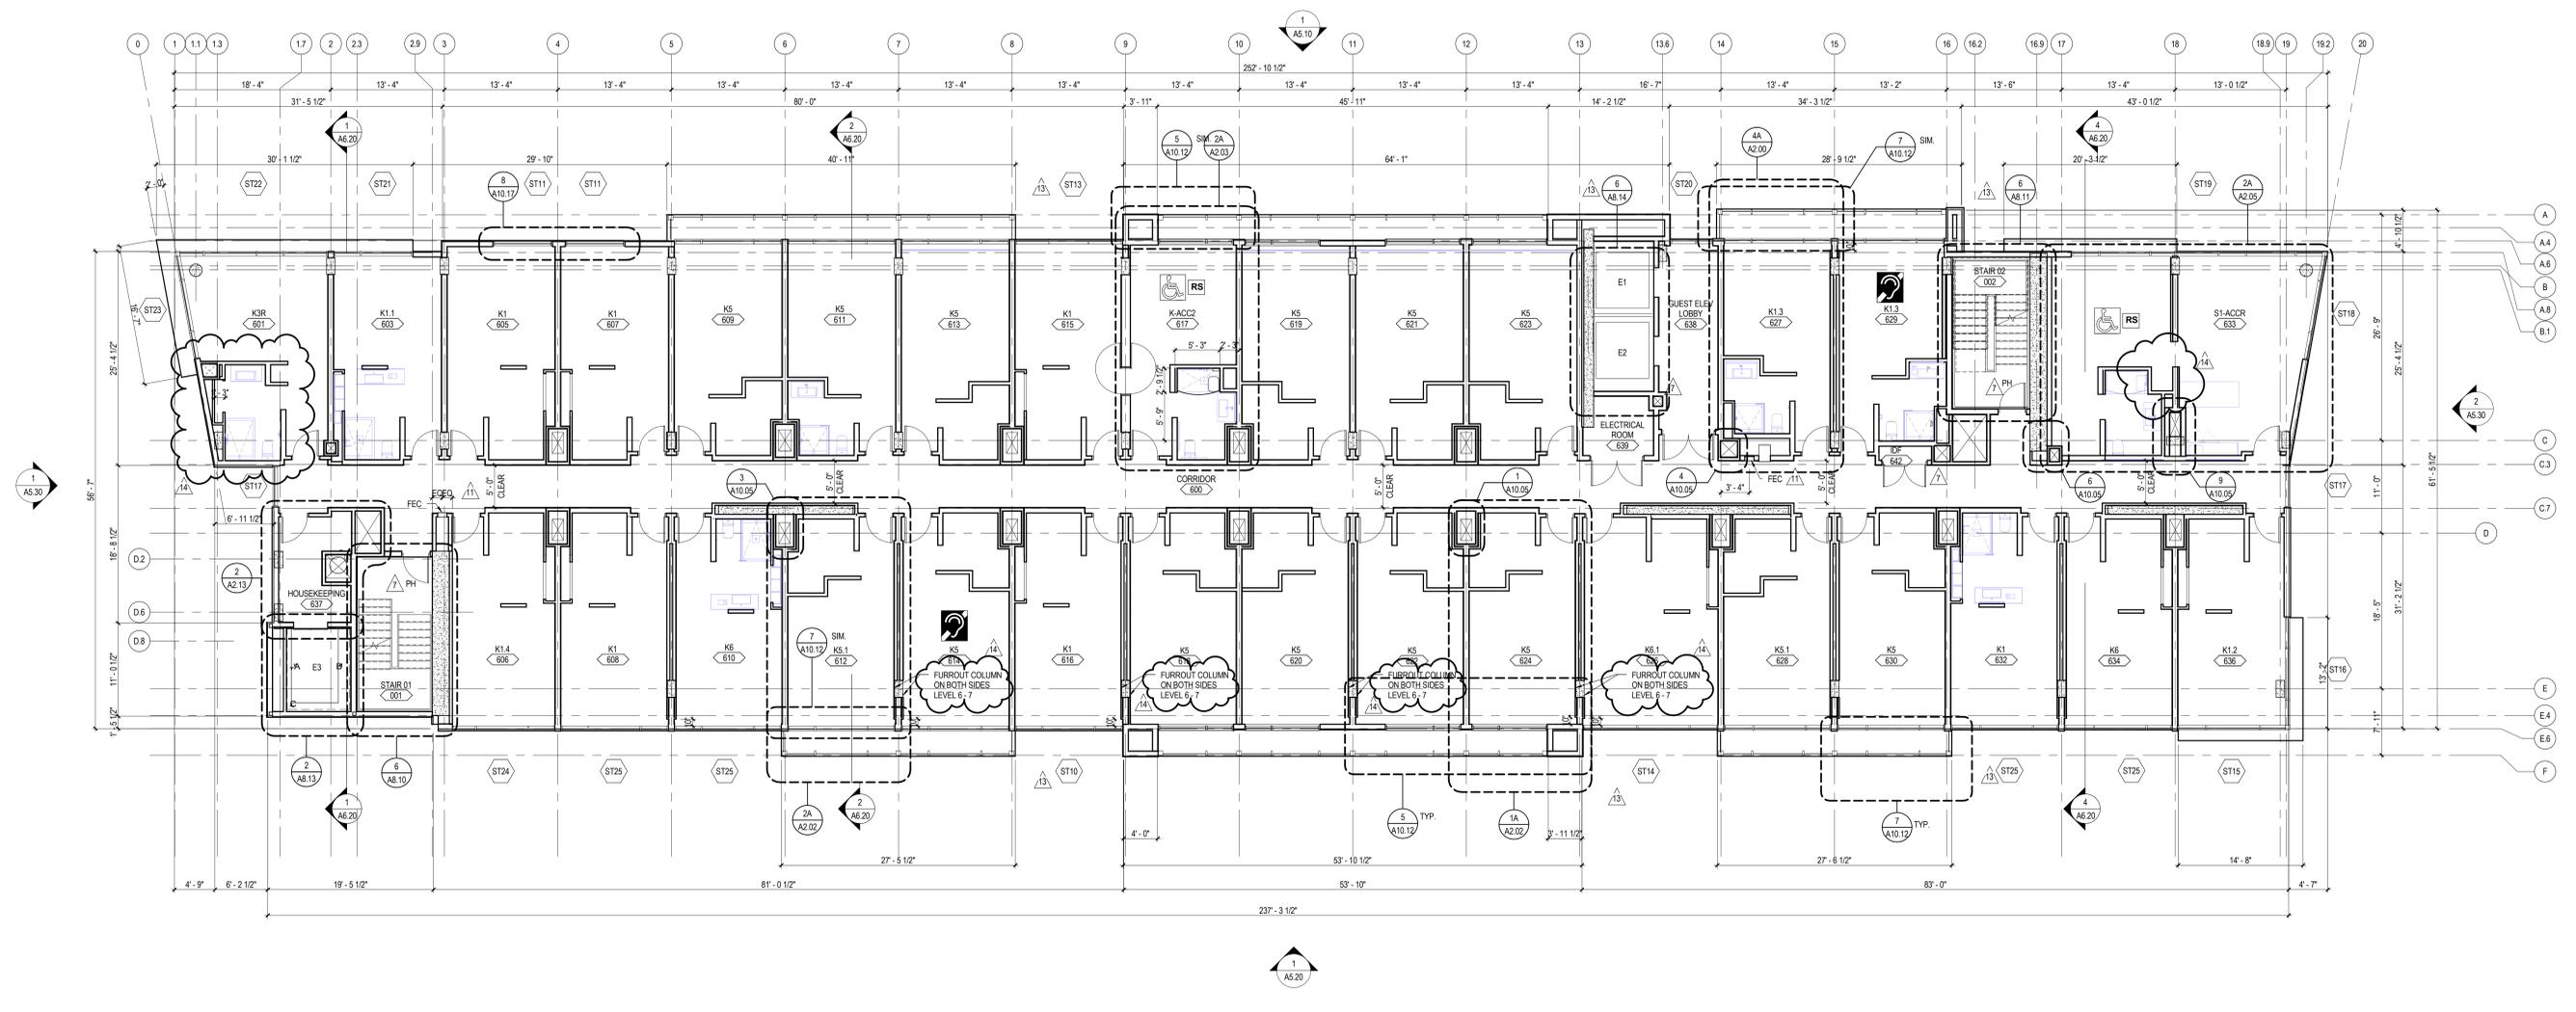

6TH LEVEL FLOOR PLAN
SCALE: 1/8" = 1'-0"

OVERALL BUILDING NOTES

- A. GENERAL NOTES APPLY TO ALL SHEETS.
- B. ALL DIMENSIONS ARE TO FACE OF STUDS UNLESS OTHERWISE NOTED.
- C. G.C. TO PROVIDE 2 HR FIRE RESISTANCE RATED SUPPLY BOX @ ALL SHOWER VALVE LOCATIONS.
- D. WALL TYPES SHALL BE DESIGNATED ON FLOOR PLANS. SEE SHEET A10.00 FOR PARTITION ASSEMBLIES.
- E. INTERIOR STUD WALLS SHALL EXTEND TO UNDERSIDE OF RATED FLOOR/CEILING ASSEMBLIES, OR RATED ROOF/CEILING ASSEMBLIES, UNLESS NOTED OTHERWISE. SEE REFLECTED CEILING PLAN NOTES.
- F. PROVISIONS SHALL BE MADE AT FULL HEIGHT NONBEARING WALLS FOR 1-INCH VERTICAL MOVEMENT OF BUILDING STRUCTURE WITHOUT TRANSFER OF COMPRESSIVE LOADS TO WALL. FILL IRREGULARITIES BETWEEN TOP OF WALL AND DECK ABOVE WITH FIRE SAFING INSULATION OR FIRE STOPPING MATERIALS AS REQUIRED TO MEET FIRE RATINGS OF RESPECTIVE WALLS.
- G. SEE STRUCTURAL DRAWINGS FOR BRACING OF NON-LOAD BEARING METAL WALLS ON GROUND FLOOR. SEE SHEET A10.00.
- H. FURNISH AND INSTALL METAL BLOCKING IN METAL STUD PARTITIONS FOR PROPER ANCHORAGE OF WALL ATTACHED ITEMS, I.E. TOILET ACCESSORIES, TOILET PARTITIONS, CASEWORK, MILLWORK, WALL MOUNTED FIXTURES, MARKERBOARDS, TACKBOARDS, DOOR STOPS, AUDIO VISUAL BRACKETS, ETC.
- I. GYPSUM BOARD AND PLASTER SURFACES SHALL BE ISOLATED WITH CONTROL JOINTS WHERE INDICATED ON DRAWINGS AND/OR AS DESCRIBED IN THE SPECIFICATIONS.
- J. PROVIDE 5/8" TYPE-X MOISTURE RESISTANT GYP. BD. @ BATHROOM WALLS AND CEILINGS.
- K. REFER TO PROJECT MANUAL, SECTION 01 11 00, FOR ITEMS THAT ARE: 1. OWNER-FURNISHED / OWNER-INSTALLED 2. OWNER-FURNISHED / CONTRACTOR-INSTALLED
- L. REFER TO PROJECT MANUAL, SECTION 01 11 00, FOR ITEMS THAT ARE: 1. OWNER-FURNISHED / OWNER-INSTALLED 2. OWNER-FURNISHED / CONTRACTOR-INSTALLED
- M. ARCHITECTURAL GROUND FLOOR ELEVATION OF -0'-0" EQUALS FLOOR ELEVATION OF 179.00' FEET, PER CIVIL PLANS.
- N. SCRIBE GYPSUM BOARD OF WALL AND PARTITIONS TO IRREGULARITIES OF DECK ABOVE. SEAL TIGHTLY AROUND PENETRATIONS.
- O. PROVIDE SEISMIC BRACING FOR SUSPENDED CEILINGS OR AS INDICATED ON DRAWINGS.
- P. DOORS TO BE OPENABLE FROM INSIDE WITHOUT A KEY OR ANY SPECIAL KNOWLEDGE.
- Q. ANNULAR SPACES AROUND PIPES, ELECTRIC CABLES, CONDUITS OR OTHER OPENINGS IN SILL OR BOTTOM PLATES AT EXTERIOR WALLS SHALL BE PROTECTED AGAINST THE PASSAGE OF RODENTS BY CLOSING SUCH OPENINGS WITH CEMENT MORTAR, CONCRETE MASONRY, OR SIMILAR ACCEPTABLE METHODS. CGSSC SECTION 4.408.1.
- R. BATHROOM EXHAUST FANS MUST BE ENERGY STAR COMPLIANT. MUST BE DUCTED TO TERMINATE OUTSIDE THE BUILDING, AND MUST BE CONTROLLED BY A HUMIDISTAT WHICH SHALL BE READILY ACCESSIBLE. CGSSC SECTION 4.508.
- S. FOR MILLWORK PLANS SEE INTERIOR DESIGN PLANS.
- T. G.C. TO PROVIDE MINERAL FIBER FIREBLOCKING AT PENETRATIONS CONNECTING NOT MORE THAN TWO STORIES.
- U. ALL FLOOR CLEAN-OUTS LOCATED IN CARPETED AREAS ARE TO BE FITTED WITH CARPET INSERTS. ALL CLEAN-OUTS TO BE FLUSH TO FLOOR/WALLS. CLEAN-OUTS ARE NOT PERMITTED IN GUEST ROOMS.
- V. ALL WATER CLOSET WASTE LINES TO BE LOCATED WITHIN INTERIOR WALL CHASE.
- W. DESIGNATED ACCESSIBLE GUESTROOMS ARE IDENTIFIED BY THE INTERNATIONAL ACCESSIBILITY SYMBOL ON EACH BUILDING FLOOR PLAN.
- X. PROVIDE MAXIMUM OCCUPANT SIGN IN ALL ASSEMBLY AREAS.
- Y. PURSUANT TO SECTION 703.7 OF THE CALIFORNIA BUILDING CODE, ALL MARKING AND IDENTIFICATION OF FIRE WALLS, FIRE BARRIERS, FIRE PARTITIONS, SMOKE BARRIERS AND SMOKE PARTITIONS OR ANY OTHER WALL REQUIRED TO HAVE PROTECTED OPENINGS OR PENETRATIONS SHALL BE EFFECTIVELY AND PERMANENTLY IDENTIFIED WITH SIGNS OR STENCILING AND SHALL MEET THE THREE FOLLOWING REQUIREMENTS: 1) BE LOCATED IN ACCESSIBLE CONCEALED FLOOR, FLOOR-CEILING OR ATTIC SPACES; 2) BE LOCATED WITHIN 15 FEET (4572 mm) OF THE END OF EACH WALL AND AT INTERVALS NOT EXCEEDING 30 FEET (9144 MM) MEASURED HORIZONTALLY ALONG THE WALL OR PARTITION AND 3) INCLUDE LETTERING NOT LESS THAN 3 INCHES (76 mm) IN HEIGHT WITH A MINIMUM 3/8" (9.5 mm) STROKE IN A CONTRASTING COLOR OR INCORPORATE THE SUGGESTED WORDING: "FIRE AND/OR SMOKE BARRIER-PROTECT ALL OPENINGS," OR OTHER WORDING. EXCEPTION: WALLS IN GROUP R-2 OCCUPANCIES THAT DO NOT HAVE A REMOVABLE DECORATIVE CEILING ALLOWING ACCESS TO THE CONCEALED SPACE.
- Z. FIRE EXTINGUISHER SIZES:
- 4A:80B-C RATING SIZE FOR HIGH HAZARD AREAS
- 2A:80B-C RATING SIZE FOR MODERATE HAZARD AREAS
AA. INTERIOR STAIRWAY MEANS OF EGRESS DORRIS SHALL BE OPENABLE FROM BOTH SIDES WITHOUT THE USE OF KEY OR SPECIAL KNOWLEDGE OR EFFORT (CBC 1008.1.9.11).


LEGEND


- DOOR TAG (SEE A9.20 FOR MORE INFORMATION)
- STOREFRONT TAG (SEE SHEETS A8.10 & A9.11 FOR MORE INFORMATION)
- ROOM NAME
ROOM NUMBER
- ACCESSIBLE GUESTROOM W/ MOBILITY FEATURES - TT (TRANSFER TUB) RS (ROLL-IN SHOWER)
- GUESTROOM W/ COMMUNICATION FEATURE ASSISTED LISTENING DEVICE

LEGEND NOTES

- 1. LEGEND NOTES ARE COMMON TO ALL SOME NOTES MAY NOT APPLY TO THIS SHEET
- 2. SEE DWG. A2.00 SERIES FOR GUESTROOM CEILING

KEY PLAN

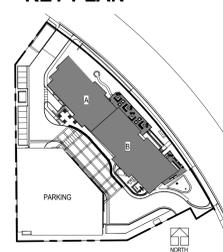

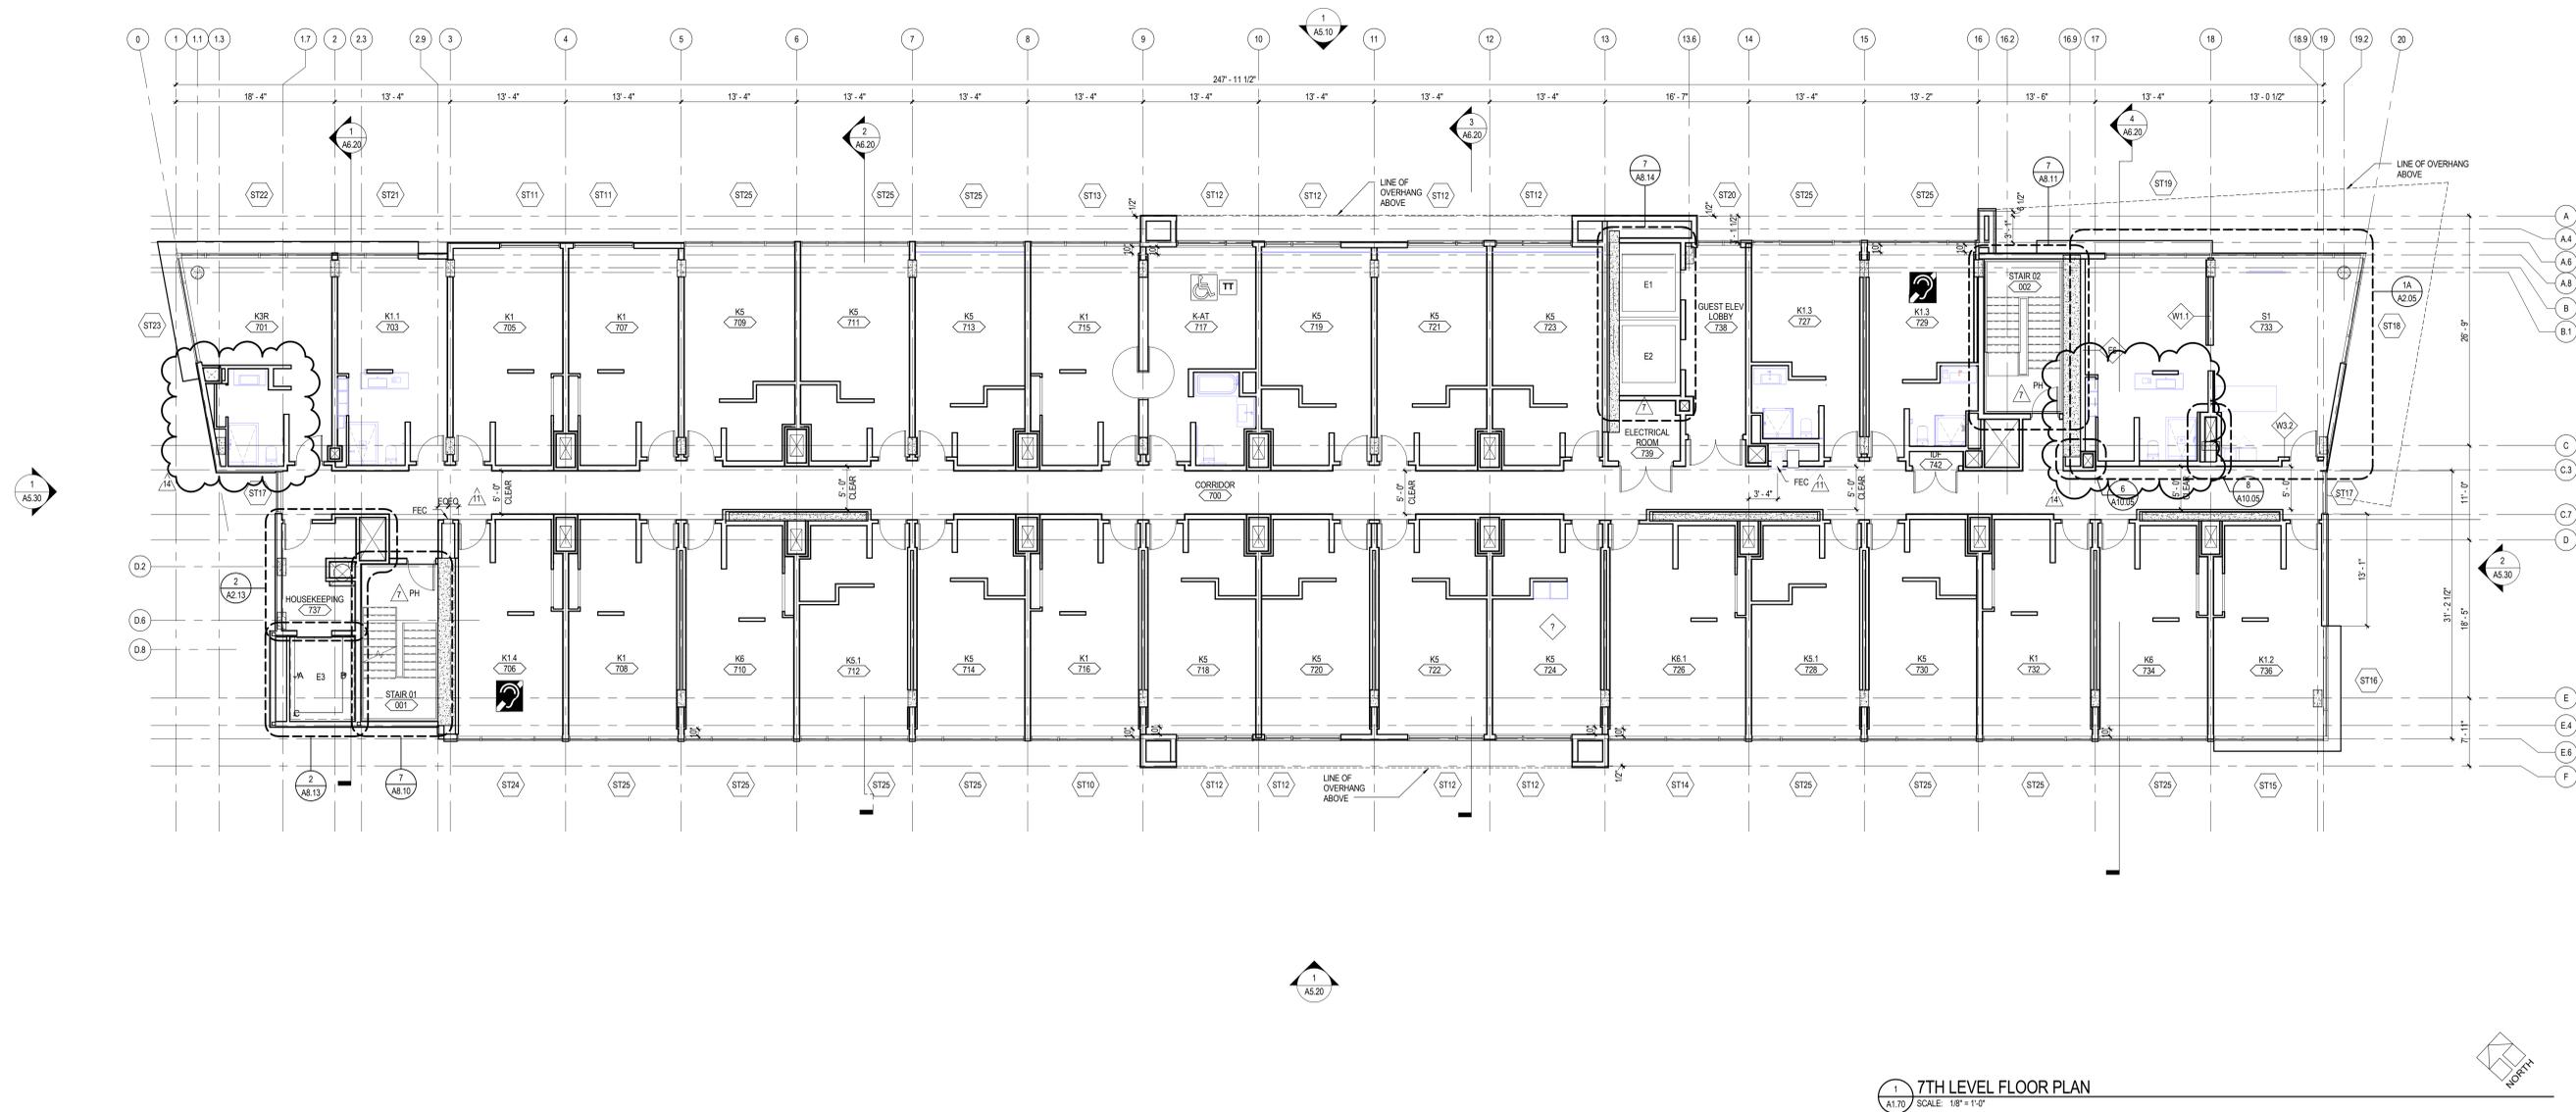

7TH LEVEL FLOOR PLAN
SCALE: 1/8" = 1'-0"

REFER TO SHEET A1.60 6TH LEVEL FLOORPLAN FOR ADDITIONAL SIMILAR BUILDING EXTERIOR DIMENSIONS

OVERALL BUILDING NOTES

- A. GENERAL NOTES APPLY TO ALL SHEETS.
- B. ALL DIMENSIONS ARE TO FACE OF STUDS UNLESS OTHERWISE NOTED.
- C. G. C. TO PROVIDE 2-HR FIRE RESISTANCE RATED SUPPLY BOX @ ALL SHOWER VALVE LOCATIONS.
- D. WALL TYPES SHALL BE DESIGNATED ON FLOOR PLANS. SEE SHEET A10.00 FOR PARTITION ASSEMBLIES.
- E. INTERIOR STUD WALLS SHALL EXTEND TO UNDERSIDE OF RATED FLOOR/CEILING ASSEMBLIES, OR RATED ROOF/CEILING ASSEMBLIES, UNLESS NOTED OTHERWISE. SEE REFLECTED CEILING PLAN NOTES.
- F. PROVISIONS SHALL BE MADE AT FULL HEIGHT NONBEARING WALLS FOR 1-INCH VERTICAL MOVEMENT OF BUILDING STRUCTURE WITHOUT TRANSFER OF COMPRESSIVE LOADS TO WALL. FILL IRREGULARITIES BETWEEN TOP OF WALL AND DECK ABOVE WITH FIRE SAFING INSULATION OR FIRE STOPPING MATERIALS AS REQUIRED TO MEET FIRE RATINGS OF RESPECTIVE WALLS.
- G. SEE STRUCTURAL DRAWINGS FOR BRACING OF NON-LOAD BEARING METAL WALLS ON GROUND FLOOR. SEE SHEET A10.00.
- H. FURNISH AND INSTALL METAL BLOCKING IN METAL STUD PARTITIONS FOR PROPER ANCHORAGE OF WALL ATTACHED ITEMS, I.E. TOILET ACCESSORIES, TOILET PARTITIONS, CASEWORK, MILLWORK, WALL-MOUNTED FIXTURES, MARKERBOARDS, TACKBOARDS, DOOR STOPS, AUDIO VISUAL BRACKETS, ETC.
- I. GYPSUM BOARD AND PLASTER SURFACES SHALL BE ISOLATED WITH CONTROL JOINTS WHERE INDICATED ON DRAWINGS AND/OR AS DESCRIBED IN THE SPECIFICATIONS.
- J. PROVIDE 5/8" TYPE-X MOISTURE RESISTANT GYP. BD. @ BATHROOM WALLS AND CEILINGS.
- K. REFER TO PROJECT MANUAL, SECTION 01 11 00, FOR ITEMS THAT ARE:
1. OWNER-FURNISHED / OWNER-INSTALLED
2. OWNER-FURNISHED / CONTRACTOR-INSTALLED
- L. REFER TO PROJECT MANUAL, SECTION 01 11 00, FOR ITEMS THAT ARE:
1. OWNER-FURNISHED / OWNER-INSTALLED
2. OWNER-FURNISHED / CONTRACTOR-INSTALLED
- M. ARCHITECTURAL GROUND FLOOR ELEVATION OF -0'-0" EQUALS FLOOR ELEVATION OF -179.00' FEET, PER CIVIL PLANS.
- N. SCRIBE GYPSUM BOARD OF WALL AND PARTITIONS TO IRREGULARITIES OF DECK ABOVE. SEAL TIGHTLY AROUND PENETRATIONS.

- O. PROVIDE SEISMIC BRACING FOR SUSPENDED CEILINGS OR AS INDICATED ON DRAWINGS.
- P. DOORS TO BE OPENABLE FROM INSIDE WITHOUT A KEY OR ANY SPECIAL KNOWLEDGE.
- Q. ANNULAR SPACES AROUND PIPES, ELECTRIC CABLES, CONDUITS OR OTHER OPENINGS IN SILL OR BOTTOM PLATES AT EXTERIOR WALLS SHALL BE PROTECTED AGAINST THE PASSAGE OF RODENTS BY CLOSING SUCH OPENINGS WITH CEMENT MORTAR, CONCRETE MASONRY, OR SIMILAR ACCEPTABLE METHODS. CGSBC SECTION 4.4.6.1.
- R. BATHROOM EXHAUST FANS MUST BE ENERGY STAR COMPLIANT. MUST BE DUCTED TO TERMINATE OUTSIDE THE BUILDING, AND MUST BE CONTROLLED BY A HUMIDISTAT WHICH SHALL BE READILY ACCESSIBLE. CGSBC SECTION 4.5.6.
- S. FOR MILLWORK PLANS SEE INTERIOR DESIGN PLANS.
- T. G. C. TO PROVIDE MINERAL FIBER FIREBLOCKING AT PENETRATIONS CONNECTING NOT MORE THAN TWO STORIES.
- U. ALL FLOOR CLEAN-OUTS LOCATED IN CARPETED AREAS ARE TO BE FITTED WITH CARPET INSERTS. ALL CLEAN-OUTS TO BE FLUSH TO FLOOR/WALLS. CLEAN-OUTS ARE NOT PERMITTED IN GUEST ROOMS.

- V. ALL WATER CLOSET WASTE LINES TO BE LOCATED WITHIN INTERIOR WALL CHASE.
- W. DESIGNATED ACCESSIBLE GUESTROOMS ARE IDENTIFIED BY THE INTERNATIONAL ACCESSIBILITY SYMBOL ON EACH BUILDING FLOOR PLAN.
- X. PROVIDE MAXIMUM OCCUPANT SIGN IN ALL ASSEMBLY AREAS.
- Y. PURSUANT TO SECTION 703.7 OF THE CALIFORNIA BUILDING CODE, ALL MARKING AND IDENTIFICATION OF FIRE WALLS, FIRE BARRIERS, FIRE PARTITIONS, SMOKE BARRIERS AND SMOKE PARTITIONS OR ANY OTHER WALL REQUIRED TO HAVE PROTECTED OPENINGS OR PENETRATIONS SHALL BE EFFECTIVELY AND PERMANENTLY IDENTIFIED WITH SIGNS OR STENCILING AND SHALL MEET THE THREE FOLLOWING REQUIREMENTS:
1) BE LOCATED IN ACCESSIBLE CONCEALED FLOOR, FLOOR-CEILING OR ATTIC SPACES;
2) BE LOCATED WITHIN 15 FEET (4572 mm) OF THE END OF EACH WALL AND AT INTERVALS NOT EXCEEDING 30 FEET (9144 mm) MEASURED HORIZONTALLY ALONG THE WALL OR PARTITION AND;
3) INCLUDE LETTERING NOT LESS THAN 3 INCHES (76 mm) IN HEIGHT WITH A MINIMUM 3/8" (9.5 mm) STROKE IN A CONTRASTING COLOR OR INCORPORATE THE SUGGESTED WORDING "FIRE AND/OR SMOKE BARRIER-PROTECT ALL OPENINGS," OR OTHER WORDING.
EXCEPTION: WALLS IN GROUP R-2 OCCUPANCIES THAT DO NOT HAVE A REMOVABLE DECORATIVE CEILING ALLOWING ACCESS TO THE CONCEALED SPACE.


- Z. FIRE EXTINGUISHER SIZES:
- 4A:80B-C RATING SIZE FOR HIGH HAZARD AREAS
- 2A:80B-C RATING SIZE FOR MODERATE HAZARD AREAS
- AA. INTERIOR STAIRWAY MEANS OF EGRESS DORRS SHALL BE OPENABLE FROM BOTH SIDES WITHOUT THE USE OF KEY OR SPECIAL KNOWLEDGE OR EFFORT (CBC 1008.1.9.11).

LEGEND

	DOOR TAG (SEE A9.20 FOR MORE INFORMATION)
	STOREFRONT TAG (SEE SHEETS A9.10 & A9.11 FOR MORE INFORMATION)
	ROOM NAME ROOM NUMBER
	ACCESSIBLE GUESTROOM W/ MOBILITY FEATURES - TT (TRANSFER TUB) RS (ROLL-IN SHOWER)
	GUESTROOM W/ COMMUNICATION FEATURE ASSISTED LISTENING DEVICE

LEGEND NOTES

1. LEGEND NOTES ARE COMMON TO ALL SOME NOTES MAY NOT APPLY TO THIS SHEET
2. SEE DWG. A2.00 SERIES FOR GUESTROOM CEILING

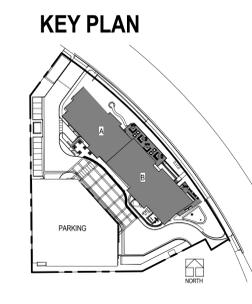

ENLARGED GUESTROOM NOTES

1. ALL FLOOR PLAN LAYOUTS HAVE A MIRRORRED VERSION (RIGHT OR LEFT)
2. DESIGNATED GUESTROOMS WITH MOBILITY FEATURES TO COMPLY WITH 2013 CBC CHAPTER 11-B FOR TRANSIENT LODGING ACCOMMODATIONS
3. FOR ACCESSORY SCHEDULE, REFER TO SPECIFICATIONS SECTION 10 28 00
4. ELECTRICAL OUTLETS MOUNTED AT STANDARD HEIGHT OF 18" AFF UNLESS OTHERWISE NOTED
5. REFER TO INTERIOR DRAWINGS FOR FURNITURE AND FINISH INFORMATION
6. MOUNT IRONING BOARD AND IRON RACK AT 72" AFF. PROVIDE BLOCKING
7. WALL OUTLETS PER ID DRAWINGS
8. PROVIDE BLOCKING FOR SHELVING AND ACCESSORIES
9. FOR BATHROOM DETAILS REFER TO ID DRAWINGS

HOTEL ONLY
SUBMITTAL

AC MARRIOTT HOTEL
2970 LAKESIDE DRIVE
SANTA CLARA, CALIFORNIA

ENLARGED PLANS - GUESTROOMS




DLR Group
Architecture Engineering Planning Interiors
© 2015, DLR Group, Inc., a California corporation. ALL RIGHTS RESERVED.


75-15748-00
07/26/2017
Revisions

12 HOTEL ONLY RESUBMITTAL 01/23/2018
14 PC/DG CORRECTIONS 03/29/2018
14 BULLETIN #, DOOR AND INTERIOR REVISIONS

A2.00

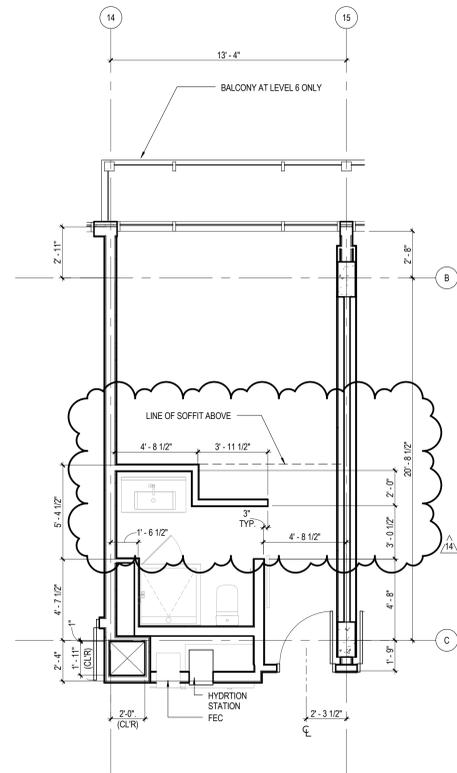


4A ENLARGED PLAN - K1.3
SCALE: 1/4" = 1'-0"

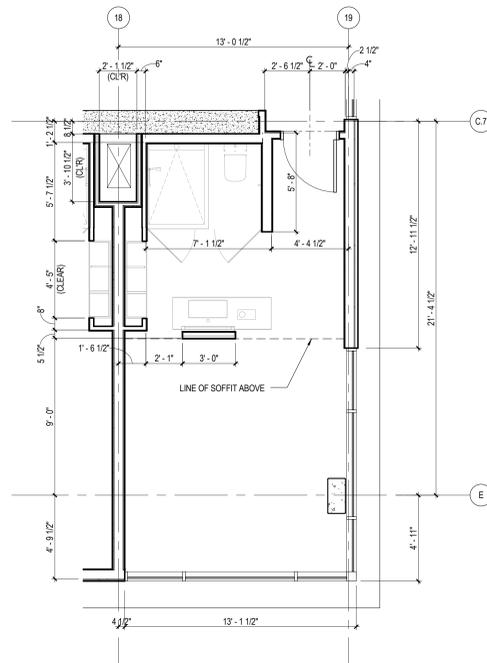


3A ENLARGED PLAN - K1.2
SCALE: 1/4" = 1'-0"


REFER TO INTERIOR DRAWING (ID 08.40)
FOR FURNITURE AND FINISH

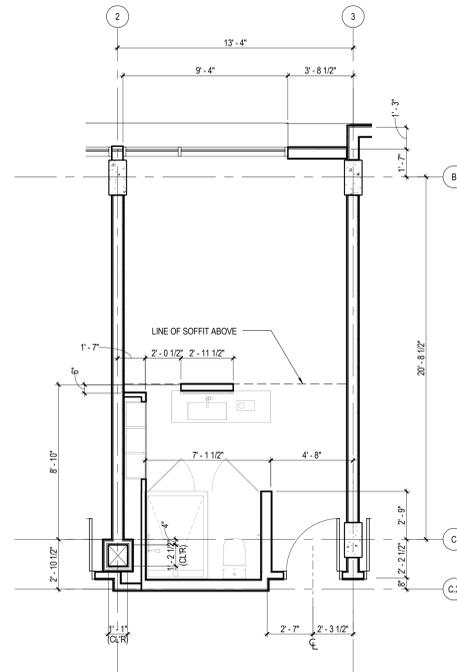


2A ENLARGED PLAN - K1B
SCALE: 1/4" = 1'-0"

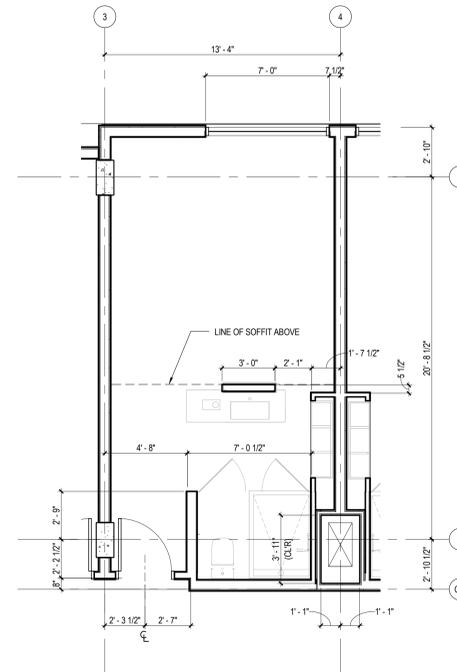


1A ENLARGED PLAN - K1A
SCALE: 1/4" = 1'-0"

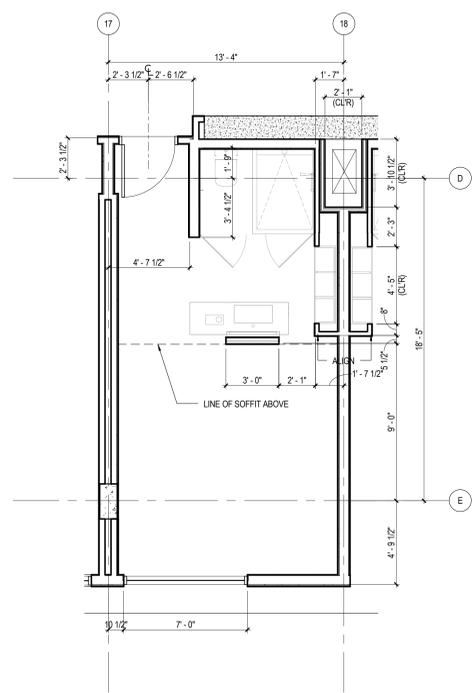

3A ENLARGED PLAN - K6R
A2.02 SCALE: 1/4" = 1'-0"

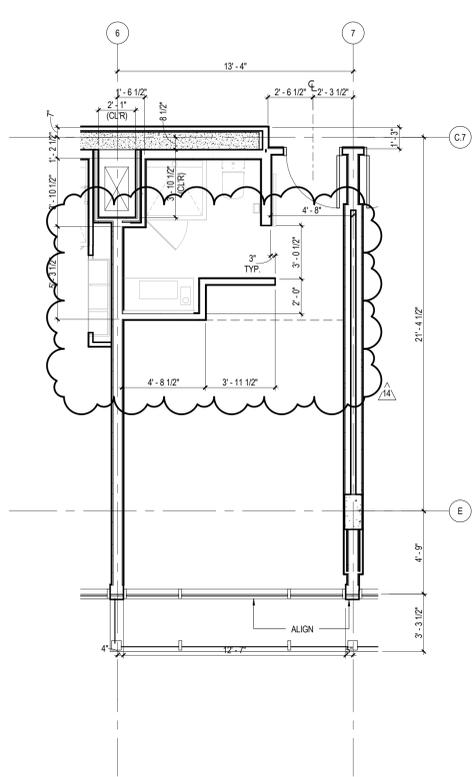

2A ENLARGED PLAN - K5.1
A2.02 SCALE: 1/4" = 1'-0"

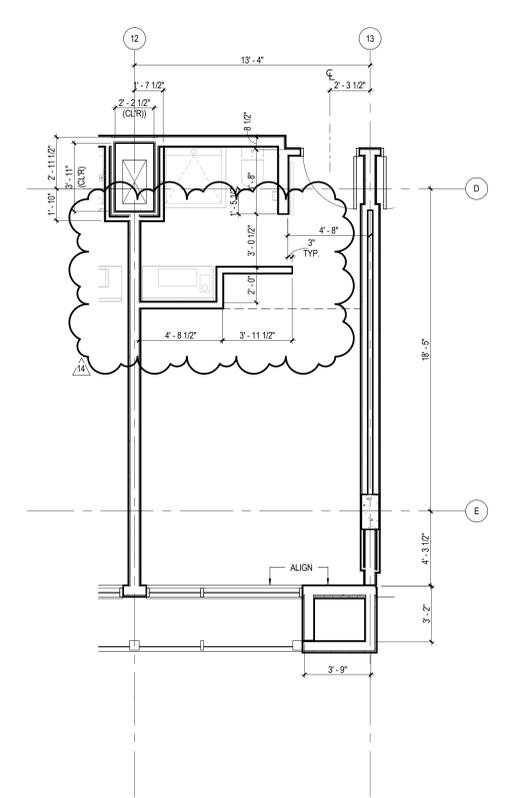

1A ENLARGED PLAN - K5
A2.02 SCALE: 1/4" = 1'-0"

ENLARGED GUESTROOM NOTES

1. ALL FLOOR PLAN LAYOUTS HAVE A MIRRORED VERSION (RIGHT OR LEFT)
2. DESIGNATED GUESTROOMS WITH MOBILITY FEATURES TO COMPLY WITH 2013 CBC CHAPTER 11-B FOR TRANSIENT LODGING ACCOMMODATIONS
3. FOR ACCESSORY SCHEDULE, REFER TO SPECIFICATIONS SECTION 10 28 00
4. ELECTRICAL OUTLETS MOUNTED AT STANDARD HEIGHT OF 18" AFF UNLESS OTHERWISE NOTED
5. REFER TO INTERIOR DRAWINGS FOR FURNITURE AND FINISH INFORMATION
6. MOUNT IRONING BOARD AND IRON RACK AT 72" AFF. PROVIDE BLOCKING
7. WALL OUTLETS PER ID DRAWINGS
8. PROVIDE BLOCKING FOR SHELVING AND ACCESSORIES
9. FOR BATHROOM DETAILS REFER TO ID DRAWINGS.

HOTEL ONLY
SUBMITTAL
AC MARRIOTT HOTEL
2970 LAKESIDE DRIVE
SANTA CLARA, CALIFORNIA

ENLARGED PLANS - GUESTROOMS



DLR Group
Architecture Engineering Planning Interiors
© 2015, DLR Group, Inc., a California corporation. ALL RIGHTS RESERVED.

75-15748-00
07/26/2017
Revisions
12 HOTEL ONLY RESUBMITTAL 01/23/2018
13 PCFD CORRECTIONS
14 BULLETIN #2 - DOOR AND INTERIOR REVISIONS 03/29/2018

ENLARGED GUESTROOM NOTES

1. ALL FLOOR PLAN LAYOUTS HAVE A MIRRORED VERSION (RIGHT OR LEFT)
2. DESIGNATED GUESTROOMS WITH MOBILITY FEATURES TO COMPLY W/ 2013 CBC CHAPTER 11-B FOR TRANSIENT LODGING ACCOMMODATIONS
3. FOR ACCESSORY SCHEDULE, REFER TO SPECIFICATIONS SECTION 10 28 00
4. ELECTRICAL OUTLETS MOUNTED AT STANDARD HEIGHT OF 18" AFF UNLESS OTHERWISE NOTED
5. REFER TO INTERIOR DRAWINGS FOR FURNITURE AND FINISH INFORMATION
6. MOUNT IRONING BOARD AND IRON RACK AT 72" AFF. PROVIDE BLOCKING
7. WALL OUTLETS PER ID DRAWINGS
8. PROVIDE BLOCKING FOR SHELVING AND ACCESSORIES
9. FOR BATHROOM DETAILS REFER TO ID DRAWINGS

HOTEL ONLY
SUBMITTAL

AC MARRIOTT HOTEL
2970 LAKESIDE DRIVE
SANTA CLARA, CALIFORNIA

ENLARGED PLANS - GUESTROOMS




DLR Group
Architecture Engineering Planning Interiors
© 2015, DLR Group, Inc., a California corporation. ALL RIGHTS RESERVED.


75-15746-00
07/26/2017
Revisions

12 HOTEL ONLY RESUBMITTAL 01/23/2018
14 PCFD CORRECTIONS
14 BULLETIN #2 - DOOR AND INTERIOR REVISIONS 03/29/2018

A2.03

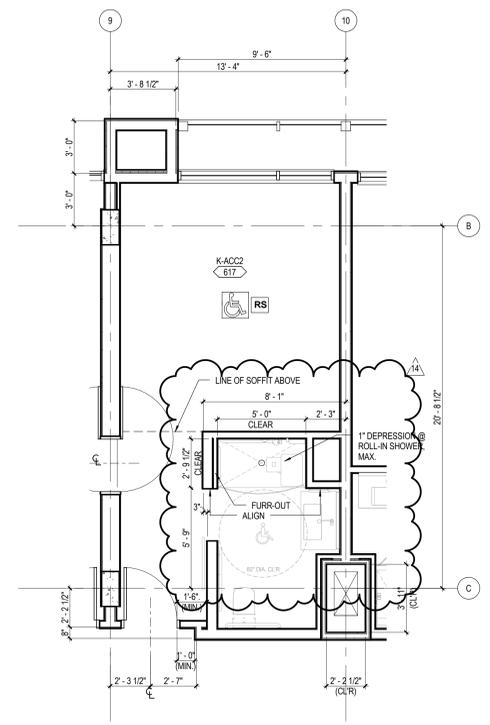

2A ENLARGED PLAN - K-ACC2
A2.03 SCALE: 1/4" = 1'-0"

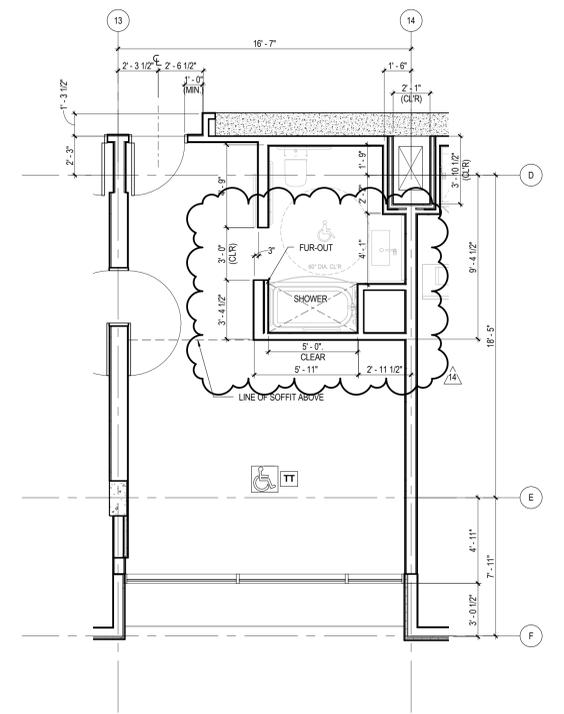

1A ENLARGED PLAN - K-ACC1
A2.03 SCALE: 1/4" = 1'-0"

ENLARGED GUESTROOM NOTES

1. ALL FLOOR PLAN LAYOUTS HAVE A MIRRORED VERSION (RIGHT OR LEFT)
2. DESIGNATED GUESTROOMS WITH MOBILITY FEATURES TO COMPLY WITH 2013 CBC CHAPTER 11-B FOR TRANSIENT LODGING ACCOMMODATIONS
3. FOR ACCESSORY SCHEDULE, REFER TO SPECIFICATIONS SECTION 10 28 00
4. ELECTRICAL OUTLETS MOUNTED AT STANDARD HEIGHT OF 18" AFF UNLESS OTHERWISE NOTED
5. REFER TO INTERIOR DRAWINGS FOR FURNITURE AND FINISH INFORMATION
6. MOUNT IRONING BOARD AND IRON RACK AT 72" AFF. PROVIDE BLOCKING
7. WALL OUTLETS PER ID DRAWINGS
8. PROVIDE BLOCKING FOR SHELVING AND ACCESSORIES
9. FOR BATHROOM DETAILS REFER TO ID DRAWINGS

AC MARRIOTT HOTEL
2970 LAKESIDE DRIVE
SANTA CLARA, CALIFORNIA


ENLARGED PLANS - GUESTROOMS




DLR Group
Architecture Engineering Planning Interiors
© 2015, DLR Group, Inc., a California corporation. ALL RIGHTS RESERVED.

75-15746-00
07/26/2017
Revisions
10 HOTEL ONLY RESUBMITTAL 10/03/2017
12 HOTEL ONLY RESUBMITTAL 01/23/2018
13 PCD CORRECTIONS
14 BULLETIN #2 - DOOR AND INTERIOR REVISIONS 03/26/2018


A2.04

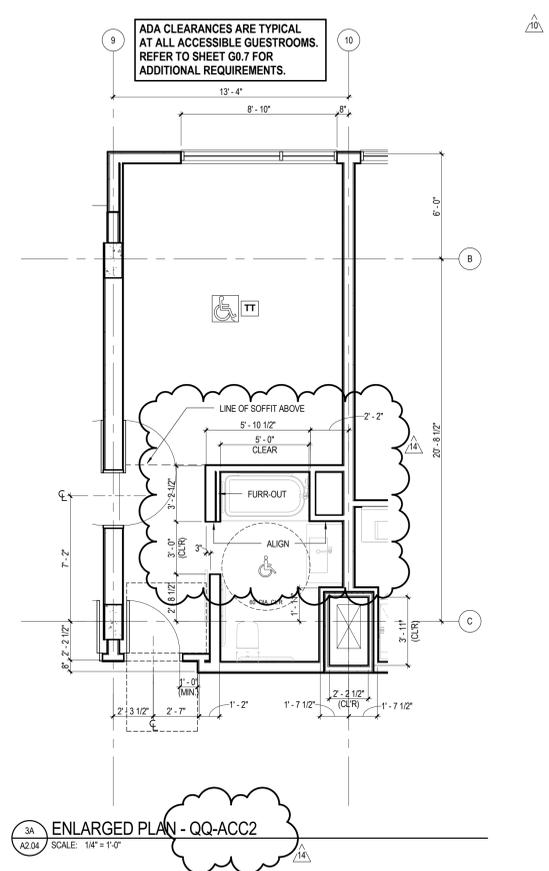

3A ENLARGED PLAN - QQ-ACC2
SCALE: 1/4" = 1'-0"

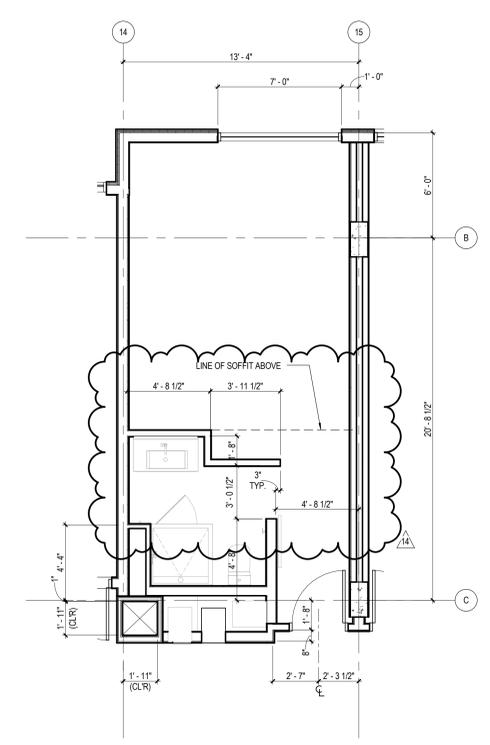

2A ENLARGED PLAN - QQ3 QUEEN
SCALE: 1/4" = 1'-0"

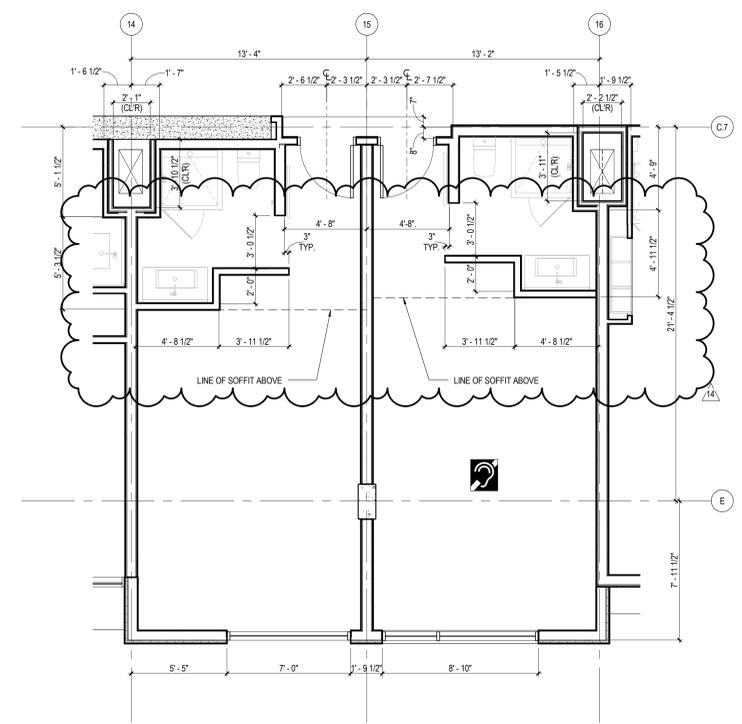

1A ENLARGED PLAN - QQ1 & QQ2 QUEEN
SCALE: 1/4" = 1'-0"

ENLARGED GUESTROOM NOTES

1. ALL FLOOR PLAN LAYOUTS HAVE A MIRRORED VERSION (RIGHT OR LEFT)
2. DESIGNATED GUESTROOMS WITH MOBILITY FEATURES TO COMPLY WITH 2013 CBC CHAPTER 11-B FOR TRANSIENT LODGING ACCOMMODATIONS
3. FOR ACCESSORY SCHEDULE, REFER TO SPECIFICATIONS SECTION 10 28 00
4. ELECTRICAL OUTLETS MOUNTED AT STANDARD HEIGHT OF 18" AFF UNLESS OTHERWISE NOTED
5. REFER TO INTERIOR DRAWINGS FOR FURNITURE AND FINISH INFORMATION
6. MOUNT IRONING BOARD AND IRON RACK AT 72" AFF. PROVIDE BLOCKING
7. WALL OUTLETS PER ID DRAWINGS
8. PROVIDE BLOCKING FOR SHELVING AND ACCESSORIES
9. FOR BATHROOM DETAILS REFER TO ID DRAWINGS

HOTEL ONLY
SUBMITTAL
AC MARRIOTT HOTEL
2970 LAKESIDE DRIVE
SANTA CLARA, CALIFORNIA


ENLARGED PLANS - GUESTROOMS




DLR Group
Architecture Engineering Planning Interiors
© 2016, DLR Group, Inc., a California corporation. ALL RIGHTS RESERVED.

75-15748-00
07/26/2017
Revisions
12 HOTEL ONLY RESUBMITTAL 01/23/2018
14 PCFD CORRECTIONS
14 BULLETIN #2 - DOOR AND INTERIOR REVISIONS 03/29/2018

A2.05

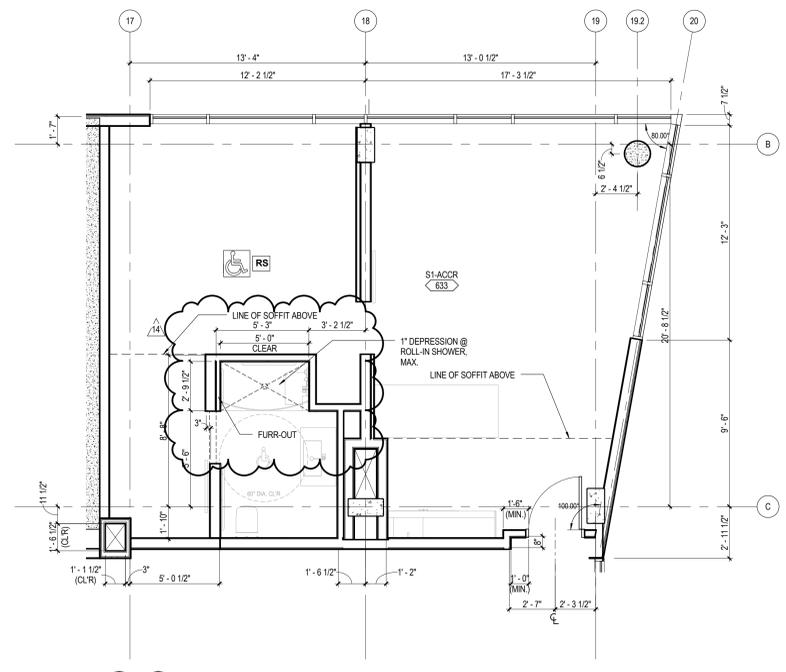


2A
A2.05 ENLARGED PLAN - S1-ACCR
SCALE: 1/4" = 1'-0"

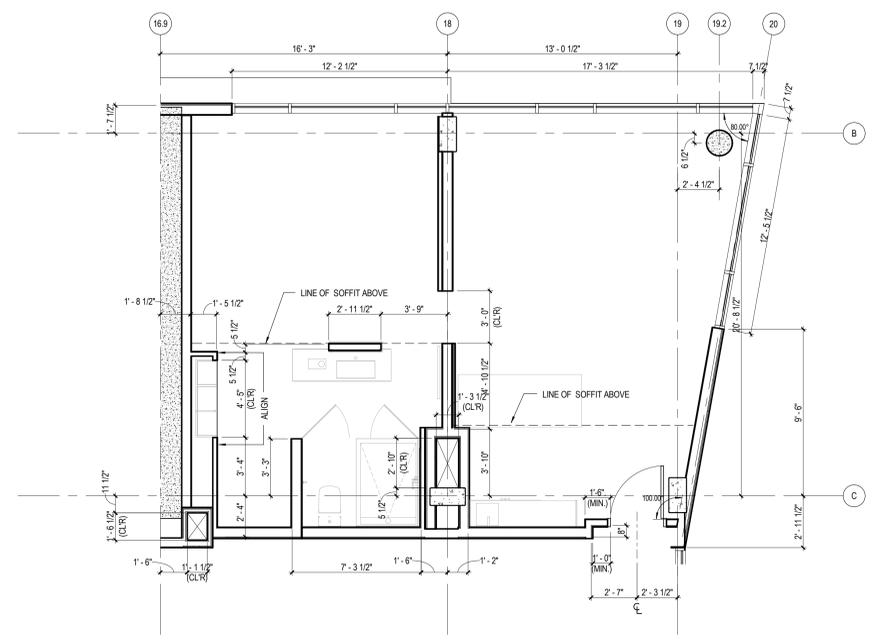

1A
A2.05 ENLARGED PLAN - S-1 FAMILY SUITE
SCALE: 1/4" = 1'-0"

C:\Revit\75-15746-00_AR_2015_CENTRAL_enging@dlrgrp.com.rvt
5/12/2018 1:55:31 PM

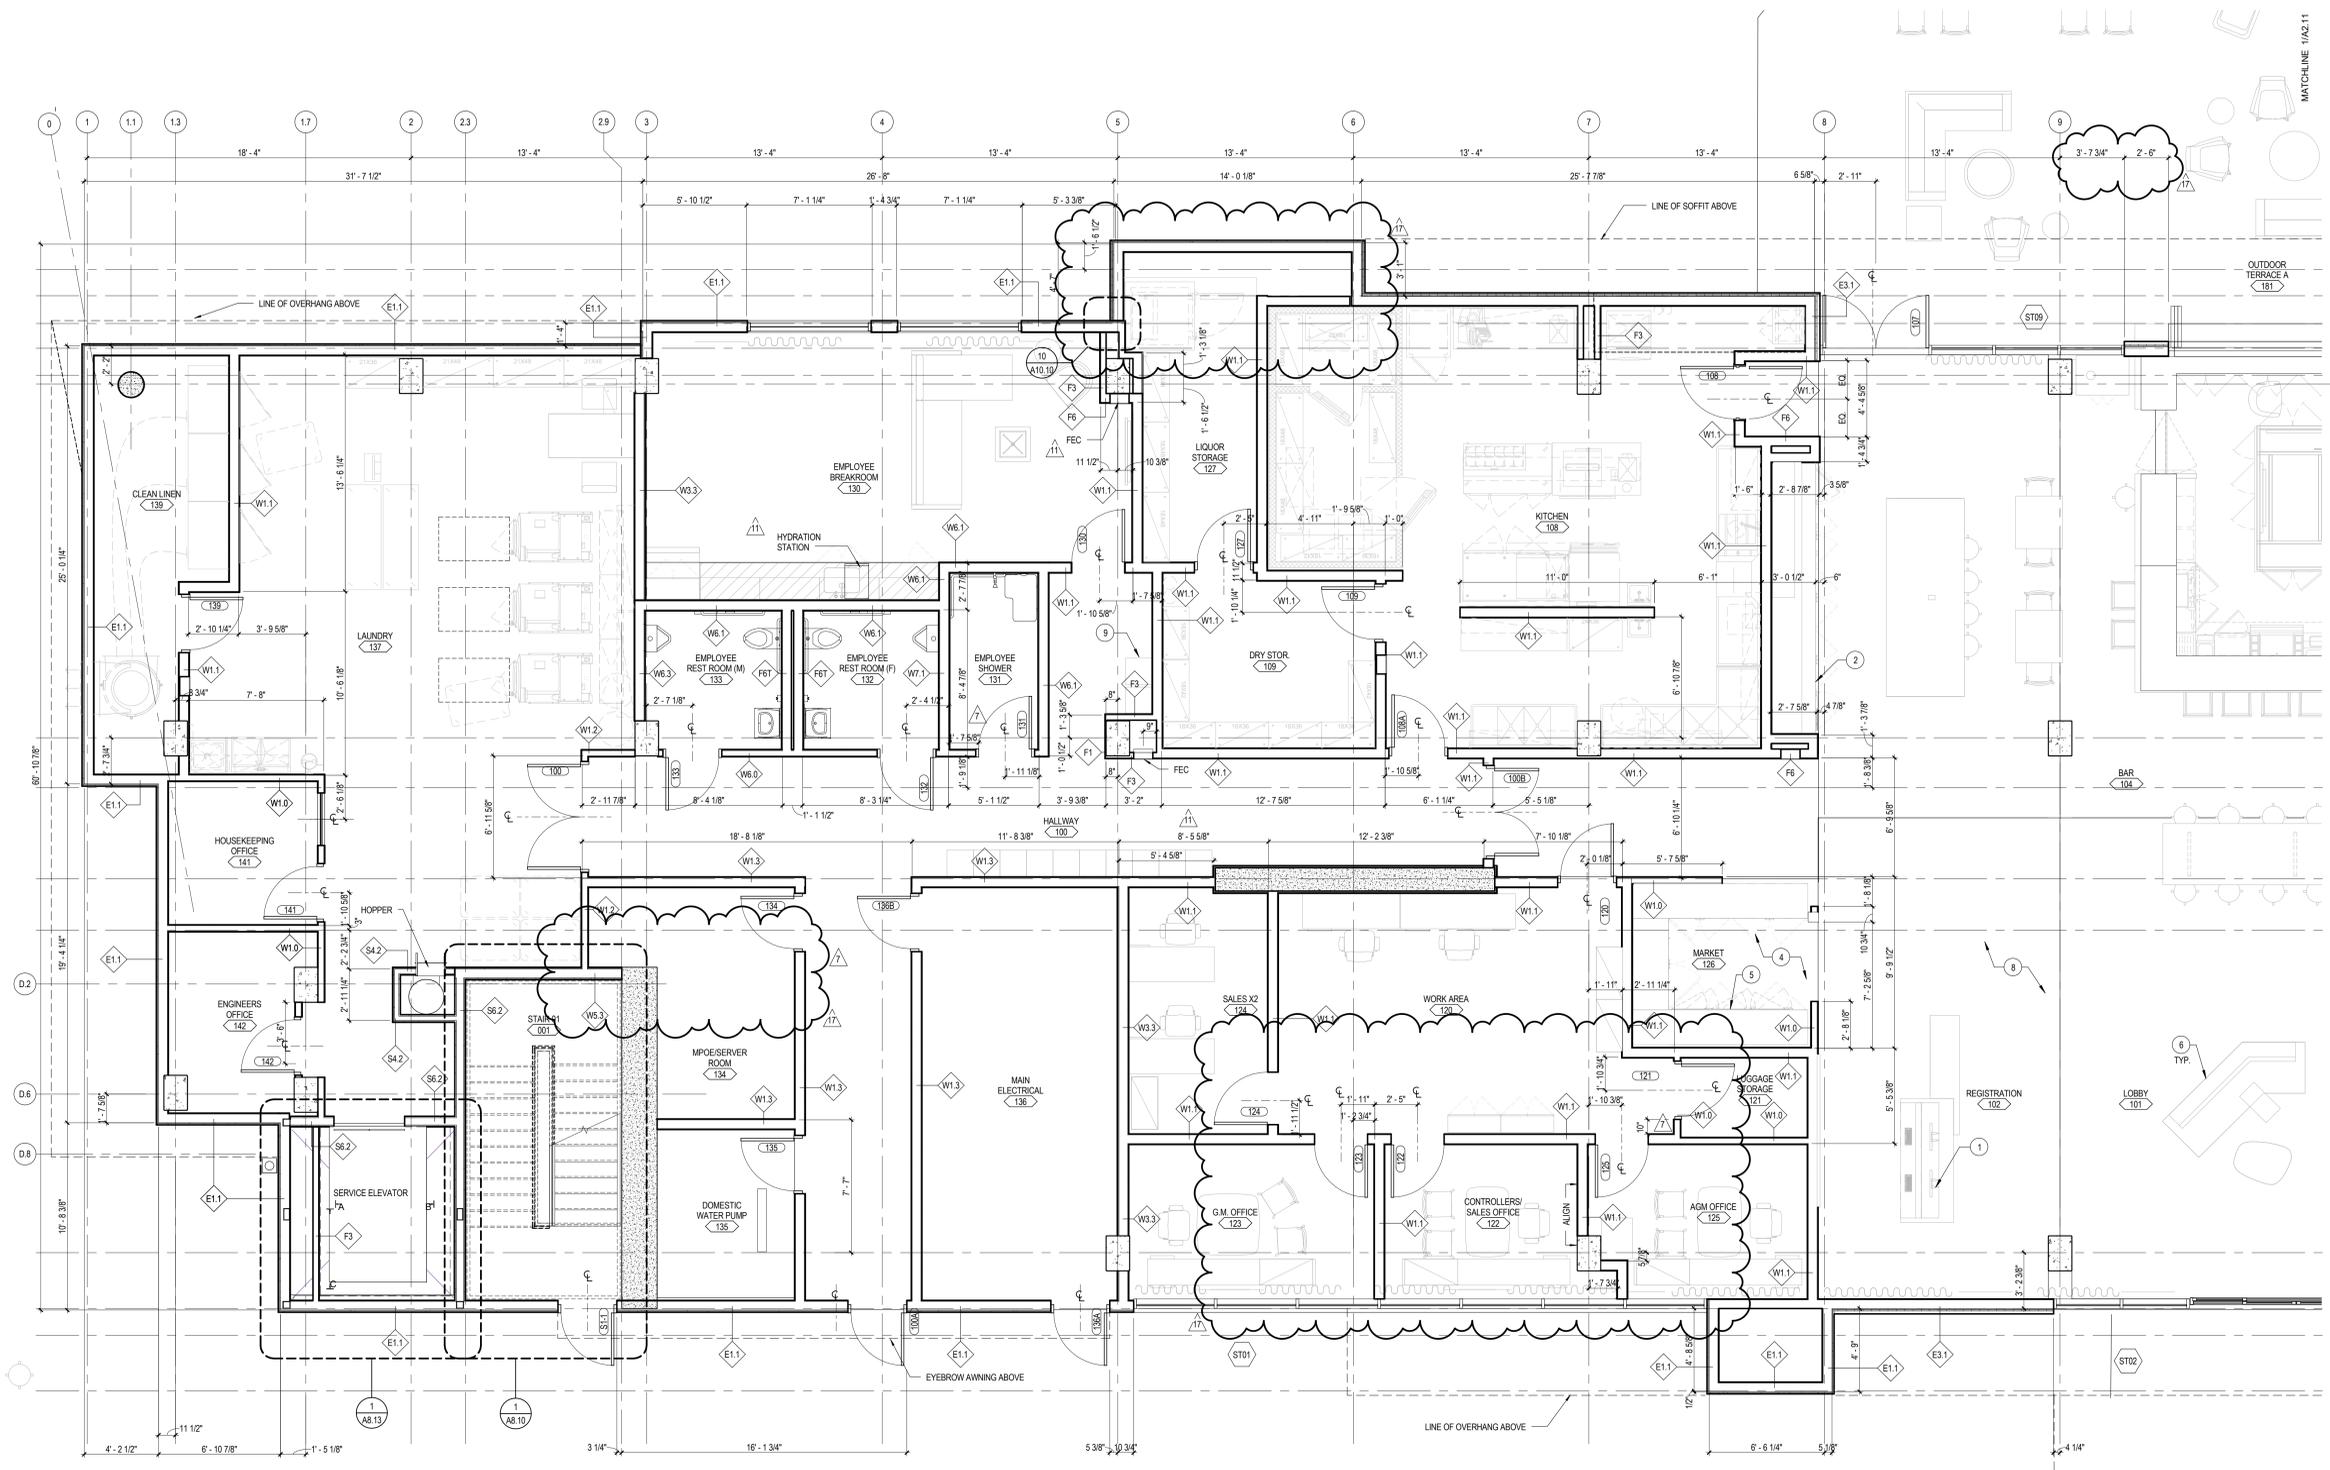

BUILDING PLAN NOTES

- A. THIS BUILDING SHALL BE PROTECTED WITH AN NFPA-13 AUTOMATIC SPRINKLER SYSTEM. REFER TO FIRE SPRINKLER DRAWINGS BY OTHERS. PLANS FOR ALL FIXED FIRE PROTECTION EQUIPMENT SHALL BE SUBMITTED TO THE FIRE MARSHALL FOR APPROVAL PRIOR TO INSTALLATION.
- B. THIS BUILDING SHALL HAVE AN APPROVED MANUAL AND AUTOMATIC FIRE ALARM SYSTEM DESIGNED TO WARN THE OCCUPANTS OF THE BUILDING IN THE EVENT OF A FIRE. WHEN SERVING MORE THAN 100 SPRINKLER HEADS, AUTOMATIC SPRINKLER SYSTEMS SHALL BE SUPERVISED BY AN APPROVED CENTRAL PROPRIETARY OR REMOTE STATION SERVICE, OR SHALL BE PROVIDED WITH A LOCAL ALARM WHICH WILL GIVE AN AUDIBLE SIGNAL AT A CONSTANTLY ATTENDED LOCATION.
- C. EACH GUESTROOM SHALL HAVE PERMANENTLY WIRED SMOKE DETECTORS WITH BATTERY BACKUP INSIDE EACH BEDROOM AND CENTRALLY LOCATED IN THE GUESTROOM HALLWAY OR AREA GIVING ACCESS TO SLEEPING AREAS. DETECTORS SHALL SOUND AN ALARM AUDIBLE IN ALL SLEEPING AREAS OF THE UNIT.
- D. INTERIOR FINISHES SHALL COMPLY WITH 2013 CBC CHAPTER 8. REFER TO INTERIOR DESIGNER PLANS FOR LOCATIONS AND SPECIFICATIONS OF ALL INTERIOR FINISHES.
- E. RECESSED FIXTURES SUCH AS MALBOWS, MEDICINE CABINETS, FIRE EXTINGUISHER CABINETS AND ELECTRICAL OUTLET PANELS EXCEEDING 16 SQUARE INCHES IN AREA, AS WELL AS BEHIND BATHTUB AND SHOWER ENCLOSURES SHALL BE LINED W/ 5/8" TYPE X GYP BD (CBC 709.6 OR 709.7)
- F. FIRE PROTECTION REQUIRED FOR COMMERCIAL COOKING EQUIPMENT. FIRE PROTECTION PLANS TO BE SUBMITTED TO FIRE DEPARTMENT FOR SEPARATE REVIEW AND APPROVAL.

TACTILE EXIT SIGNS

- 1. REFER TO SHEET 00.9 FOR SPECIFIC DETAILED INFORMATION AND REQUIREMENTS.
- 2. EACH GRADE LEVEL EXIT DOOR SHALL BE IDENTIFIED BY THE WORD "EXIT"
- 3. EACH DOOR THAT LEADS DIRECTLY TO A GRADE LEVEL EXTERIOR EXIT BY THE MEANS OF AN EXIT STAIR SHALL BE IDENTIFIED WITH THE WORDS "EXIT STAIR DOWN" OR "EXIT STAIR UP" BASED ON APPROPRIATE DIRECTION.
- 4. EACH EXIT DOOR THAT LEADS DIRECTLY TO A GRADE LEVEL EXTERIOR EXIT BY MEANS OF AN EXIT ENCLOSURE THAT DOES NOT UTILIZE A STAIR OR RAMP SUCH AS RATED CORRIDORS, OR BY MEANS OF AN EXIT PASSAGEWAY SHALL BE IDENTIFIED WITH THE WORDS "EXIT DOOR"
- 5. EACH EXIT ACCESS DOOR FROM INTERIOR ROOM OR AREA THAT IS REQUIRED TO HAVE A VISUAL EXIT SIGN, SHALL BE IDENTIFIED WITH THE WORDS "EXIT ROUTE"

EMPLOYEE LOCKERS

- 1. 5% BUT NOT LESS THAN 1 OF THE EMPLOYEE LOCKERS TO BE ACCESSIBLE PER CBC 11B-222.1
- 2. PROVIDE CLEAR FLOOR SPACE PER CBC 11B-811.2
- 3. HEIGHT OF THE STORAGE ELEMENT SHALL COMPLY WITH ONE OF THE REACH RANGES PRESCRIBED IN CBC 11B-308 PER CBC 11B-811.3
- 4. OPERABLE PARTS THAT ARE OPERABLE WITH ONE HAND AND DO NOT REQUIRE TIGHT GRASPING, PINCHING, OR TWISTING OF THE WRIST PER CBC 11B-309.4
- 5. THE FORCE REQUIRED TO ACTIVATE OPERABLE PARTS SHALL BE 5-POUNDS MAX. PER CBC 11B-309.4

ENLARGED PLAN KEYNOTES

- 1 RECEPTION DESK, PER ID DRAWINGS
- 2 GAS-FIRED FIREPLACE, PER ID DRAWINGS
- 3 BUFFET CASEWORK, PER ID DRAWINGS
- 4 MARKET EQUIPMENT, PER KITCHEN DRAWINGS
- 5 MARKET CASEWORK, PER ID DRAWINGS
- 6 FURNITURE, PER INTERIOR DESIGN PLANS
- 7 HYDRATION STATION W/ 27" MIN. KNEE SPACE BELOW
- 8 FINISH FLOOR, PER ID DRAWINGS
- 9 LOCKERS

1 ENLARGED FLOOR PLAN - FIRST LEVEL - AREA A
A2.10 SCALE: 1/4" = 1'-0"



HOTEL ONLY
SUBMITTAL

AC MARRIOTT HOTEL
2970 LAKESIDE DRIVE
SANTA CLARA, CALIFORNIA

ENLARGED PLAN - 1ST LEVEL - AREA A




DLR Group
Architecture Engineering Planning Interiors
© 2015, DLR Group, Inc., a California corporation. ALL RIGHTS RESERVED.

75-15746-00
07/26/2017
Revisions

7 HOTEL ONLY SUBMITTAL 07/26/2017
11 HOTEL ONLY RESUBMITTAL 11/03/2017
17 BULLETIN #3 LEVEL 1 04/23/2018
REVISIONS & DOOR HARDWARE

A2.10

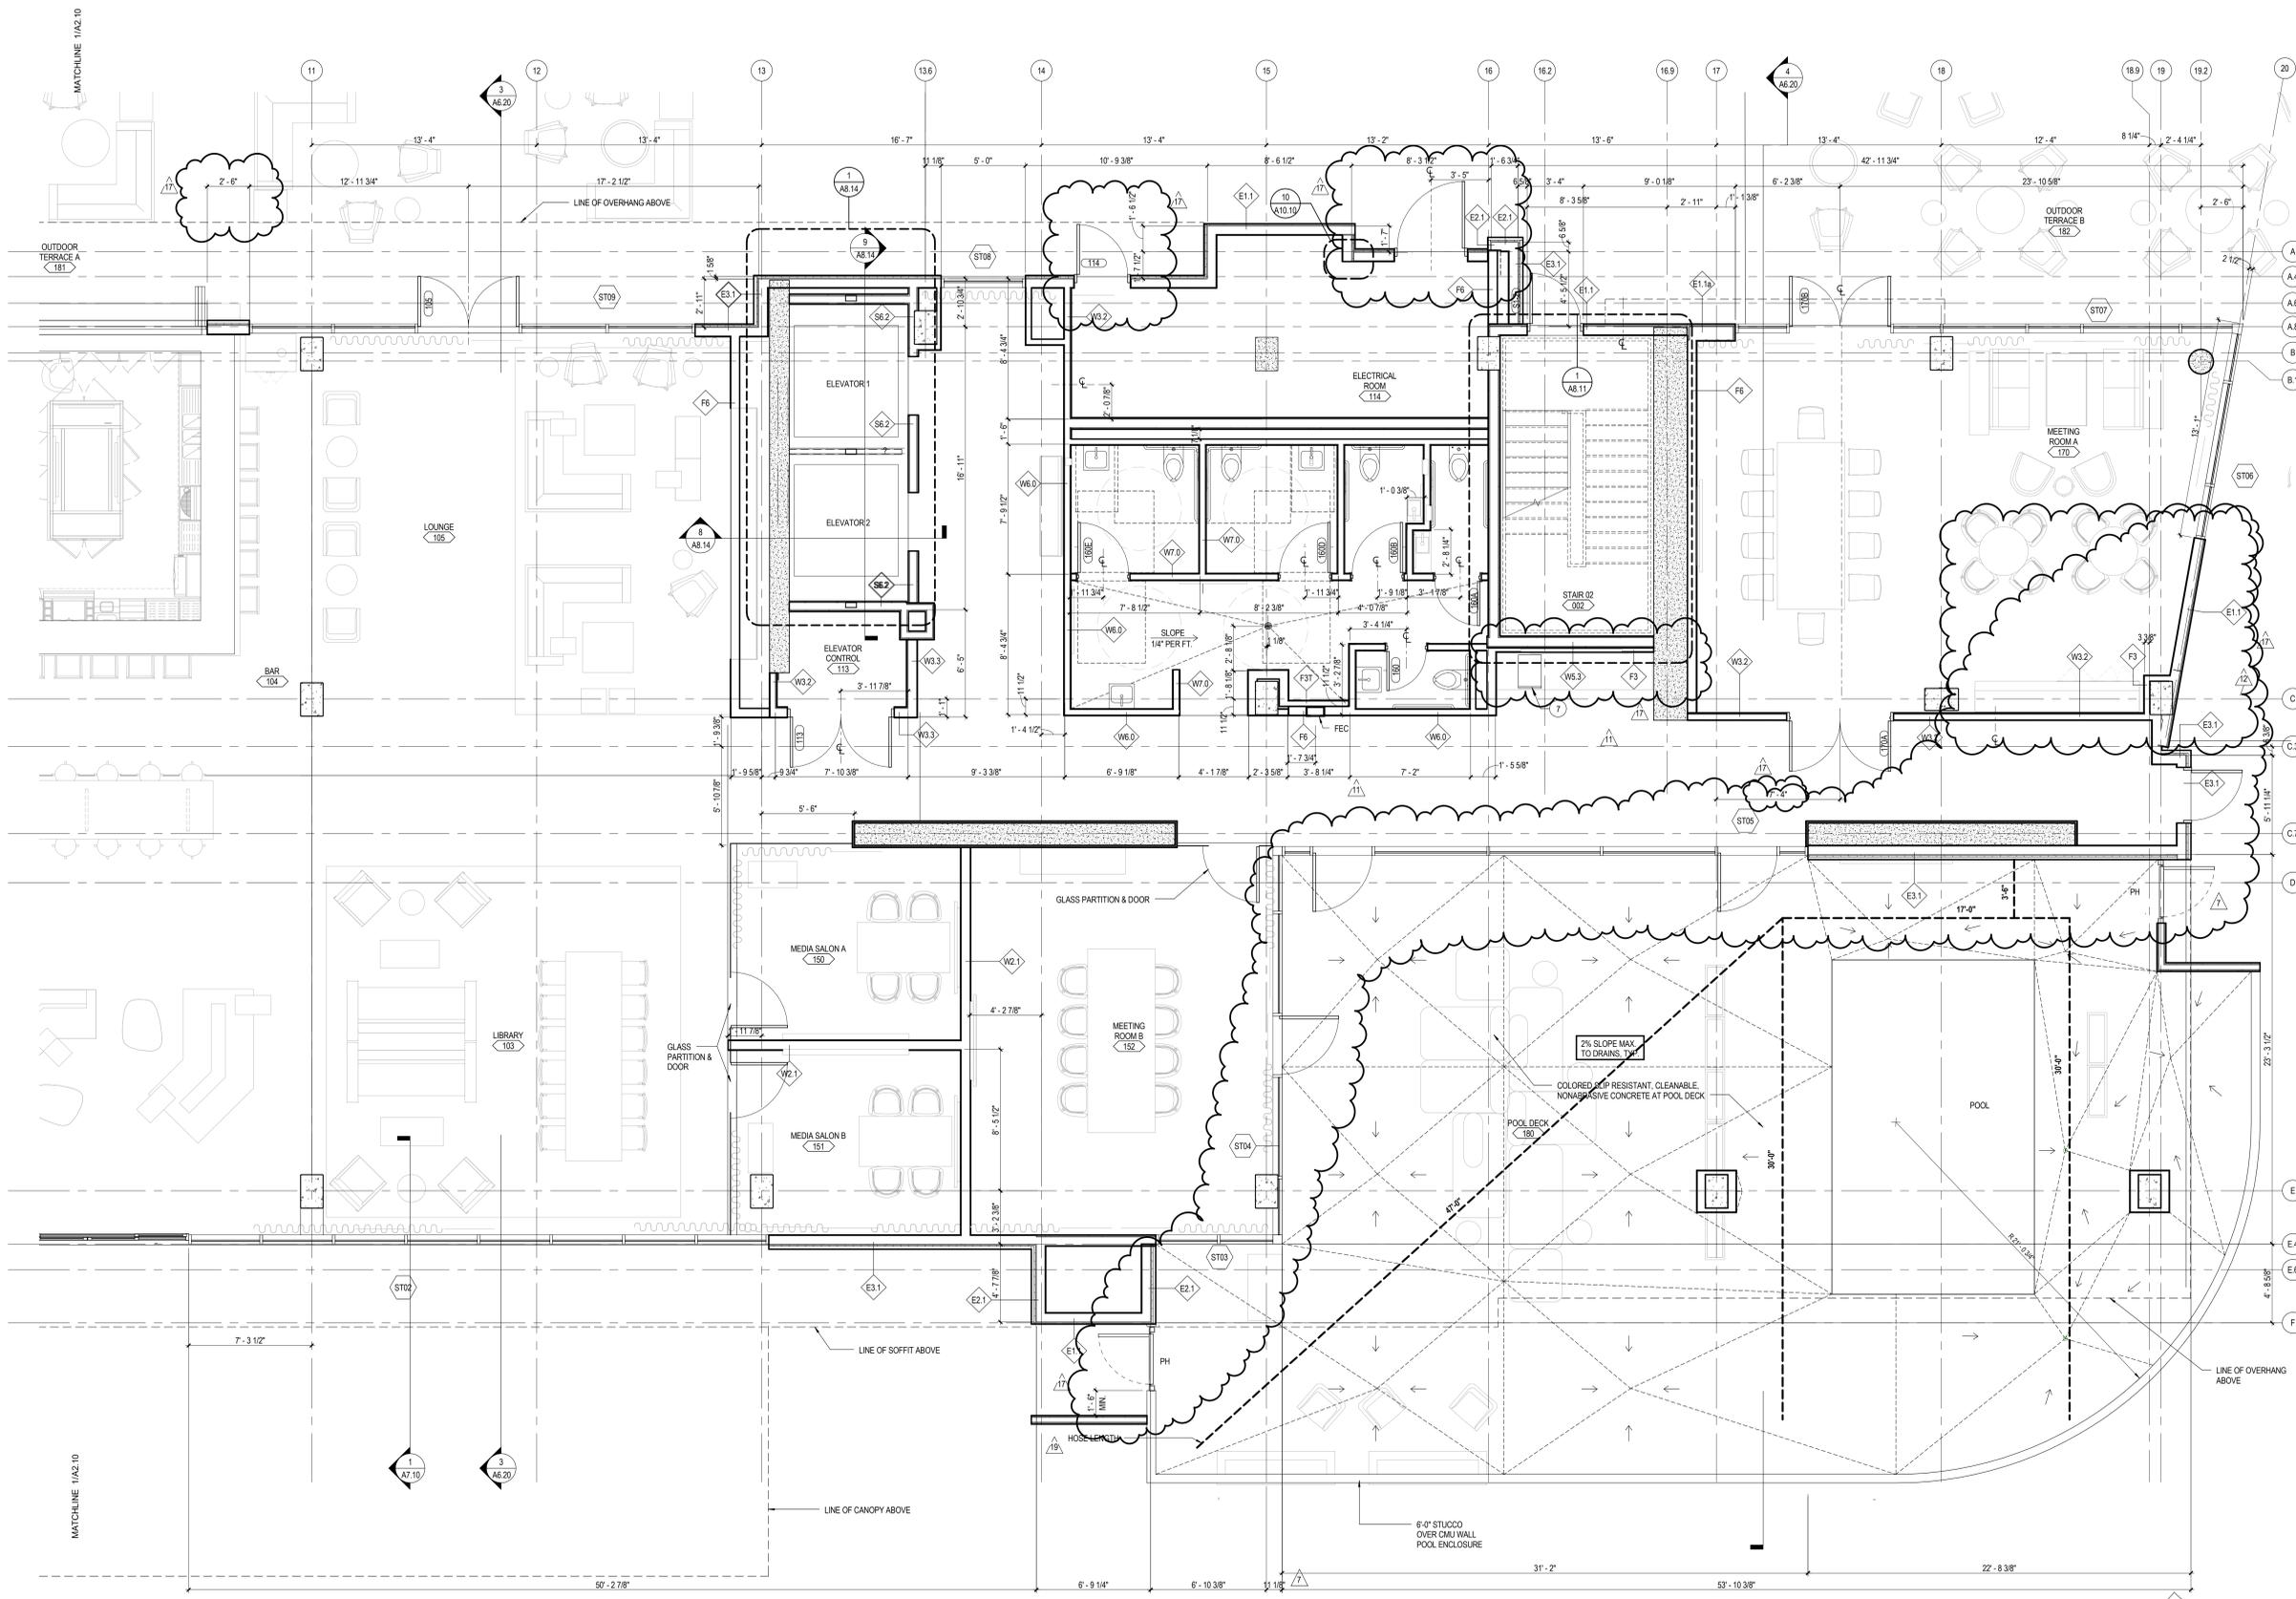

1 ENLARGED FLOOR PLAN - FIRST LEVEL - AREA B
SCALE: 1/4" = 1'-0"

BUILDING PLAN NOTES

- A. THIS BUILDING SHALL BE PROTECTED WITH AN NFPA-13 AUTOMATIC SPRINKLER SYSTEM. REFER TO FIRE SPRINKLER DRAWINGS BY OTHERS. PLANS FOR ALL FIXED FIRE PROTECTION EQUIPMENT SHALL BE SUBMITTED TO THE FIRE MARSHALL FOR APPROVAL PRIOR TO INSTALLATION.
- B. THIS BUILDING SHALL HAVE AN APPROVED MANUAL AND AUTOMATIC FIRE ALARM SYSTEM DESIGNED TO WARN THE OCCUPANTS OF THE BUILDING IN THE EVENT OF A FIRE. WHEN SERVING MORE THAN 100 SPRINKLER HEADS, AUTOMATIC SPRINKLER SYSTEMS SHALL BE SUPERVISED BY AN APPROVED CENTRAL PROPRIETARY OR REMOTE STATION SERVICE, OR SHALL BE PROVIDED WITH A LOCAL ALARM WHICH WILL GIVE AN AUDIBLE SIGNAL AT A CONSTANTLY ATTENDED LOCATION.
- C. EACH GUESTROOM SHALL HAVE PERMANENTLY WIRED SMOKE DETECTORS WITH BATTERY BACKUP INSIDE EACH BEDROOM AND CENTRALLY LOCATED IN THE GUESTROOM HALLWAY OR AREA GIVING ACCESS TO SLEEPING AREAS. DETECTORS SHALL SOUND AN ALARM AUDIBLE IN ALL SLEEPING AREAS OF THE UNIT.
- D. INTERIOR FINISHES SHALL COMPLY WITH 2013 CBC CHAPTER 8. REFER TO INTERIOR DESIGNER PLANS FOR LOCATIONS AND SPECIFICATIONS OF ALL INTERIOR FINISHES.
- E. RECESSED FIXTURES SUCH AS MALBOWS, MEDICINE CABINETS, FIRE EXTINGUISHER CABINETS AND ELECTRICAL OUTLET PANELS EXCEEDING 16 SQUARE INCHES IN AREA, AS WELL AS BEHIND BATHTUB AND SHOWER ENCLOSURES SHALL BE LINED W/ 5/8" TYPE X GYPSUM BOARD (CBC 709.6 OR 709.7).
- F. FIRE PROTECTION REQUIRED FOR COMMERCIAL COOKING EQUIPMENT. FIRE PROTECTION PLANS TO BE SUBMITTED TO FIRE DEPARTMENT FOR SEPARATE REVIEW AND APPROVAL.

TACTILE EXIT SIGNS

- 1. REFER TO SHEET G0.9 FOR SPECIFIC DETAILED INFORMATION AND REQUIREMENTS.
- 2. EACH GRADE LEVEL EXIT DOOR SHALL BE IDENTIFIED BY THE WORD "EXIT".
- 3. EACH DOOR THAT LEADS DIRECTLY TO A GRADE LEVEL EXTERIOR EXIT BY THE MEANS OF AN EXIT STAIR SHALL BE IDENTIFIED WITH THE WORDS "EXIT STAIR DOWN" OR "EXIT STAIR UP" BASED ON APPROPRIATE DIRECTION.
- 4. EACH EXIT DOOR THAT LEADS DIRECTLY TO A GRADE LEVEL EXTERIOR EXIT BY MEANS OF AN EXIT ENCLOSURE THAT DOES NOT UTILIZE A STAIR OR RAMP SUCH AS RATED CORRIDORS, OR BY MEANS OF AN EXIT PASSAGEWAY SHALL BE IDENTIFIED WITH THE WORDS "EXIT ROUTE".
- 5. EACH EXIT ACCESS DOOR FROM INTERIOR ROOM OR AREA THAT IS REQUIRED TO HAVE A VISUAL EXIT SIGN, SHALL BE IDENTIFIED WITH THE WORDS "EXIT ROUTE".

EMPLOYEE LOCKERS

- 1. 5% BUT NOT LESS THAN 1 OF THE EMPLOYEE LOCKERS TO BE ACCESSIBLE PER CBC 11B-222.1
- 2. PROVIDE CLEAR FLOOR SPACE PER CBC 11B-811.2
- 3. HEIGHT OF THE STORAGE ELEMENT SHALL COMPLY WITH ONE OF THE REACH RANGES PRESCRIBED IN CBC 11B-308 PER CBC 11B-811.3
- 4. OPERABLE PARTS THAT ARE OPERABLE WITH ONE HAND AND DO NOT REQUIRE TIGHT GRASPING, PINCHING, OR TWISTING OF THE WRIST PER CBC 11B-309.4
- 5. THE FORCE REQUIRED TO ACTIVATE OPERABLE PARTS SHALL BE 5-POUNDS MAX. PER CBC 11B-309.4

ENLARGED PLAN KEYNOTES

- 1 RECEPTION DESK, PER ID DRAWINGS
- 2 GAS-FIRED FIREPLACE, PER ID DRAWINGS
- 3 BUFFET CASEWORK, PER ID DRAWINGS
- 4 MARKET EQUIPMENT, PER KITCHEN DRAWINGS
- 5 MARKET CASEWORK, PER ID DRAWINGS
- 6 FURNITURE, PER INTERIOR DESIGN PLANS
- 7 HYDRATION STATION W/ 27" MIN. KNEE SPACE BELOW
- 8 FINISH FLOOR, PER ID DRAWINGS
- 9 LOCKERS

HOTEL ONLY
SUBMITTAL

AC MARRIOTT HOTEL
2970 LAKESIDE DRIVE
SANTA CLARA, CALIFORNIA

ENLARGED PLAN - 1ST LEVEL - AREA B



DLR Group
Architecture Engineering Planning Interiors
© 2016, DLR Group, Inc., a California corporation. ALL RIGHTS RESERVED.

75-15746-00
07/26/2017
Revisions

- 7 HOTEL ONLY SUBMITTAL 07/26/2017
- 11 HOTEL ONLY RESUBMITTAL 11/03/2017
- 12 HOTEL ONLY RESUBMITTAL 01/23/2018
- 13 HOTEL ONLY RESUBMITTAL 01/23/2018
- 14 HEALTH POOL PLAN CHECK 03/16/2018
- 15 BULLETIN #3 LEVEL 1 04/23/2018
- 16 REVISIONS & DOOR HARDWARE
- 19 HEALTH POOL PLAN CHECK 05/23/2018

A2.11