

T.I. - TAPSILOG BISTRO

SANTA CLARA, CA

REV. DATE NO.
12/27/19 1

GENERAL NOTES


1. ALL DOCUMENTS ADOT, LATEST ADDITION ISSUED BY THE AMERICAN INSTITUTE OF ARCHITECTS, "GENERAL CONDITIONS FOR THE PERFORMANCE OF A CONTRACT" ARE HEREBY INCORPORATED INTO THESE DRAWINGS AND SHALL BE CONSIDERED AS PART OF THE REQUIREMENTS FOR THE COMPLETION OF WORK.
2. ALL PERMITS REQUIRED BY THE CITY AND STATE AGENCIES SHALL BE APPLIED FOR AND OBTAINED BY THE CONTRACTOR AT HIS/HER SOLE EXPENSE.
3. ALL CONSTRUCTION WORK SHALL BE PROVIDED IN ACCORDANCE WITH ALL LOCAL, STATE, AND FEDERAL CODES, WITH THE MOST STRINGENT ALWAYS APPLYING.
4. THE CONTRACTOR SHALL IMMEDIATELY EXAMINE ALL PORTIONS OF THE SITE AFFECTING THIS PROJECT, AND BASE HIS/HER BID ON EXISTING CONDITIONS. ALL CONFLICTS OR OMISSIONS IN THE DRAWINGS SHALL BE REPORTED TO THE ARCHITECT AT THIS TIME. NO ALLOWANCE SHALL BE MADE FOR EXTRA EXPENSES TO THE CONTRACTOR DUE TO HIS/HER FAILURE TO COMPLY WITH THIS REQUIREMENT AND TO THOROUGHLY CONDUCT THIS EXAMINATION.
5. THE CONTRACTOR SHALL CONFIRM IN WRITING IMMEDIATELY FOLLOWING AWARDING OF THE JOB THE DELIVERY DATES OF ALL CONSTRUCTION MATERIALS REQUIRED BY THESE DRAWINGS. ANY MATERIALS WHOSE UNAVAILABILITY WILL AFFECT A DELAY IN AGREED-UPON OCCUPANCY SHALL BE BROUGHT TO THE ATTENTION OF THE DESIGNER AT START OF WORK.
6. ANY REQUEST FOR THE SUBSTITUTION OF SPECIFIED MATERIALS SHALL BE MADE TO THE DESIGNER IN WRITING WITH THE PROPER TIME FOR REVIEW OF EQUAL QUALITY AND PERFORMANCE, AND SHALL NOT BE PURCHASED WITHOUT WRITTEN APPROVAL.
7. THE CONTRACTOR IS RESPONSIBLE FOR THE COORDINATION OF ALL SUBCONTRACTORS AND SHALL SCHEDULE ALL WORK TO MEET AGREED UPON COMPLETION DATES.
8. CONTRACTORS SHALL PROTECT ALL EXISTING AREAS WITH FRAGILE EQUIPMENT FROM DAMAGE THROUGHOUT TIME OF CONSTRUCTION. AT OWNER'S REQUEST, CONTRACTOR SHALL ERECT A TEMPORARY ENCLOSURE OR PLASTIC SCREEN.
9. CONTRACTOR SHALL KEEP JOB SITE CLEAN OF DIRT, DEBRIS, AND DUST WHICH COULD AFFECT FINISHED AREAS IN OR OUT OF JOB SITE, AND SHALL BE RESPONSIBLE FOR THE STORAGE AND REMOVAL OF RUBBISH ON A REGULAR BASIS.
10. CONTRACTOR SHALL LEAVE PREMISES CLEAN AT THE COMPLETION OF WORK. CONTRACTOR SHALL PROVIDE PROFESSIONAL CLEANING SERVICES OF AREA INCLUDING WINDOWS, CABINETS, CABINETS, AND WALLS.
11. ALL DIMENSIONS ARE GIVEN FROM FACE TO FINISH UNLESS OTHERWISE NOTED. NO DIMENSIONS SHALL BE SCALED FROM DRAWINGS. NO DIMENSIONS ARE TO BE ADJUSTED WITHOUT WRITTEN APPROVAL OF THE DESIGNER.
12. ALL WORK TO BE ACCEPTABLE. MUST BE IN COMPLIANCE WITH THESE DRAWINGS AND SPECIFICATIONS, AND MUST BE OF A QUALITY EQUAL TO OR BETTER THAN THE STANDARDS OF THE TRADE. FINISHED WORK SHALL BE FIRM, WELL-ANCHORED, IN TRUE ALIGNMENT, PLUMB, LEVEL, WITH SMOOTH, CLEAN, & UNIFORM APPEARANCE.
13. CONTRACTOR SHALL SUBMIT SHOP DRAWINGS TO DESIGNER OF ALL FABRICATED ITEMS SUCH AS CABINETS, GLAZING, CURT SHEETS OF EQUIPMENT AND SAMPLES OF ACTUAL FINISH MATERIALS FOR APPROVAL PRIOR TO INSTALLATION.
14. CONTRACTOR TO PROVIDE BLOCKING BEHIND ALL ELEMENTS REQUIRING SUPPORT. REVIEW REQUIREMENTS WITH DESIGNER.
15. CONTRACTOR TO COORDINATE INSTALLATION OF N.I.C. ITEMS WITH OTHER TRADES.
16. A COMPLETE SET OF STAMPED APPROVED PLANS MUST BE ON THE JOB SITE.
17. ALL CONTRACTORS & SUBCONTRACTORS MUST HAVE VALID CURRENT BUSINESS LICENSES BEFORE RECEPTIONS CAN BE MADE.
18. ALL WORK SHALL REMAIN EXPOSED FOR INSPECTION. THIS INCLUDES BUILDING CONSTRUCTION AND DEFERRED FIRE PERMITS. IF ADEQUATE EXPOSURE IS NOT PROVIDED FOR INSPECTION PURPOSES, THERE MAY BE DELAYS IN GRANTING TOO OR FINALIZATION OF PERMITS.

SANTA CLARA FIRE DEPT. NOTES/SEPARATE PERMITS REQUIRED DIRECTLY WITH SCFD

THE FOLLOWING ITEMS SHALL BE SEPARATE PERMITS APPLIED DIRECTLY TO THE SANTA CLARA FIRE DEPT.:

1. AUTOMATIC SPRINKLER SYSTEM (MODIFICATIONS)
2. FIRE ALARM SYSTEM
3. REFRIGERATION SYSTEM
4. COOKING OIL STORAGE TANKS (EXCEEDING 60 GALLONS)
5. HOOD/DUCT FIRE SUPPRESSION SYSTEM
6. CARBON DIOXIDE BEVERAGE SYSTEMS (EXCEEDING 100 LBS)
7. INVERTER BATTERIES (IF APPLICABLE)
8. HOOD/ANULUS SYSTEM IS A DEFERRED SUBMITTAL FOR FIRE DEPT. PURPOSES.
9. ALL HVAC UNITS ABOVE 2,000 CFM SHALL BE REQUIRED TO BE PROVIDED WITH DUCT SMOKE DETECTION AND SHALL BE REQUIRED TO BE CONNECTED TO THE FIRE ALARM SYSTEM.

SITE PLAN SCALE: 1/16" = 1'-0"

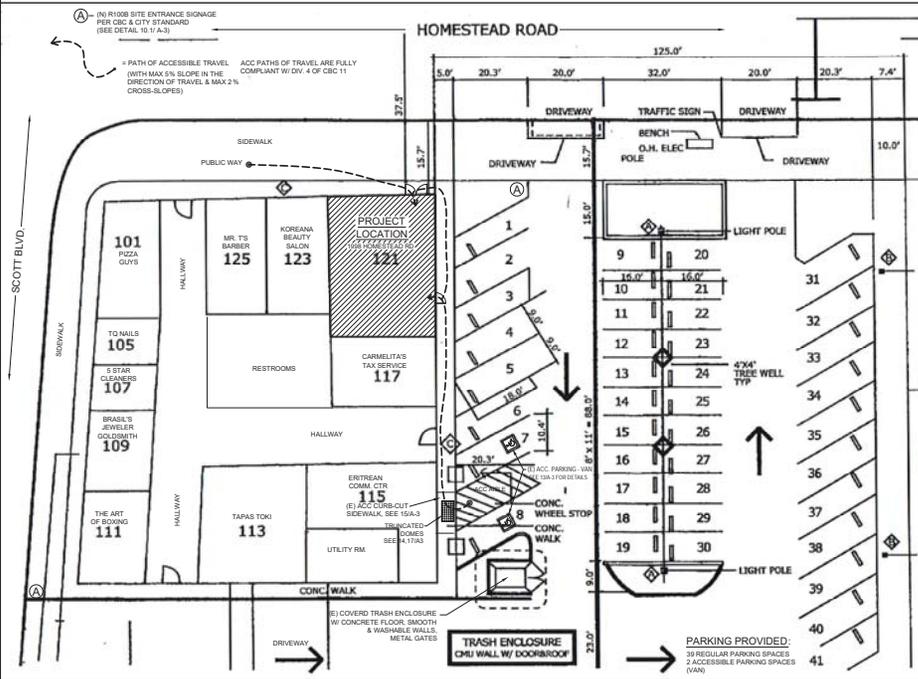

PROJECT DATA DESCRIPTION

Area: 1,200 SQ. FT. INTERIOR TENANT SPACE (WALLS NOT INCLUDED)
 Construction Type: TYPE V-B, 1 STORY
 Sprinkler System: NONE
 Existing Use: VACANT (FORMER MESSAGE - GOLDEN BAY SPA)
 Proposed Use: RESTAURANT (FILIPINO)
 Disability Guidelines: THIS FACILITY WILL CONFORM TO ALL REQUIREMENTS OF CBC 11B DIVISION 6
 Title 24: LIGHTING & AREA VENTILATION TO REMAIN THE SAME
 Occupancy Load: GROUP B OCCUPANCY, OCC. LOAD 36 LESS THAN 50 - ONE EXIT REQ. TWO PUBLIC EXITS AVAILABLE

OCCUPANCY LOAD FACTOR CHART

ROOMS	FUNCTION	OCCUPANT LOAD FACTOR	PERMITTED OCCUPANCY	OCCUPANT LOAD
DRIVING AREA	DRIVING	10	36	36
MECHANICAL ROOM	MECHANICAL	10	36	36
STORAGE	STORAGE	10	36	36
RESTROOM	RESTROOM	10	36	36
OFFICE	OFFICE	10	36	36
RECEPTION	RECEPTION	10	36	36
WAITING	WAITING	10	36	36
STAIR	STAIR	10	36	36
TRASH	TRASH	10	36	36
UTILITY	UTILITY	10	36	36
MECHANICAL	MECHANICAL	10	36	36
STORAGE	STORAGE	10	36	36
RESTROOM	RESTROOM	10	36	36
OFFICE	OFFICE	10	36	

(E) 1 HR RATED DEMIZING WALLS

WALLS AND INTERIOR PARTITIONS, NONCOMBUSTIBLE

GA FILE NO. WP 1589 **GENERIC**

1 HOUR FIRE **36 to 39 ETC BOUND**


Thickness: 4.78" 4.78" p.f.d.
Approx. Weight: FM RP-45, 6-15-86;
Fire Test: GSI T-170, 8-61;
ULC 207-84, 12-15-80;
ULC 207-84, 12-15-80;
ULC Design W415
MCC 200-84, 6-15-83
RAL T-05-114, 4-11-86

One layer 5/8" type X gypsum wallboard or gypsum veneer base applied parallel to or at right angle each side of 3 5/8" steel studs 24" o.c. with 1" type D drywall covers 2" o.c. at vertical joints and 12" o.c. at floor and ceiling corners and intermediate studs.

Joints staggered 24" on opposite sides. **BLB**



Sound Test:

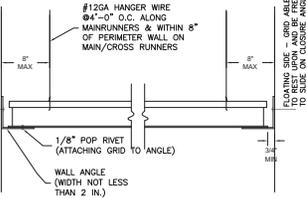

1. THE UNATTACHED PERIMETER SHALL HAVE A MINIMUM OF 5/4" CLEARANCE AT ENDS OF COMPONENTS.
2. PERIMETER TERMINAL COMPONENT ENDS MUST BE SUPPORTED BY A 12 GA. WIRE ON ALL WALLS.

1 CEILING GRID SUSPENSION (@ NEW WALLS)

N.T.S.

EQUIPMENT SCHEDULE


Item No	Qty	Equipment Category	Manufacturer	Model Number	Equipment Remarks	Equipment Weights
1	1	FRYER, DEEP FAT, GAS	AMERICAN RANGE	AF35/50	SEE NOTE 9 & 14	163lb*
1	1	GRIDDLE, RESTAURANT, GAS	AMERICAN RANGE	AR-6C	SEE NOTE 9, SEE DETAIL 5/S1	420lb*
3.1	1	RIDDLE 3', GAS	AMERICAN RANGE	AEMG-36	SEE NOTE 9	300lb on #5
3.2	1	GRIDDLE 2', GAS	AMERICAN RANGE	AEMG-24	SEE NOTE 9	220lb on #5
4	2	STOVE, STOCK POT	AMERICAN RANGE	ARRP-12-2	SEE NOTE 9	85lb
4.1	1	STAND, EQUIPMENT	TURBO AIR	TSE-3036	SEE NOTE 9	47lb
5	1	FREEZER, SHORTY	DELFIELD	F2660	SEE NOTE 9, SEE DETAIL 5/S1	138lb*
6	1	TABLE, HOT FOOD	DUKE MANUFACTURING	E304		
7	1	REFRIGERATOR, SANDWICH/SALAD PREP	TRUE FOOD SERVICE	TSSU-48-12	SEE NOTE 4	310lb*
8	1	FREEZER, WORKTOP	TRUE FOOD SERVICE	FW-27F	SEE NOTE 4	210lb*
9	1	ICE MAKER, 1/2C W/BIN	MANTOVAC ICE	MY0190A		193lb
10	2	SINK, HAND, WALL MOUNT	KROHNE	HS-22	SEE NOTE 6	
12	1	SINK, PREP	TURBO AIR	TS1-1-12-R1	SEE NOTE 15 & 6	
12	1	SINK, 3 COMP	TURBO AIR	TS3-3-12-D1	SEE NOTE 6	
13	1	SINK, MOP	GSW	SE2424FM	SEE NOTE 6	
14	1	HOT WATER HEATER	BRADFORD OR EQUAL	UL6250H553N	SEE NOTE 12	
15	2	DISPLAY CASE, REFRIGERATED	TURBO AIR	TGM-48RB	SEE NOTE 4	460lb*
16	1	WALK-IN COOLER	MASTER-BILT OR EQUAL	NWD50RL0-BYH	SEE NOTES 8, 10, 12	440lb see S1
17	1	SHELF, WALL MOUNT	EAGLE GROUP or EQUAL	SNSW1272C		
18	2	SHELVING, WIRE*	EAGLE GROUP or EQUAL	5 TIER S/S	ON CASTORS SEE NOTE 5	
19	1	TABLE, WORK	GSW	WT-PB3060		
20	1	TYPE I HOOD	ECON AIR	T61 X 4.5 W TYPE 1	SEE NOTE 7 & MECH PLANS	573lb see S2

EQUIPMENT NOTES:

1. ALL NEW EQUIPMENT TO BE NSF OR EQUAL & PROPERLY LABELED.
2. SERVICE COUNTERS TO BE MAX. 34" TALL FOR HANDICAP ACCESSIBILITY.
3. ALL EXISTING EQUIPMENT TO BE NSF APPROVED OR EQUIVALENT AND REFINISHED TO ITS ORIGINAL CONDITION.
4. EQUIP WITH HEAVY DUTY LOCKABLE CASTERS TO FACILITATE CLEANING OF FLOORS.
5. ALL STORAGE SHELVING TO HAVE MIN. 6" LEGS TO FACILITATE CLEANING OF FLOOR. NO STORAGE SHELVING TO BE IN EXCESS OF 6'0" HIGH. TOTAL LINEAR FEET OF DRY STORAGE ON WIRE SHELVING IS GREATER THAN 90 FT. (OR 20" LINEAR FEET OF WIRE SHELVING).
6. INSTALL LEVER TYPE HANDLES ON ALL SINKS AND HEAVY DUTY LIQUID SOAP AND PAPER TOWEL DISPENSERS ABOVE ALL HANDSINKS. THE CONTROLS OF ALL SINKS SHALL: (1) BE OPERABLE WITH ONE HAND AND SHALL NOT REQUIRE GRASPING, PINCHING, OR TWISTING OF THE HAND; (2) REQUIRE NO MORE THAN 5 LBS. FORCE TO ACTIVATE; & (3) BE LEVER-OPEATED, PUSH-TYPE, ELECTRONICALLY-CONTROLLED, OR SIMILAR.
7. EXHAUST AND MAKE-UP AIR WILL BE ELECTRICALLY INTERLOCKED.
8. WALK-IN REFRIGERATOR OR FREEZER MUST BE COMPLETELY FLASHED TO THE BUILDING'S WALLS AND CEILING. THE AREAS ABOVE WALK-IN UNIT MAY NOT BE USED FOR STORAGE. ANY OPENINGS FOR VENTILATION IN THE FLASHING ABOVE THE WALK-IN UNIT MUST BE SCREENED WITH AT LEAST 16 MESH SCREEN. PROVIDE 2" AIR GAP BETWEEN PANELS AND WALLS.
9. EQUIPPED BY APPROVED COMMERCIAL CASTERS (WHERE APPLICABLE) & APPROVED HEAVY DUTY QUICK-DISCONNECT FLEXIBLE GAS LINES W/ RESTRAINING CABLES. ITEMS #1 THRU #5 FOR THEIR STANDS TO BE SECURED BY T&S BATE-T-LINK APPLIANCE KIT WITH SURE-LINK RESTRAINING CABLES (SECURING TO WALLS) AND A POSI-SET WHEEL PLACEMENT SYSTEM (SEE 4S-1).
10. ALL ENCLOSED EQUIPMENT (E.G. REFRIGERATORS, FREEZERS, HOT FOOD HOLDING UNITS, OVENS, & SIMILAR EQUIPMENT) MUST HAVE ADEQUATE JOH FOOT CANSIES INTERIOR LIGHTING.
11. COLD OR HOT HOLDING EQUIPMENT USED FOR POTENTIALLY HAZARDOUS FOOD SHALL BE DESIGNED TO INCLUDE & SHALL BE EQUIPPED WITH AT LEAST ONE INTEGRAL OR PERMANENTLY AFFIXED TEMP. MEASURING DEVICE LOCATED TO ALLOW EASY VIEWING OF TEMP. DISPLAY. THIS DISPLAY MUST HAVE A SCALE, PRINTED RECORD, OR READOUT IN INCREMENTS NO GREATER THAN 2°F OVER INTENDED RANGE OF USE.
12. WATER HEATER ON A STAINLESS STEEL STAND W/ 6" HIGH LEGS & STRAPPED TO WALL FOR SAFETY.
13. METAL SPLASHGUARD WITH HEIGHT OF AT LEAST 4" THAT EXTENDS FROM THE BACK OF THE DRAINBOARD TO THE FRONT EDGE OF THE DRAINBOARD OR FULL DEPTH OF SINK FOR HAND SINKS. CORNERS OF BARRIER ARE TO BE ROUNDED.
14. 6" MIN. HIGH STAINLESS STEEL SPLASH GUARD BETWEEN FRYER AND OTHER EQUIPMENT. THE 6" HEIGHT MUST BE MEASURED FROM THE HIGHER OF THE TWO PIECES OF EQUIPMENT.
15. PREP SINK TO HAVE MIN. BOWL SIZE OF 18" X 18" X 12"

***LINEAR FEET OF DRY STORAGE SHELVING:**

- 5 TIER WIRE SHELVING (IN DRY STORAGE): 5 X (11) = 55
- 3 TIERS SHELVING IN 18" LONG LOCKABLE CABINET: 3 X (18) = 54
- 55 + 54 = 112 TOTAL LINEAR FEET DRY STORAGE

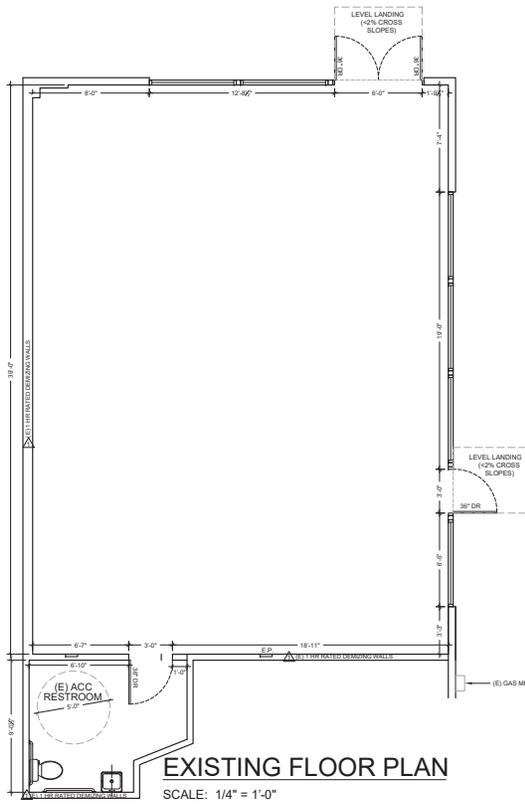

EXISTING FLOOR PLAN

SCALE: 1/4" = 1'-0"

SYMBOL KEY:


- INTERNATIONAL SYMBOL OF ACCESSIBILITY PER 2016 CBC Figure 118-703.2.1 LOCATED ON OR ADJACENT TO BLDG & ACCESSIBLE RESTROOM ENTRANCES.
- MAX. OCCUPANT LOAD SIGN LOCATION; SEE FIRE DEPT. NOTE 2.
- KEY BOX; SEE FIRE DEPT. NOTE 4.
- TACTILE EXIT SIGNAGE LOCATED ON WALL @ EACH GRADE LEVEL EXTERIOR EXIT DOOR, ON LATCH SIDE WHERE SINGLE DOORS & RIGHT SIDE WHERE DOUBLE DOORS. SEE DETAIL 6/A-3 & 2016 CBC SECTION 1013.4 & 118-703.4.2 FOR MORE DETAIL.
- LOCATION OF MIN. RATED 2A-10 BC FIRE EXTINGUISHER; SEE FIRE DEPT. NOTE 5.
- LOCATION OF CLASS K FIRE EXTINGUISHER (WITHIN 30 FT. OF ALL COMMERCIAL COOKING EQUIPMENT PER CBC 906.1)
- RED EXIT SIGN LETTERS ON WHITE BACKGROUND 120V W/ (2) 2016-1/2F LAMPS & BATTERY BACKUP. EMERGENCY LIGHT - DOUBLE CYLINDER UNITS W/ TUNGSTEN HALOGEN LAMPS, BATTERY OPERATED. SEE FIRE DEPT. NOTES 6 & 7.
- RED EXIT SIGN LETTERS ON WHITE BACKGROUND 120V W/ (2) 2016-1/2F LAMPS & BATTERY BACKUP. SEE FIRE DEPT. NOTE 7.
- TUNGSTEN HALOGEN LAMPS ONLY (NO EXIT SIGN)

FIRE DEPT. NOTES:

1. ALL EGRESS DOORS SHALL BE OPERABLE FROM THE EGRESS, WITHOUT THE USE OF A KEY OR ANY SPECIAL KNOWLEDGE OR EFFORT. KEY LOCKING HARDWARE MAY BE USED ON THE MAIN EXIT WHEN THERE IS A READILY VISIBLE, DURABLE SIGN ON OR ADJACENT TO THE DOOR STATING THE DOOR MUST REMAIN UNLOCKED WHILE THIS SPACE IS OCCUPIED PER 1016.10.3.4.2.
2. PROVIDE SIGN STATING MAXIMUM OCCUPANT LOAD BE PERMANENTLY POSTED NEAR THE MAIN EXIT FROM THE ROOM AREA. THE SIGN SHALL BE LEGIBLE WITH LETTERS THAT ARE CONTRASTING TO THE BACKGROUND.
3. SUITE NUMBER SHALL BE PLACED AT ENTRANCE TO TENANT SPACE. NUMBERS SHALL BE A MIN. OF 18" HIG. W/ 3/8" WIRE BONDLY CONTRASTED WITH THEIR BACKGROUND (CBC 501.2).
4. KEY BOX TO BE PROVIDED PER MUNICIPAL CODE. CONTACT FIRE DEPT. EXISTING KEY BOXES SHALL BE UPGRADED TO THE NEW KNOS & SYSTEM.
5. FIRE EXTINGUISHERS WITH A MIN. RATING OF 2A-10 BC SHALL BE LOCATED W/ A MAX TRAVEL DISTANCE OF 90 FT. TO ALL TENANT OR ON A FLOOR OR FLOOR BASES.
6. MEANS OF EGRESS ILLUMINATION - AT ANY TIME THE BUILDING IS OCCUPIED, THE MEANS OF EGRESS SHALL BE ILLUMINATED AT AN INTENSITY OF NOT LESS THAN 1 FT-CANDLE AT FLOOR LEVEL.
7. EXIT SIGNS - THE PATH OF TRAVEL TO AND WITHIN THE EXITS IN A BUILDING SHALL BE IDENTIFIED BY EXIT SIGNS PER 2016 CBC 1016.1.1. EXIT SIGNS SHALL BE READILY VISIBLE FROM THE DIRECTION OF APPROACH & AS NECESSARY TO INDICATE THE DIRECTION OF EGRESS TRAVEL. NO POINT SHALL BE MORE THAN 100 FT FROM THE NEAREST VISIBLE SIGN.
8. THE POWER SUPPLY FOR MEANS OF EGRESS ILLUMINATION SHALL NORMALLY BE PROVIDED BY PREMISES ELECTRICAL SUPPLY. IN THE EVENT OF ITS FAILURE, ILLUMINATION SHALL BE AUTOMATICALLY PROVIDED FROM AN EMERGENCY SYSTEM THAT WILL PROVIDE POWER FOR NOT LESS THAN 90 MINUTES.

ACCESSIBLE DINING:

- DINING AREA 510 SQ. FT. TOTAL 1 H.C. SEAT MIN PER 20 SEATS
- SEE SHEET EH-1 FOR ADDITIONAL CUSTOM COUNTER DETAILS & FINISHES. COUNTER HAVE LOCKABLE CABINET BELOW
- SEE SHEET A-3 FOR ACCESSIBILITY REQUIREMENTS.
- NO TABLE 30" HIG. 18" W 27" D 30" W x 19" D KICK SPACE UNDERNEATH

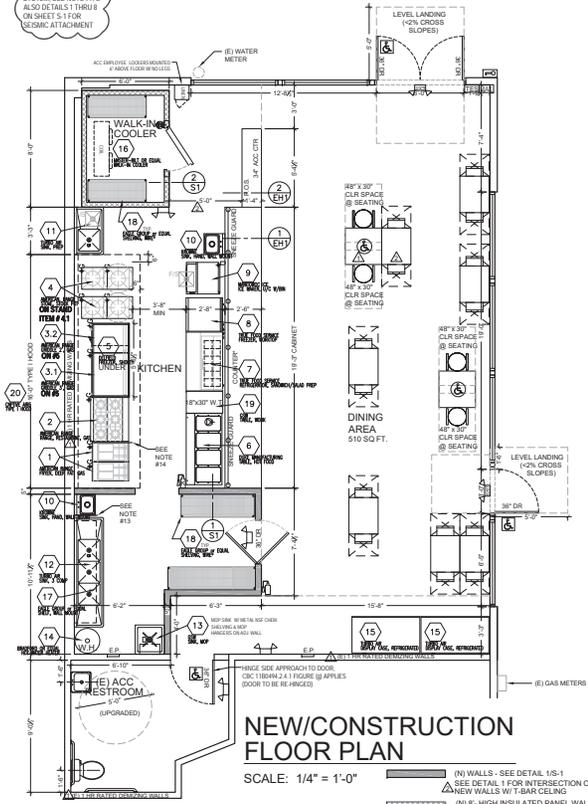

NEW/CONSTRUCTION FLOOR PLAN

SCALE: 1/4" = 1'-0"

- (N) WALLS - SEE DETAIL 1S-1
- (N) SEE DETAIL 1 FOR INTERSECTION OF NEW WALLS W/ 1" BAR CEILING
- (N) 6" HIGH INSULATED PANEL WALLS - SEE DETAIL 2S-1

REV. DATE	NO.
12/27/19	1
1/31/20	2






TAKAMI ENGINEERING GROUP, INC.
Harold E. Howell, P.E.
10414 Folger Ave., Berkeley CA 94710
510.519.0440 fax: 510.704.1975

GLENN CUNNINGHAM, DESIGNER
BULL'S EYE CADD
434.45TH AVENUE
C. (510) 301-3005
SAN FRANCISCO, CA 94112
E-MAIL: gpcadd@gmail.com

T.I. - TAPSILOG BISTRO
1998 HOMESTEAD ROAD #121
SANTA CLARA, CA 95050

Date: 10/7/19
Drawn: GOC
Sheet: **A-2**

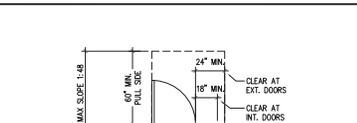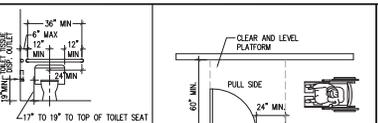
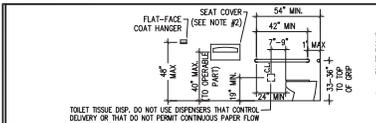


ACCESSIBILITY REQUIREMENTS

- CLEAR FLOOR OR GROUND SPACE FOR WHEELCHAIRS**
1. THE MINIMUM CLEAR FLOOR OR GROUND SPACE REQUIRED TO ACCOMMODATE A SINGLE STATIONARY WHEELCHAIR AND OCCUPANT IS 30 INCHES X 48 INCHES. THE MINIMUM CLEAR FLOOR OR GROUND SPACE FOR MULTIPLE WHEELCHAIRS OR FOR FORWARD OR PARALLEL APPROACH TO AN ACCESSIBLE CLEAR FLOOR OR GROUND SPACE FOR WHEELCHAIRS MAY BE PART OF THE MINIMUM SPACE REQUIRED UNDER OTHER CODES.
 2. PROVIDE AN ADDITIONAL 1 INCHES WITH ONE SIDE FOR ACCESS GREATER THAN 24 INCHES DEEP AND DESIGNED FOR FREQUENT ACCESS.
 3. PROVIDE AN ADDITIONAL 1 INCHES WITH ONE SIDE FOR ACCESS GREATER THAN 24 INCHES DEEP AND DESIGNED FOR FREQUENT ACCESS.
- SANITARY FACILITIES (GENERAL)**
1. ALL DOORWAYS LEADING TO SANITARY FACILITIES SHALL HAVE A MINIMUM CLEAR UNOBSTRUCTED SWING.
 2. ALL SWAMP FLOOR CONTROLS AND OPERATING MECHANISMS SHALL BE OPERABLE WITH ONE HAND AND SHALL NOT REQUIRE TWIST GRASPING, PINCHING, OR TWISTING OF THE WRIST. THE FORCE REQUIRED TO ACTIVATE CONTROLS SHALL BE NO GREATER THAN 5 LBS. USER-OPERATED FLUSH, TANK, AND ELECTRICALLY CONTROLLED MECHANISMS AND COMPLEX OF ACCEPTABLE DESIGN.
 3. A WALL WITHIN 3 FEET OF FRONT AND SIDE OF WATER CLOSETS AND URINALS SHALL HAVE A SMOOTH, NON-ABSORBENT SURFACE TO A HEIGHT OF 4 FT. ABOVE THE FLOOR PER CBC 102.2.
 4. WALLS WITHIN 3 FEET OF FRONT AND SIDE OF WATER CLOSETS AND URINALS SHALL HAVE A SMOOTH, NON-ABSORBENT SURFACE TO A HEIGHT OF FEET.
- TILET ROOM FIXTURES AND ACCESSORIES**
1. ALL ACCESSORIES SUCH AS GRAB BARS, TOWEL BARS, PAPER DISPENSER, SOAP DISP. ETC. PROVIDED ON OR WITHIN WALL SHALL BE INCLUDED AND PLACED TO PRETECT STRUCTURAL ELEMENTS FROM DAMAGE.
 2. THE HEIGHT OF ACCESSIBLE WATER CLOSETS SHALL BE A MINIMUM OF 27 INCHES AND A MAXIMUM OF 30 INCHES MEASURED TO THE TOP OF THE TOILET SEAT.
 3. CENTERLINE OF ACCESSIBLE TOILET TO BE 18" MIN. FROM THE SIDE WALL OR PARTITION.
 4. TILET AND URINAL FLUSH CONTROLS SHALL BE OPERABLE WITH ONE HAND AND SHALL NOT REQUIRE TWIST GRASPING, PINCHING, OR TWISTING OF THE WRIST. CONTROLS ON THE ELDER WALLS SHALL BE MOUNTED TO THE SIDE OF THE TOILET AND NO MORE THAN 48 INCHES ABOVE THE FLOOR. THE FORCE REQUIRED TO ACTIVATE CONTROLS SHALL BE NO GREATER THAN 5 LBS.
 5. WHERE URINALS ARE PROVIDED, AT LEAST ONE SHALL HAVE A CLEARANCE SPACE 30 INCHES WIDE X 48 INCHES DEEP IN FRONT OF THE URINAL. AT LEAST ONE SHALL HAVE A CLEARANCE SPACE 30 INCHES WIDE X 48 INCHES DEEP IN FRONT OF THE URINAL AND A MAXIMUM OF 47 INCHES ABOVE THE FLOOR SHALL BE PROVIDED. UNLESS THAT DOES NOT EXCEED THE FRONT EDGE OF THE URINAL FROM BEING PLACED UNDER THE URINAL.
 6. A CLEAR FLOOR SPACE 30 INCHES WIDE X 48 INCHES LONG SHALL BE PROVIDED IN FRONT OF LAVATORY TO ALLOW A FORWARD APPROACH. SUCH CLEAR SPACE SHALL ADJOIN OR OVERLAP AN ACCESSORY ROUTE AND SHALL EXTEND INTO AND OVER THE SPACE UNDERNEATH THE LAVATORY.
- 1. LAVATORY SHALL BE MOUNTED WITH A MINIMUM DISTANCE OF 18 INCHES FROM A WALL OR PARTITION TO THE CENTERLINE OF THE LAVATORY. LAVATORY SHALL BE MOUNTED WITH THE END OF THE COUNTERTOP SURFACE NO MORE THAN 48 INCHES ABOVE THE FLOOR. THE CLEARANCE FROM THE END OF THE COUNTERTOP SURFACE TO THE CENTERLINE OF THE LAVATORY SHALL BE NO LESS THAN 18 INCHES. THE CLEARANCE FROM THE END OF THE COUNTERTOP SURFACE TO THE CENTERLINE OF THE LAVATORY SHALL BE NO LESS THAN 18 INCHES. THE CLEARANCE FROM THE END OF THE COUNTERTOP SURFACE TO THE CENTERLINE OF THE LAVATORY SHALL BE NO LESS THAN 18 INCHES.**

ACCESSIBILITY ROUTE/SIDEWALKS/CORRIDORS/RAMPWAYS

1. AT LEAST ONE ACCESSIBLE ROUTE COMPLYING WITH 2016 CBC & OTHER APPLICABLE CALIFORNIA CODES SHALL CONNECT ACCESSIBLE EXTERIOR TO FACILITY ENTRANCES.
2. ACCESSIBLE ROUTE SHALL HAVE A CONTINUOUS SURFACE THAT IS UNIFORM IN WIDTH AND DEPTH AND FREE OF OBSTACLES OR OBSTRUCTIONS TO THE EXTENT OF THE ROUTE. THE ROUTE SHALL BE UNIFORM IN WIDTH AND DEPTH AND FREE OF OBSTACLES OR OBSTRUCTIONS TO THE EXTENT OF THE ROUTE. THE ROUTE SHALL BE UNIFORM IN WIDTH AND DEPTH AND FREE OF OBSTACLES OR OBSTRUCTIONS TO THE EXTENT OF THE ROUTE.
3. SURFACE CROSS SLOPES OF ACCESSIBLE ROUTE SHALL NOT EXCEED 1:50.
4. ACCESSIBLE ROUTE SHALL BE LESS THAN 48 INCHES WIDE AT LEAST AT 6' SPACING AND SHALL BE LOCATED AT REASONABLE INTERVALS TO FACILITATE ENTRY AND EXIT FROM A BUILDING.
5. INTERSECTION OF CORRIDORS OR AREAS WITH ACCESSIBLE PASSING SPACES SHALL BE UNIFORM IN WIDTH AND DEPTH AND FREE OF OBSTACLES OR OBSTRUCTIONS TO THE EXTENT OF THE ROUTE. THE ROUTE SHALL BE UNIFORM IN WIDTH AND DEPTH AND FREE OF OBSTACLES OR OBSTRUCTIONS TO THE EXTENT OF THE ROUTE.
6. ACCESSIBLE ROUTE SHALL BE UNIFORM IN WIDTH AND DEPTH AND FREE OF OBSTACLES OR OBSTRUCTIONS TO THE EXTENT OF THE ROUTE. THE ROUTE SHALL BE UNIFORM IN WIDTH AND DEPTH AND FREE OF OBSTACLES OR OBSTRUCTIONS TO THE EXTENT OF THE ROUTE.
7. AREA OF RESCUE ASSISTANCE TO COMPLY WITH PROVISIONS OF FEDERAL AND STATE CODES SHALL BE UNIFORM IN WIDTH AND DEPTH AND FREE OF OBSTACLES OR OBSTRUCTIONS TO THE EXTENT OF THE ROUTE.

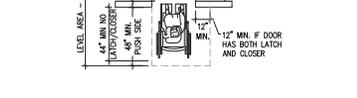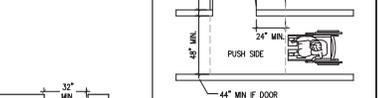

ENTRANCES/DOORS

1. ALL ACCESSIBLE ENTRANCES SHALL BE IDENTIFIED WITH AT LEAST ONE STANDARD SIGN AND WITH ADDITIONAL ORIENTATION SIGNS AS REQUIRED VISIBLY FROM APPROACHING PROXIMITY TO THE ENTRANCE.
2. EVERY REQUIRED ENTRANCE OR PASSAGE DOORWAY SHALL BE OF A SIZE AS TO PERMIT THE INSTALLATION OF A DOOR NOT GREATER THAN 36 INCHES IN HEIGHT AND NOT LESS THAN 36 INCHES IN WIDTH. DOORS SHALL BE OPERABLE AT OR NEAR 90 DEGREES.
3. THE WIDTH OF OR WIDTH OF THE GRIPPING SURFACE OF A GRAB BAR SHALL BE 1.5 INCHES AND THE WIDTH OF THE GRIPPING SURFACE OF A GRAB BAR SHALL BE 1.5 INCHES AND THE WIDTH OF THE GRIPPING SURFACE OF A GRAB BAR SHALL BE 1.5 INCHES.
4. THE GRAB BAR SHALL BE MOUNTED TO THE WALL OR PARTITION WITHIN 18 INCHES OF THE DOOR AND SHALL BE MOUNTED TO THE WALL OR PARTITION WITHIN 18 INCHES OF THE DOOR AND SHALL BE MOUNTED TO THE WALL OR PARTITION WITHIN 18 INCHES OF THE DOOR.
5. THE GRAB BAR SHALL BE MOUNTED TO THE WALL OR PARTITION WITHIN 18 INCHES OF THE DOOR AND SHALL BE MOUNTED TO THE WALL OR PARTITION WITHIN 18 INCHES OF THE DOOR.
6. THE GRAB BAR SHALL BE MOUNTED TO THE WALL OR PARTITION WITHIN 18 INCHES OF THE DOOR AND SHALL BE MOUNTED TO THE WALL OR PARTITION WITHIN 18 INCHES OF THE DOOR.
HAZARDS AND PROTRUDING OBJECTS

1. OBJECTS PROTRUDING FROM WALLS WITH THEIR LEADING EDGES BETWEEN 27 INCHES AND 80 INCHES ABOVE THE FINISHED FLOOR SHALL PROTRUDE NO MORE THAN 1/4 INCH INTO THE CLEAR PASSAGE.
2. OBJECTS PROTRUDING FROM WALLS WITH THEIR LEADING EDGES BETWEEN 27 INCHES AND 80 INCHES ABOVE THE FINISHED FLOOR SHALL PROTRUDE NO MORE THAN 1/4 INCH INTO THE CLEAR PASSAGE.
3. OBJECTS PROTRUDING FROM WALLS WITH THEIR LEADING EDGES BETWEEN 27 INCHES AND 80 INCHES ABOVE THE FINISHED FLOOR SHALL PROTRUDE NO MORE THAN 1/4 INCH INTO THE CLEAR PASSAGE.
TOILET TISSUE DISPENSER NOTE


LOCATE TOILET TISSUE DISPENSER ON THE WALL 7" MIN. X 9" MAX. IN FRONT OF THE WATER CLOSET (MEASURED FROM THE CENTERLINE AT THE DISPENSER) MOUNTED BELOW THE GRAB BAR WITH THE OUTLET OF THE DISPENSER AT A MIN. HEIGHT OF 15". DISPENSERS THAT CONTROL DELIVERY OR THAT DOES NOT PERMIT CONTINUOUS PAPER FLOW SHALL NOT BE USED.

MAX. DOOR CLOSER PRESSURES

INTERIOR DOOR:	5.0 LBS
EXTERIOR DOOR:	5.0 LBS
FIRE DOOR:	15.0 LBS

NECESSARY TO CLOSE & LATCH

DOOR APPROACH FRONTAL SCALE: 1/4"=1'-0"

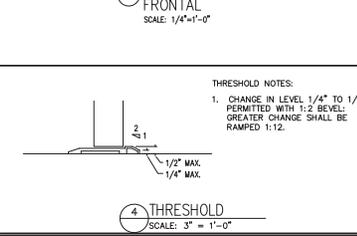

THRESHOLD NOTES:

1. CHANGE IN LEVEL 1/4" TO 1/2" PERMITTED WITH 1:2 BEVEL. GREATER CHANGE SHALL BE RAMPED 1:12.

TELEPHONES

1. PERMANENTLY INSTALLED TELEPHONES IN ACCESSIBLE STALLS SHALL HAVE VOICEDIAL CONTROLS WITH ACCESSIBLE SWITCHES FORTY INCHES OR OTHER APPLICABLE CODES.
2. THE TELEPHONE CONNECTION SHALL BE PROVIDED TO FACILITATE THE USE OF A TEXT TELEPHONE.


ACC. RESTROOMS EXISTING; HOWEVER MUST COMPLY WITH CURRENT ACCESSIBILITY STANDARDS

1. 8" (TO EDGE)
2. 1/4" (TO EDGE)
3. 1/4" (TO EDGE)
DOOR APPROACH LATCH SCALE: 1/4"=1'-0"



THRESHOLD SCALE: 3"=1'-0"

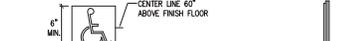

BUILDING SIGNAGE

1. SIGNS WHICH DESIGNATE RESTROOMS AND SANITARY FACILITIES SHALL COMPLY WITH 2016 CBC & OTHER APPLICABLE CALIFORNIA CODES.
2. SIGNS WHICH DESIGNATE RESTROOMS AND SANITARY FACILITIES SHALL COMPLY WITH 2016 CBC & OTHER APPLICABLE CALIFORNIA CODES.
3. SIGNS WHICH DESIGNATE RESTROOMS AND SANITARY FACILITIES SHALL COMPLY WITH 2016 CBC & OTHER APPLICABLE CALIFORNIA CODES.
HAZARDS AND PROTRUDING OBJECTS

1. OBJECTS PROTRUDING FROM WALLS WITH THEIR LEADING EDGES BETWEEN 27 INCHES AND 80 INCHES ABOVE THE FINISHED FLOOR SHALL PROTRUDE NO MORE THAN 1/4 INCH INTO THE CLEAR PASSAGE.
2. OBJECTS PROTRUDING FROM WALLS WITH THEIR LEADING EDGES BETWEEN 27 INCHES AND 80 INCHES ABOVE THE FINISHED FLOOR SHALL PROTRUDE NO MORE THAN 1/4 INCH INTO THE CLEAR PASSAGE.
3. OBJECTS PROTRUDING FROM WALLS WITH THEIR LEADING EDGES BETWEEN 27 INCHES AND 80 INCHES ABOVE THE FINISHED FLOOR SHALL PROTRUDE NO MORE THAN 1/4 INCH INTO THE CLEAR PASSAGE.
2016 CBC SECTION 110-6.0 ACCESSIBLE SINKS AND LAVATIONS

1. SINKS MUST BE ACCESSIBLE AND COMPLY WITH THIS SECTION.
2. A CLEAR FLOOR SPACE COMPLYING WITH SECTION 110-306.2, POSITIONED FOR A FORWARD APPROACH, AND KNEE AND TOE CLEARANCE COMPLYING WITH SECTION 110-306 SHALL BE PROVIDED.
3. THE HEIGHT OF ACCESSIBLE WATER CLOSETS SHALL BE A MINIMUM OF 27 INCHES AND A MAXIMUM OF 30 INCHES MEASURED TO THE TOP OF THE TOILET SEAT.
4. THE GRAB BAR SHALL BE MOUNTED TO THE WALL OR PARTITION WITHIN 18 INCHES OF THE DOOR AND SHALL BE MOUNTED TO THE WALL OR PARTITION WITHIN 18 INCHES OF THE DOOR.
5. THE GRAB BAR SHALL BE MOUNTED TO THE WALL OR PARTITION WITHIN 18 INCHES OF THE DOOR AND SHALL BE MOUNTED TO THE WALL OR PARTITION WITHIN 18 INCHES OF THE DOOR.
ACCESSIBILITY TACTILE SIGN NOTES

1. SIGNS SHALL BE 1/4" THICK MINIMUM.
2. TACTILE SIGNS SHALL BE MOUNTED A MINIMUM OF 48" AFF FROM THE BASELINE OF THE LOWEST LINE OF BRAILLE AND A MAXIMUM OF 60" AFF FROM THE BASELINE OF THE HIGHEST LINE OF RAISED LETTERING, ON THE LATCH SIDE OF THE DOOR.
3. COLOR AND CONTRAST OF SIGNS SHALL BE DISTINCTLY DIFFERENT FROM THE COLOR AND CONTRAST OF THE DOOR.

ACCESSIBLE RESTROOM DOOR SIGNS:

1. DOORWAYS LEADING TO ALL GENDER SANITARY FACILITIES SHALL BE IDENTIFIED BY AN EQUILATERAL TRIANGLE, 1/4 INCH (4.4mm) WITH EDGES 12 INCHES (305mm) LONG AND A VERTIX POINTING UPWARD. POINTED EDGES SHALL HAVE A 1/8" RADIUS.
2. ALL EDGES OF THE TRIANGLE SHALL BE ROUNDED ON THE DOOR AT A HEIGHT OF 54" - 60" AFF.
3. COLOR AND CONTRAST OF SIGNS SHALL BE DISTINCTLY DIFFERENT FROM THE COLOR AND CONTRAST OF THE DOOR.


ACCESSIBLE LOCKER

1. 5X BUT NOT LESS THAN ONE OF THE LOCKERS TO BE ACCESSIBLE PER CBC 110-2221.
2. 12" CLEAR FLOOR SPACE PER CBC 110-11.2.
3. HEIGHT OF THE STORAGE ELEMENT SHALL COMPLY WITH ONE OF THE REACH RANGES DESCRIBED IN CBC 110-308 CBC 110-811.4.
4. OPERABLE PARTS TO BE OPERABLE WITH ONE HAND AND NOT REQUIRE TWIST GRASPING, PINCHING, OR TWISTING OF THE WRIST PER CBC 110-308.4.
5. THE FORCE TO ACTIVATE OPERABLE PARTS TO BE 5 POUNDS MAX PER CBC 110-308.4.


ACCESSIBLE HARDWARE NOTE

1. ACCESSIBLE HARDWARE SHALL BE CENTERED BETWEEN 4" AND 48" ABOVE THE FINISHED FLOOR UNLESS OTHERWISE SPECIFIED.
2. ACCESSIBLE HARDWARE SHALL BE CENTERED BETWEEN 4" AND 48" ABOVE THE FINISHED FLOOR UNLESS OTHERWISE SPECIFIED.
3. ACCESSIBLE HARDWARE SHALL BE CENTERED BETWEEN 4" AND 48" ABOVE THE FINISHED FLOOR UNLESS OTHERWISE SPECIFIED.
LAVATORIES SCALE: 1/4"=1'-0"

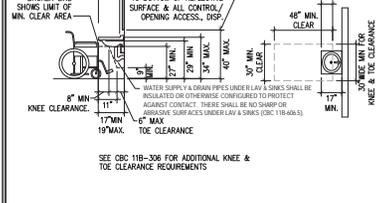


RESTROOM ID. SIGNAGE ENTRY, DIRECTIONAL & TACTILE EGRESS SIGNAGE

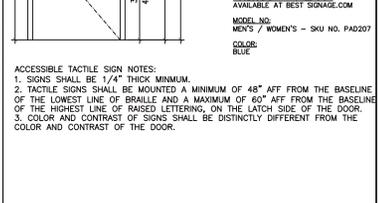


IDENTIFICATION SYMBOLS

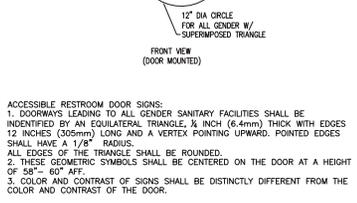


DETECTABLE WARNINGS

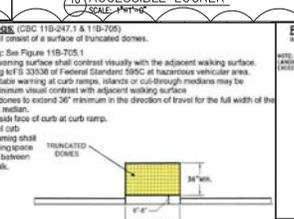


PARALLEL CURB RAMP

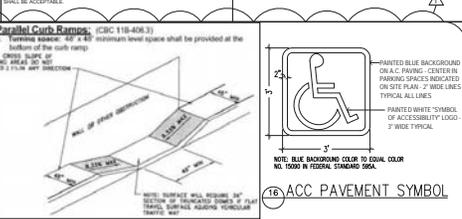


DOOR CONSTRUCTION SCALE: 1/4"=1'-0"

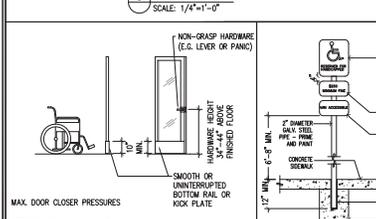

ACCESSIBILITY SIGNAGE

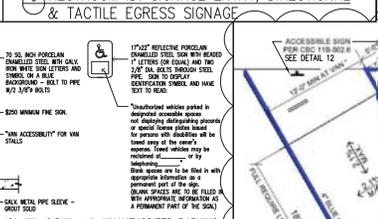

DETECTABLE WARNINGS

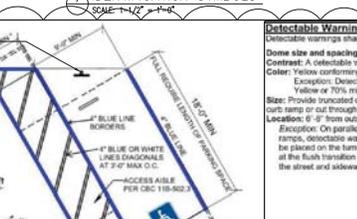

PANEL P-1 VOLTAGE: 120/240 WIRE: 3 MOUNTING: FLUSH NOTES:
 BUS RATING: PHASE: 1 AIC RATING: 10K
 MAIN REQ.: 175A TYPE: CONDITION: EXISTING

CKT #	LOAD	CB	LOAD DESCRIPTION	LOAD KVA	PHASE	LOAD KVA	LOAD DESCRIPTION	CB		LOAD	CKT #	
								P	T			
1	K	1	20	FREEZER, SHORTY	1.4	A	1.1	WALK-IN COOLER	2	20	K	2
3	K	1	30	TABLE, HOT FOOD	3.0	B	1.1	WALK-IN COOLER	2	20	K	4
5	K	1	20	REFRIGERATOR, SANDWICH/SALAD PREP	1.0	C	0.7	HOOD EXHAUST FAN*	2	20	M	6
7	K	1	20	FREEZER, WORKTOP	0.6	A	0.7	HOOD EXHAUST FAN*	2	20	M	8
9	K	1	20	ICE MAKER, U/C W/BIN	0.6	B	1.6	HOOD MAKE-UP AIR FAN*	1	20	M	10
11	K	1	20	DISPLAY CASE, REFRIGERATED	1.3	C	0.2	REC. - ROOF	1	20	G	12
13	K	1	20	DISPLAY CASE, REFRIGERATED	1.3	A	1.1	REC. - KITCHEN	1	20	G	14
15	C	1	20	LIGHTS/FAN - RESTROOMS	0.3	B	1.1	REC. - BACK	1	20	G	16
17	D	1	20	ALARM SYSTEM	0.2	C	0.4	REC. - FRONT SIGN	1	20	D	18
19				SPARE	A	0.4	REC. - WINDOWS	1	20	D	20	
21					B	0.2	REC. - POS	1	20	D	22	
23					C		SPARE				24	
25					A						26	
27					B						28	
29					C						30	
31					A						32	
33					B						34	
35					C						36	
37					A						38	
39					B						40	
41					C						42	

CONNECTED LOAD:
 PHASE A _____ KVA
 PHASE B _____ KVA
 PHASE C _____ KVA

DEMAND LOAD CALCULATION

DEMAND	SUBTOTAL	NEC DEMAND FACTOR	KVA
CONTINUOUS LOAD (C)	0.3	125%	0.4
DEDICATED LOAD (D)	1.2	100%	1.2
GENERAL RECEPTACLE (G)	2.4	100% of 1st 10KVA & 50% of remaining	2.4
KITCHEN EQUIPMENT (K)	11.4	65%	7.4
MECHANICAL EQUIPMENT (M)	3.0	125% of largest motor & 100% of remaining	3.4
TOTAL DEMAND KVA			14.8
			= 240
			61.7

*EXHAUST AND MAKE-UP AIR WILL BE ELECTRICALLY INTERLOCKED.

= AMPS @ 120/208, 3 PHASE, 4 WIRE: 61.7

ELECTRICAL PANEL SCHEDULE & LOAD CALC'S

61.7 AMPS TOTAL LOAD

- ELECTRICAL NOTES:**
- SWITCHES, CONTROLS, THERMOSTATS, ETC., ARE TO BE INSTALLED NO HIGHER THEN 48" TO THE TOP OF THE BOX ABOVE FINISHED FLOOR.
 - RECEPTACLE OUTLETS TO BE INSTALLED TO BE NO LOWER THEN 18" TO THE BOTTOM OF BOX ABOVE FINISH FLOOR.
 - ALL ELECTRICAL WORK SHALL COMPLY WITH THE CEC 2016 CODE.
 - RACEWAYS WILL COMPLY WITH 2016 CEC.
 - ALL KITCHEN APPLIANCES AND MOTORS (IN COMPLIANCE WITH CEC) TO HAVE DISCONNECT SWITCH.
 - ALL FEEDERS AND ALL OTHER SYSTEMS (BRANC, FEEDERS, & EQUIPMENT WHIPS) TO COMPLY WITH NEC.
 - ALL ELECTRICAL PANELS SHALL BE PROPERLY LABELED.
 - ~~ALL DOCUMENTATION REGARDING THE SERIES RATED BREAKERS TO BE USED ON THE PRODUCT WILL BE MAINTAINED BY THE INSTALLER. THE SERIES RATED BREAKERS SHALL BE MAINTAINED AND LABELED FOR THE INSTALLATION USE. NO SERIES RATED BREAKERS~~
 - A PERMANENT PLAQUE OR DIRECTORY SHALL BE INSTALLED AT EACH SERVICE DISCONNECT LOCATION IN COMPLIANCE WITH 2016 CEC ART.
 - ALL ELECTRICAL EQUIPMENT SHALL BE FIELD MARKED WARNING QUALIFIED PERSONAL OF THE POTENTIAL ARC FLASH HAZARDS AND THE APPROPRIATE PPE REQUIRED, PER 2016 CEC.
 - ALL KITCHEN APPLIANCES OF MORE THAN 1/2 HP TO BE PROVIDED WITH A UNIT SWITCH THAT COMPLIES WITH 2016 CEC.

CIRCUIT, CONDUIT, & GROUNDING NOTES:

FIELD VERIFY ALL EXISTING CONDITIONS
 AIC RATINGS FOR ALL PANELS AND CIRCUIT BREAKERS TO BE PER CEC.
 PANELS TO BE MARKED PER CEC ARTICLE 110.22
 EQUIPMENT CONDUIT TYPES: ALL EMT (NO FLEX CABLE ALLOWED)
 EQUIPMENT CONDUIT SIZES: ALL 120V USE #12 WIRE
 ALL ABOVE 200V USE #10 WIRE

GROUNDING NOTES:
 THE CONNECTION OF A GROUNDING ELECTRODE CONDUCTOR TO A GROUNDING ELECTRODE SHALL BE ACCESSIBLE AND MADE IN A MANNER THAT WILL ASSURE A PERMANENT AND EFFECTIVE GROUND WHERE NECESSARY TO ASSURE THIS FOR A METAL PIPING SYSTEM USED AS A GROUNDING ELECTRODE. EFFECTIVE BONDING SHALL BE PROVIDED AROUND INSULATED CONDUIT AND SECTIONS AND AROUND ANY EQUIPMENT THAT IS LIKELY TO BE DISCONNECTED FOR REPAIRS OR REPLACEMENT. BONDING CONTRACTORS SHALL BE SUFFICIENT LENGTH TO PERMIT REMOVAL OF SUCH EQUIPMENT WHILE RETAINING THE INTEGRITY OF THE BOND.

ELECTRICAL SCHEDULE


Item No	Qty	Equipment Category	Manufacturer	Model Number	Equipment Remarks	Amps	KW	HP	Volts	Phase	Direct	Plug	NEMA
5	1	FREEZER, SHORTY	DELFIELD	F2660	ON DEDICATED CIRCUIT	12.0	1.4	0.5	120	1	X		5-20P
6	1	TABLE, HOT FOOD	DUKE MANUFACTURING	E304	ON DEDICATED CIRCUIT	25.0	3.0		120	1	X		5-50P
7	1	REFRIGERATOR, SANDWICH/SALAD PREP	TRUE FOOD SERVICE	TSSU-48-12	ON DEDICATED CIRCUIT	8.6	1.0	0.33	115	1	X		5-15P
8	1	FREEZER, WORKTOP	TRUE FOOD SERVICE	TWT-27F	ON DEDICATED CIRCUIT	4.8	0.6	0.33	115	1	X		5-15P
9	1	ICE MAKER, U/C W/BIN	MANTOWOC ICE	UY-0190A	ON DEDICATED CIRCUIT	5.5	0.6	0.42	115	1	X		5-15P
15	2	DISPLAY CASE, REFRIGERATED	TURBO AIR	TM-48RB	ON DEDICATED CIRCUIT	10.9	1.3	0.5	115	1	X		5-15P
16	1	WALK-IN COOLER	MASTER-BILT OR EQUAL	NANOSORLO-BPH	ON DEDICATED CIRCUIT	10	2.2	1.5	230	1	X		5-15P
20	1	TYPE I HOOD	ECON-AIR	16L X 4.5'W TYPE I									
20.1		HOOD EXHAUST FAN	ECON-AIR	EABDU24HP	SEE M-1 & M-3	6.0	1.4	1.5	230	1	X		
20.2		HOOD MAKE-UP AIR FAN	FRIGKING	650FD	SEE M-1 & M-3	13.8	1.6	3	115	1	X		

EXHAUST AND MAKE-UP AIR WILL BE ELECTRICALLY INTERLOCKED.

ELECTRICAL SYMBOLS

- (ONLY SUGGESTED LOCATIONS FOR NEW EQUIPMENT OUTLETS & CONVENIENCE OUTLETS SHOWN - USE EQUIVALENT NEARBY EXISTING OUTLETS WHEN POSSIBLE)
- 120V DEDICATED SINGLE OUTLET (TO BE 18" ABOVE FLOOR UNLESS OTHERWISE NOTED)
 - 120V DUPLEX OUTLET (TO BE 18" ABOVE FLOOR UNLESS OTHERWISE NOTED)
 - 120V QUADPLEX OUTLET
 - 120V CEILING MOUNTED DUPLEX OUTLET; MOUNT ABOVE SHOW WINDOW, OUTLET & PLATE COVER SHALL MATCH CEILING, MOUNT PARALLEL WITH STORE FRONT.
 - JUNCTION BOX
 - TELEPHONE OUTLET, FLUSH MOUNTED IN WALL +36" (VON)
 - GROUND FAULT INTERRUPTED OUTLET (ALL KITCHEN OUTLETS)
 - SPECIAL OUTLET (SEE NEMA)
 - 120V DEDICATED SINGLE OUTLET (STUBBED UP 5')
 - 120V DUPLEX OUTLET (STUBBED UP 5')
 - TIME CLOCK (ASTRONOMICAL) - FOR WINDOW SIGNAGE ONLY; ALL OTHER LIGHTING CONTROLLED BY OCCUPANCY SENSORS, SEE SHEET LIG-1
- SEE M-1 ROOF PLAN FOR ELECTRICAL CONNECTIONS FOR HOOD FANS

ELECTRICAL SCOPE OF WORK:
 1. NEW EQUIPMENT OUTLETS & CIRCUITS
 2. EXISTING LIGHTING TO REMAIN

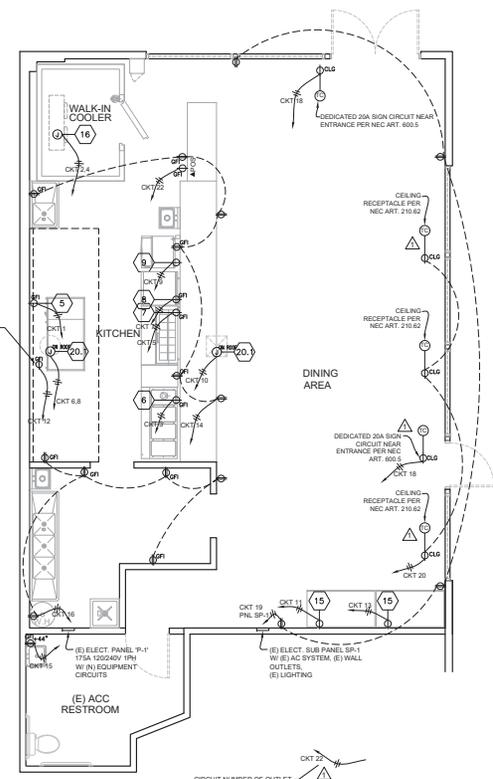

ELECTRICAL OUTLET PLAN

SCALE: 1/4" = 1'-0"
 SEE SHEET M-1 FOR ROOF-TOP EQUIPMENT ELECTRICAL

REV. DATE NO.
 12/27/19 1



TAKAMI ENGINEERING GROUP, INC.
 Harold E. Howell, P.E.
 10414 Folger Ave., Berkeley CA 94710
 510.549.0440 fax: 510.704.1975

GLENN CUNNINGHAM, DESIGNER
 BULL'S EYE CADD
 434 45TH AVENUE
 c. (510) 301-3005
 f. (415) 866-3024
 SAN FRANCISCO, CA 94112
 E-MAIL: glenn@bullseye.com

THE PROFESSIONAL SEAL OF THE REGISTERED ELECTRICAL ENGINEER (SEE THE STATE OF CALIFORNIA ELECTRICAL BOARD WEBSITE FOR THE COMPLETE LIST OF REGISTERED ELECTRICAL ENGINEERS) IS THE PROPERTY OF THE STATE OF CALIFORNIA. IT IS TO BE USED ONLY BY THE REGISTERED ELECTRICAL ENGINEER WHOSE NAME IS THEREON. ANY OTHER USE OF THIS SEAL IS UNLAWFUL. THE REGISTERED ELECTRICAL ENGINEER SHALL BE RESPONSIBLE FOR THE ACCURACY OF THE INFORMATION CONTAINED HEREIN. THE REGISTERED ELECTRICAL ENGINEER SHALL BE RESPONSIBLE FOR THE ACCURACY OF THE INFORMATION CONTAINED HEREIN. THE REGISTERED ELECTRICAL ENGINEER SHALL BE RESPONSIBLE FOR THE ACCURACY OF THE INFORMATION CONTAINED HEREIN.



T.I. - TAPSILOG BISTRO
 1998 HOMESTEAD ROAD #121
 SANTA CLARA, CA 95050

Date: 10/7/19
 Drawn: GOC
 Sheet: E-1

GENERAL HEALTH DEPARTMENT NOTES

- GREASE TRAP LIDS AND FLOOR SINKS MUST BE INSTALLED FLUSH WITH THE FINISHED FLOOR.
- EACH PERMANENT FOOD FACILITY SHALL BE FULLY ENCLOSED IN A BUILDING CONSISTING OF PERMANENT FLOOR, WALLS, AND AN OVERHEAD STRUCTURE.
- INSTALL A MINIMUM FIVE (5) FOOT HIGH SMOOTH, WASHABLE, NONABSORBENT AND LIGHT COLORED WALL OR PARTITION FROM THE FLOOR BETWEEN THE JANITORIAL MOP SINK AND THE FLOOR FROM THE FLOOR BETWEEN THE JANITORIAL MOP SINK AND THE FOOD PREP SINK. THE WALL OR PARTITION MUST HAVE AN ACCEPTABLE MOISTURE RESISTANT FINISH ON THE SIDE FACING THE MOP SINK, SUCH AS POLISHED STAINLESS STEEL OR CERAMIC TILE.
- AT LEAST 16 SQUARE FEET OF DRY STORAGE IS PROVIDED IN 15 MINUTE SHELVING AND UNDER AND OVER SHELVING.
- NON NSF COUNTERS/CABINETS WILL HAVE PLASTIC LAMINATION INSIDE AND OUT AND THE FLOOR MATERIAL WILL HAVE A CONTINUOUS COVE BASE ON THE EMPLOYEE SIDE.
- CONCRETE FLOORS ARE TO BE SEALED WITH A PENETRATING SEALER THAT IS GREASE, OIL AND MOISTURE RESISTANT AND APPROVED FOR COMMERCIAL USE.
- WHERE A SEALED CONCRETE FLOOR IS PROPOSED AND APPROVED, INTERNAL COVE BASE (SUCH AS AN APPROVED QUARRY OR CERAMIC TILE COVERED BASE) MUST BE KEVEX-24 TO THE FLOOR SURFACE. TO KEVEX-24, THE FLOOR IS SAW CUT AT THE WALL/FLOOR JUNCTURE AND AN APPROVED COVE BASE IS INSERTED AND GROUTED IN SO AS TO BE FLUSH, INTEGRAL, AND CONTINUOUS WITH THE FLOOR SURFACE.
- THE WALL SURFACES ADJACENT TO DRAINBOARDS & UTENSIL, MOP, AND FOOD PREPARATION SINKS SHALL BE COVERED WITH FIBERGLASS REINFORCED POLYESTER PANELS (FRP), TILE, STAINLESS STEEL, OR OTHER EQUIVALENT DURABLE WATERPROOF MATERIAL, EXTENDING AT LEAST 4 FEET ABOVE THE COVERED BASE.
- THE WALL SURFACES AT LOW, FLOOR-TYPE MOP BASINS SHALL BE COVERED WITH FIBERGLASS REINFORCED POLYESTER PANELS (FRP), STAINLESS STEEL, CERAMIC TILE OR EQUIVALENT DURABLE WATERPROOF MATERIAL TO A MINIMUM HEIGHT OF 8 FEET ABOVE THE FLOOR.
- NON NSF COUNTERS/CABINETS WILL HAVE PLASTIC LAMINATION INSIDE AND OUT, AND THE FLOOR MATERIAL WILL HAVE A CONTINUOUS COVE BASE ON THE EMPLOYEE SIDE.
- DISHWASHING CHEMICALS SHALL BE OFF THE FLOOR AT LEAST 6 INCHES ON EITHER AN APPROVED DRAINAGE TRAY OR WALL MOUNTED UNITS.
- ALL FOOD SERVICE AND RELATED EQUIPMENT SHALL BE NATIONAL SANITATION FOUNDATION (NSF) APPROVED AND IN CONFORMITY WITH LOCAL HEALTH REGULATIONS. INSTALLATIONS OF EQUIPMENT SHALL MEET SAME REQUIREMENTS. ALTHOUGH HEALTH REQUIREMENTS WILL BE REVIEWED DURING BUILDING DEPT. AUTHORIZATION, THE OWNER WILL HAVE TO TAKE OUT SEPARATE HEALTH PERMIT.
- ALL ADDJONING EQUIPMENT AND COUNTERS SHALL BE SEALED TO PREVENT THE ENTRANCE OF MOISTURE. MAXIMUM OPENING BELOW SNEEZE GUARD IS 1/4". A PORTABLE SNEEZE GUARD MAY BE USED IF THE HEALTH DEPT. APPROVES SIZE AND POSITIONING DURING CONSTRUCTION.
- ALL CUTTING BOARDS SHALL BE OF NON-WOOD CONSTRUCTION AND I.S.F. APPROVAL.
- ALL REFRIGERATION EQUIPMENT AND EQUIPMENT FOR HOT STORAGE SHALL HAVE THERMOMETERS WHICH ARE EASILY READABLE IN PROPER WORKING CONDITIONS AND ACCURATE WITHIN RANGE OF PLUS OR MINUS TWO DEGREES.
- STORAGE SHELVING MUST BE SPECIFIED AS HAVING SMOOTH, NONABSORBENT FINISH. THE LOWEST SHELF SHOULD BE 18" ABOVE FLOOR.
- EXHAUST HOODS MUST MEET ALL MECHANICAL CODE REQUIREMENTS. CANOPY HOODS SHALL EXTEND IF BEYOND ALL SIDES OF COOKING EQUIPMENT AS MEASURED FROM INSIDE EDGE OF THE GREASE TROUGH. ADEQUATE MECHANICAL MAKE-UP AIR MUST BE PROVIDED TO PRODUCE A BALANCED SYSTEM. MAKE-UP AIR SHALL EQUAL EXHAUSTED AIR.
- TOILET AND DRESSING ROOMS SHALL BE MECHANICALLY VENTILATED BY EXHAUST FAN TO THE OUTSIDE PREMISES. THE EXHAUST FAN WITHIN EACH TOILET ROOM SHALL BE ACTIVATED BY THE SWITCH TO THE LIGHT FIXTURE LOCATED THEREIN AND CAPABLE OF 12 AIR CHANGES PER HOUR.
- CATTERS 3" x 6" FOR ALL FLOOR ADJACENT EQUIPMENT, INSTALLATION ON ENCHLICES OR COMPLETELY SEALED IN POSITION AT LEAST A 1/4" HIGH HIGH CONTINUOUS COVE BASE OR CONCRETE CURB.
- IF A HOT WATER (180 DEGREES F) SANITIZING RINSE DISHWASHING MACHINE IS INSTALLED IT WILL REQUIRE A TYPE 2 VAPOR HOOD WITH MECHANICAL EXHAUST.

- ATMOSPHERIC VACUUM BREAKERS OR OTHER APPROVED BACKFLOW PREVENTION DEVICES REQUIRED AT WATER SUPPLY LINES TO SINKS WITH THREADED SPIGOTS, DISHWASHER, GARBAGE DISPOSAL, FLUSH LINES, STEAM EQUIPMENT, URINALS, TOILETS, BICYCLE DISPENSERS, ICE MACHINE, LANDSCAPE IRRIGATION SYSTEMS, AND OTHER FIXTURE WHERE REQUIRED.
 - AT LEAST ONE SINK OR ONE SINK COMPARTMENT SHALL BE AVAILABLE FOR FOOD PREPARATION. FOOD PREP SINKS SHALL HAVE AND INDIRECT SEWER CONNECTION, I.E., FIXED IN-LINE AIR GAP OR DRAIN TO A FLOOR SINK THROUGH AN APPROVED AIR GAP.
 - A SEPARATE WALL-MOUNTED HAND WASHBASIN IS REQUIRED WITHIN OR ADJACENT TO THE FOOD PREP AND PACKAGING AREA. PROVIDE PERMANENTLY MOUNTED SINGLE SERVICE SOAP AND PAPER TOWEL DISPENSERS.
 - ALL SINKS TO BE PROVIDED WITH ADEQUATE HOT AND COLD WATER FROM MIXING FAUCETS.
 - BUILDING SHALL BE INSECT AND RODENT VERMIN PROOF. EXTERIOR DOORS SHALL BE SELF-CLOSING AND MUST COME WITHIN 1/4" OF FLOOR. ALL VENTS AND OTHER OPENINGS TO OUTSIDE NEED TO BE SEALED OR SCREENED. 16-MESH SCREENING IS REQUIRED ON ANY OPERABLE WINDOWS.
 - REUSE CONTAINER SHALL BE MOISTURE AND VERMIN PROOF WITH TIGHT FITTING LIDS.
 - ANY TRASH AND GARBAGE STORAGE AREA RECEIVING FOOD WASTE OR FOOD CONTAINERS MUST HAVE A WATER BAIT TO FACILITATE CLEANING. FLOOR, WALLS AND CEILING MUST BE SMOOTH AND CLEANABLE. RECOMMENDED HOT AND COLD WATER BIB IS AVAILABLE FOR CLEANING. WASTEWATER FROM MANY CLEANING OPERATIONS MUST BE DISPOSED OF AS SEWAGE THROUGH A FLOOR DRAIN IN THE TRASH ENCLOSURE OR EQUIVALENT.
 - PROVIDE A MOP OR ROOM RACK AND CLEANING SOLUTION STORAGE SHELVING AWAY FROM FOOD PREPARATION AND STORAGE AREAS.
 - EMPLOYEE GARMENT CHANGE AREA, SEPARATE FROM RESTROOM, IS REQUIRED. CABINETS OR LOCKERS MUST BE INSTALLED IN THIS AREA.
 - EQUIPMENT SHALL MEET OR BE EQUAL TO APPLICABLE N.E.P. STANDARDS OR IN THE ABSENCE OF APPLICABLE N.E.P. THE ENFORCEMENT OFFICER SHALL APPROVE STANDARDS. SUBMIT DOCUMENTATION OF WRITTEN VERIFICATION THAT ONLY APPROVED COMMERCIAL EQUIPMENT SHALL BE USED.
 - PROVIDE A SPACE OF AT LEAST 1" BETWEEN UTENSIL SINK AND ADJACENT WALL TO AVOID CAULKED CREVICES, WHICH COLLECT WATER AND DEBRIS.
 - WALLS AND CEILING OF ALL ROOMS EXCEPT BARS, WHERE FOOD IS STORED IN UNOPENED CONTAINERS, AND DINING AREAS SHALL BE DURABLE, SMOOTH, NON-ABSORBENT AND WASHABLE. WALLS AND CEILING SHALL BE LIGHT COLORED. SEE DRAWINGS FOR SCHEDULES.
 - EACH METAL SINK COMPARTMENT MUST BE LARGE ENOUGH TO HOLD THE LARGEST UTENSIL THAT BE WASHED IN THE SINK. EVERY UTENSIL SINK MUST HAVE 2 METAL DRAIN BOARDS. EACH DRAIN BOARD MUST BE INTEGRAL, AND SHOULD BE AT LEAST AS LARGE AS ONE SINK COMPARTMENT.
 - ALL EXPOSED CONDUIT, PLUMBING, ETC. MUST BE INSTALLED AT LEAST 6" OFF THE FLOOR AND 12" FROM WALLS. ALL EXPOSED FLEX CONDUITS ETC. TO BE SEAL TIGHT OR EQUIVALENT.
 - THE JUNCTURE AT THE FLOOR AND THE WALL MUST HAVE A COVERED BASE WITH AT LEAST 3/8" RADIUS AND EXTENDING AT LEAST 6" UP THE WALL. STATIONARY FIXTURES OR BUILT-IN EQUIPMENT CAN BE SEALED ON A 4" HIGH 3/8" RADIUS CONCRETE CURB OR COVERED-IN POSITION ON THE FLOOR IT MUST BE COVERED WITH AN APPROVED MATERIAL.
 - PROVIDE AUTOMATIC DOOR CLOSURES ON ALL ENTRY, DELIVERY, RESTROOM AND CHANGE ROOM DOORS.
 - ALL AREAS MUST HAVE SUFFICIENT VENTILATION TO FACILITATE PROPER FOOD STORAGE AND TO PROVIDE A REASONABLE CONDITION OF COMFORT FOR ANY EMPLOYEE, CONSISTENT WITH THE JOB PERFORMED BY THE EMPLOYEE.
 - PROVIDE AT LEAST 1" SPACE BETWEEN SINKS AND SIDEWALL OR ANGLE SIDE SPLASHES TO WALL.
 - ALL WORKING SURFACES SHALL BE SMOOTH AND IMPERVIOUS.
 - WHERE PIPELINES OR CONDUITS ENTER A WALL, CEILING OR FLOOR, THE OPENING AROUND THE LINE SHALL BE TIGHTLY SEALED AND MADE SMOOTH, NONABSORBENT AND EASILY CLEANABLE.
- TOILET ROOM NOTES:**
TOILET ROOM IS EXISTING.
- PERMANENTLY INSTALLED SOAP AND SANITARY TOWEL DISPENSERS.
 - TOILET TISSUE DISPENSER.
 - VENTILATION TO THE OUTSIDE AIR THROUGH AN OPERABLE SCREENED WINDOW, OR LIGHT-SWITCH ACTIVATED EXHAUST FAN.
 - SELF-CLOSING DOORS.
 - HAND WASH SINKS WITH HOT/COLD COMINATION WATER FAUCETS.






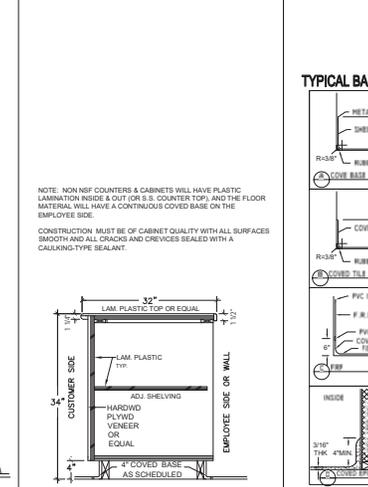
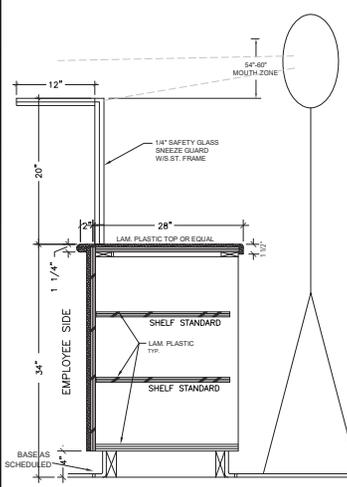


DOOR SCHEDULE

DOOR NO.	DOOR				REMARKS (ALSO SEE NOTE BELOW)	
	MAT'L	FINISH	WIDTH	HT.		
(C) 1	MTL/GLASS	ANOD ALUM 3"	07"7"	0	(C) = EXISTING (N) = NEW	
(C) 2	WOOD	PAINT	3"	07"6"	0	(C) = EXISTING (N) = NEW
(N) 3	MTL	PAINT	3"	07"6"	8"	(N) OR CLOSURE, LEVER HANDLE, HANGING LOCK, PAINT DOOR TO MATCH ADJ. WALL COLOR
(N) 4	MTL	GALV. MTL	3"	07"6"	7"	(N) DUAL ACTING DOOR W/ MIN. 200 SQ IN NEW PANEL (UMC 1003.3.1.5) SEE DETAIL 3
(N) 5	MTL	GALV. MTL	3"	07"6"	7"	(N) INSULATED COOLER OR FREEZER DOOR

- DOOR NOTES**
- ALL DOORS 1 3/8" THICK UNLESS OTHERWISE NOTED. (DOORS WITH GLASS LITE SHALL BE 1 1/2" THICK)
 - PROVIDE STOPS AT ALL DOORS AS APPLICABLE TO ADJACENT WALL AND DOOR SWING, ALL WITH SELF CLOSING MECHANISM.
 - HARDWARE ON ALL DOORS SHALL MEET HANDICAP HEIGHTS, CLOSURE PRESSURE, THRESHOLD SHALL NOT BE MORE THAN 1/4" HIGH. PRESSURE SHALL NOT EXCEED 5 LBS. ON EXTERIOR AND INTERIOR DOORS. 15 LBS. FOR FIRE DOORS. HARDWARE HEIGHT TO MEET REQUIREMENT OF 34" TO 44" CENTERLINE OFF MOUNTING.
 - NO FLOOR TRANSITION OR THRESHOLD SHALL BE HIGHER THAN 1/2" (HANDICAP REQUIREMENT).
 - WHERE NECESSARY, UNDERCUT DOORS 1" TO ALLOW VENTILATION. SEE MECHANICAL DRAWINGS.
 - DOORS AND FRAMES TO BE PREPARED FOR RELATED HARDWARE. IF NECESSARY, REINFORCE DOORS AND FRAMES AS REQUIRED BY HARDWARE.
 - FIRE DOORS, FRAMES, HARDWARE AND ALL OTHER DOORS OPERATION SHALL BE IN STRICT COMPLIANCE WITH ALL APPLICABLE CODES.
 - PROVIDE ALL ACCESSORIES, COMPONENTS, ASSEMBLIES AND RELATED HARDWARE (EVEN IF NOT SPECIFIED) SO AS TO MAKE COMPLETE AND READY FOR USE.
 - GENERAL CONTRACTOR TO PROVIDE ON 12" EQUILATERAL TRIANGLE SIGN FOR MEN AND 12" DIAMETER CIRCLE FOR WOMEN ON TOILET DOORS WITH RAISED LETTER AND BRAILLE SIGNAGE AT LATCH OUTSIDE RESTROOMS (ENTRANCE DOORS).
 - ALL EXCESS DOORS SHALL BE OPERABLE FROM THE EGRESS WITHOUT THE USE OF A KEY OR ANY SPECIAL KNOWLEDGE OR EFFORT. KEY LOCKING HARDWARE MAY BE USED ON THE MAIN ENTRY WHEN THERE IS A READILY VISIBLE, DURABLE SIGN ON OR ADJACENT TO THE DOOR STATING THIS DOOR MUST REMAIN UNLOCKED WHILE THIS SPACE IS OCCUPIED. 2014 CBC 100.1.3.3
 - ALL ENTRY & RESTROOM DOORS TO HAVE SELF-CLOSING DEVICES. GAPS UNDER INTERIOR DOORS NOT TO EXCEED 1/4"
 - LOWER 6" OF DOOR SURFACE IS PROVIDED WITH A SMOOTH SURFACE FOR THE FULL WIDTH OF THE DOOR, AT THE PUSH SIDE OF THE DOOR PER CBC 118.4.02.10.

- CEILING / LIGHTING NOTES:**
- PROVIDE PLASTIC TUBE GUARDS WITH PLASTIC END HOLDERS FOR EXPOSED FLUORESCENT LAMPS IN FOOD PREPARATION AREAS OR IN AREAS WHERE FOOD IS EXPOSED.
 - LIGHT FIXTURES IN AREAS WHERE FOOD IS PREPARED OR WHERE OPEN FOOD IS STORED OR WHERE UTENSILS ARE CLEANED MUST HAVE SHATTER PROOF SHIELDS AND SHALL BE READILY CLEANABLE.
 - ALL FLUORESCENT LAMPS TO BE "COOL WHITE" NO SUBSTITUTIONS.
 - IN EVERY ROOM & AREA IN WHICH ANY FOOD IS PREPARED, MANUFACTURED, PROCESSED, OR PREPACKAGED, OR IN WHICH EQUIPMENT OR UTENSILS ARE CLEANED, SUFFICIENT NATURAL OR ARTIFICIAL LIGHTING SHALL BE PROVIDED TO PRODUCE THE FOLLOWING LIGHT INTENSITY WHILE THE AREAS IS IN USE:
 - (a) AT LEAST 10 CANDLES AT A DISTANCE OF 30" ABOVE THE FLOOR IN WALK-IN REF. UNITS & DRY FOOD STORAGE AREAS.
 - (b) AT LEAST 20 CANDLES FOR THE FOLLOWING:
 - 1. AT A SURFACE WHERE FOOD IS PROVIDED FOR CONSUMER SELF-SERVICE OR WHERE FRESH PRODUCE OR PREPACKAGED FOODS ARE SOLD OR OFFERED FOR CONSUMPTION.
 - 2. ROSE EQUIPMENT SUCH AS REACH-IN AND UNDER-COUNTER REFRIGERATORS, HOT HOLD EQUIPMENT, & OVENS.
 - 3. AT A DISTANCE OF 30" ABOVE THE FLOOR IN AREAS USED FOR HANDWASHING, WAREWASHING, & EQUIPMENT & UTENSIL STORAGE, & IN TOILET ROOMS.
 - (c) AT LEAST 50 CANDLES AT A SURFACE WHERE A FOOD EMPLOYEE IS WORKING WITH FOOD OR WORKING WITH UTENSILS OR EQUIPMENT SUCH AS KNIVES, SLICERS, GRINDERS, OR SAWS WHERE EMPLOYEE SAFETY IS A FACTOR AND IN OTHER AREAS AND ROOMS DURING PERIODS OF CLEANING.

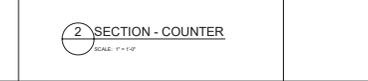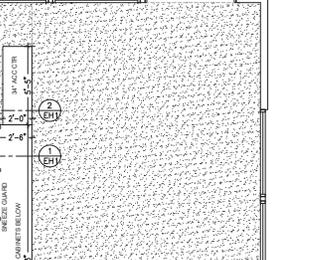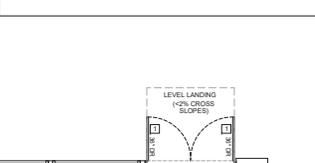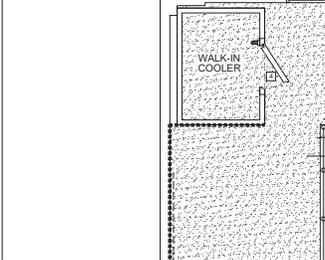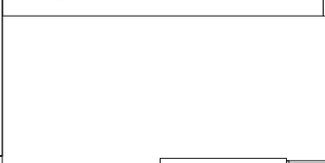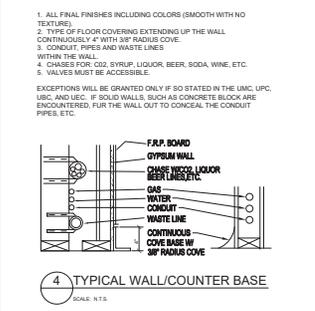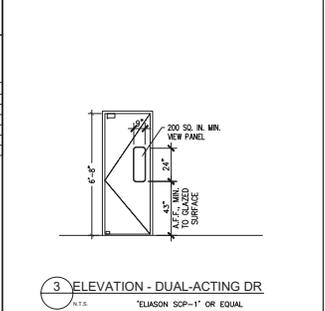

ROOM FINISH SCHEDULE
ALL FINISHES ARE NEW UNLESS INDICATED OTHERWISE


NO.	DESCRIPTION	NOTE
1	CARPET AND PAD, MAX FILE HT OF 1/2" IF NO PAD BACKING	
2	EXISTING CERAMIC TILE	
3	SOLID SHEET VINYL, COMMERCIAL GRADE (ALTRU STROMBACH 90 OR EQUAL), HEAT WELD BEAMS	
4	NSF APPROVED PANEL, INSULATED FLOOR	
5	4" INTEGRAL METAL COVE, APPLY COMMERCIAL GRADE SEALANT BETWEEN BASE AND PANEL	
6	COVED WOOD MOLDING	
7	4" INTEGRAL COVERED EPOXY W/ 3/8" RAD	
8	4" COVERED CERAMIC TILE, CONTINUOUS W/ 3/8" RAD.	
9	3/8" TYPE "X" GYPSUM BOARD	
10	(E) CERAMIC TILE (TO 4" ABOVE COVERED BASE)	
11	SMOOTH FINISH, WITHOUT TEXTURE, PAINTED SURFACES TO BE OIL OR ENAMEL BASED (SEM GLOSS)	
12	STUCCO GALVANIZED STEEL	
13	STAINLESS STEEL SHEET (BACK & SIDE OF HOOD TO FLOOR)	
14	FRP BOARD FULL HEIGHT TO CEILING, @ AREAS BEHIND SINKS & OTHER WET EQUIPMENT	
15	EXISTING HARLDID CEILING (PAINT AS NEEDED)	
16	SMOOTH, CLEANABLE, NO TEXTURE, LITE COLOR, OIL OR ENAMEL BASED PAINT	
17	T-BAR GYP DR CEILING W/ REMOVABLE SMOOTH AND WASHABLE TILE	
18	T-BAR GYP DR CEILING W/ ACOUSTICAL CORRUGATED TILE LAY-IN	
19	EXPOSED CEILING PAINTED BLACK	
20	STUCCO GALVANIZED STEEL	

- FINISH NOTES**
- RESTROOM IS EQUIPPED W/ TOILET PAPER ROLL DISPENSER, SOAP & PAPER TOWEL DISPENSER, TOILET COVER DISPENSER, MIRRORS, A.D.A. APPROVED GRAB BARS; SEE TOILET ROOM NOTES THIS PAGE. LOCATION REQ. DETAILS FOR BLDG. DEPT. ONLY. (ON SHEET A.3)
 - NEW SMOOTH & WASHABLE TILE OVER FOOD PREP AREAS.
 - ALL WALLS BEHIND SINKS TO HAVE APPROVED WANSCOAT TO A MIN. OF 4" HIGH FROM TOP OF THE BASE COVE BEHIND ALL SINKS.
 - EXISTING TO REMAIN: PATCH, REPAIR, & REPLACE TILE AS NECESSARY.

WALLS WITH (E) CERAMIC PORCELAIN TILE ARE DESIGNATED BY: **-----**

WALLS WITH FRP ARE DESIGNATED BY: **-----**

WALLS WITH S.S. SHEET ARE DESIGNATED BY: **-----**

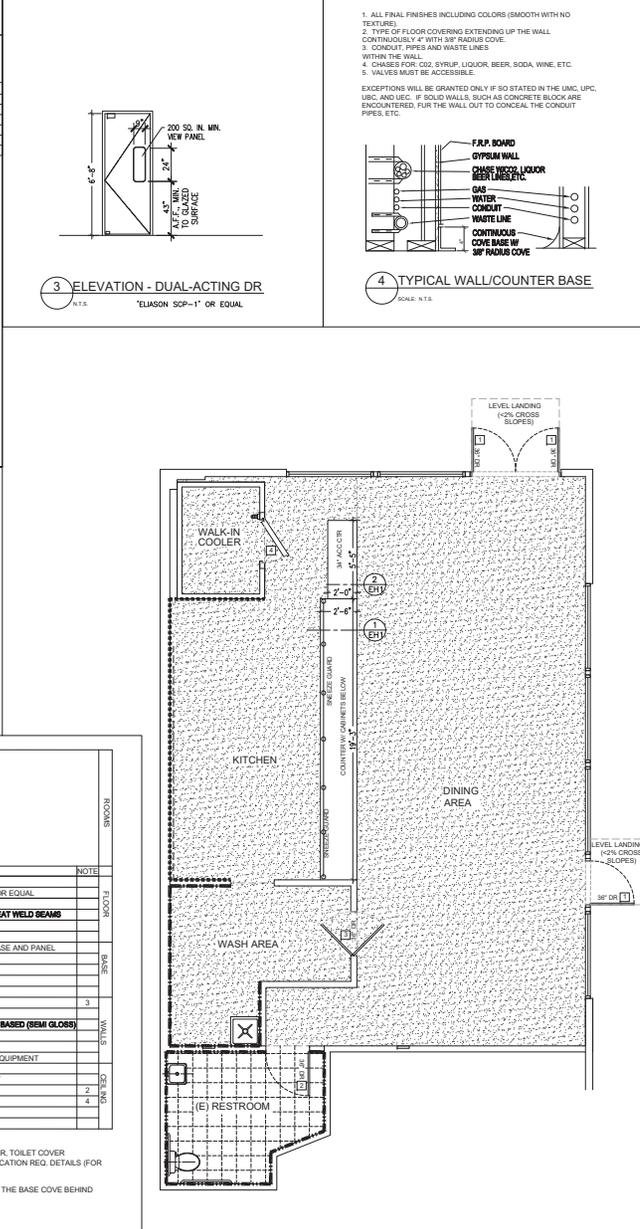

FINISH FLOOR PLAN
SCALE: 1/4" = 1'-0"

REV. DATE NO.

TAKAMI ENGINEERING GROUP, INC.
Harold E. Howell, P.E.
10414 Folger Ave., Berkeley CA 94710
510.549.0440 fax: 510.704.1975

GLENN CUNNINGHAM DESIGNER
BULL'S EYE CADD
434 45TH AVENUE
SAN FRANCISCO, CA 94118
c. (510) 301-3005
f. (415) 866-3024
EMAIL: gpcadd@gmail.com

T.I. - TAPSILOG BISTRO
1988 HOMESTEAD ROAD #121
SANTA CLARA, CA 95050

Date: 10/7/19
Drawn: GDC
Sheet: **EH-1**

HOOD INFORMATION - Job#4001167

HOOD NO.	TAG	MODEL	LENGTH	MAX. COOKING DUTY	APPLIANCE DUTY	DESIGN CFM/FE	TOTAL EXH. CFM	EXHAUST PLENUM (RISERS)				HOOD CONSTRUCTION	HOOD CONFIG.			
								WIDTH	LENG.	HEIGHT	DIA.		CFM	VEL.	S.P.	END TO
1		5424 EX-2	16' 0"	600 Dep.	Heavy	250	4000	14"	26"	4"	4000	1582	-0.503"	430 SS Where Exposed	ALONE	ALONE


PATENT NUMBERS
Exhaust Hoods ND-2/BD-2/SND-2 (Canada) - CA Patent 2520435 C

HOOD INFORMATION

HOOD NO.	TAG	TYPE	FILTER(S)		EFFICIENCY @ 7 MICRONS	LIGHT(S)		WIRE GUARD	LOCATION	SIZE	UTILITY CABINET(S)		ELECTRICAL	SWITCHES	FIRE SYSTEM	HOOD HANGING WEIGHT
			QTY.	HEIGHT		LENGTH	QTY.				TYPE	TYPE				
1		SS Baffle with Handles	12	20"	16"	30%	5	L55 Series E26	ND						ND	573 LBS

HOOD OPTIONS


HOOD NO.	TAG	OPTION
1		LEFT END STANDOFF (FINISHED) 1' Wide 54" Long Insulated
		INSULATION FOR BACK OF HOOD
		LEFT WALL AS END PANEL

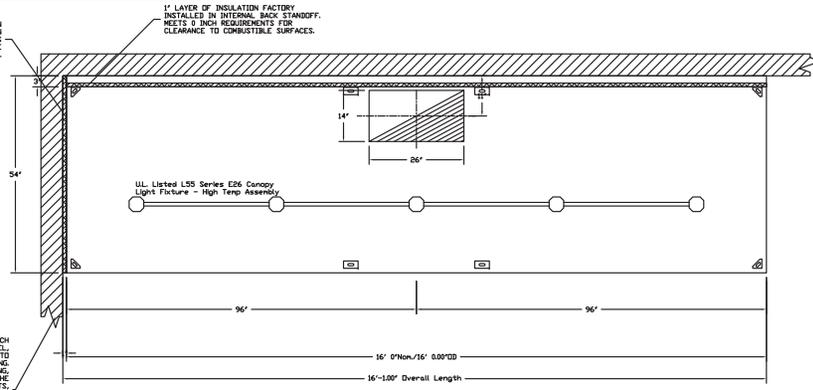

PLAN VIEW - Hood #1
16' 0.00' LONG 5424EX-2


NOTE: Additional hanging angles provided for hoods 12' and longer.

INSTALLER MUST CONFIRM HOOD IS INSTALLED SUCH THAT THE SPECIFIED WALL, ACTING AS AN END PANEL, IS MATED TIGHT TO THE CORRECT END OF HOOD TO ACHIEVE A REDUCED MINIMUM EXHAUST CFM LISTING. NON-COMPLIANCE WILL NULLIFY THE ETL LISTING, VOID THE MANUFACTURER'S WARRANTY, AND HOLD THE CONTRACTOR LIABLE FOR ANY AND ALL LOSSES, COSTS, AND EXPENSES RELATED TO THE NON-COMPLIANCE OF THE MANUFACTURER'S SPECIFIED INSTRUCTION. THE WALL ACTING AS AN END PANEL MUST EXTEND NO LESS THAN 20" FROM THE INTERFACING HOOD. NO HOOD END IS MOUNTED AND MUST EXTEND NO LESS THAN 10" UNDER BOTTOM OF HOOD TO BE ELIGIBLE FOR REDUCED MINIMUM EXHAUST CFM LISTING.

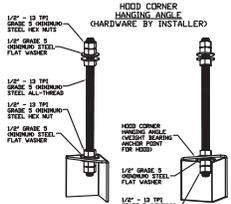


ASSEMBLY INSTRUCTIONS

HANGING ANGLE MUST BE SUPPORTED WITH 1/2" - 13 TPI GRADE 5 (MINIMUM) ALL-THREAD, SANDWICH HANGING ANGLES AND CEILING ANCHOR POINTS WITH 1/2" GRADE 5 (MINIMUM) STEEL FLAT WASHERS AND 1/2" - 13 TPI GRADE 5 (MINIMUM) HEX NUTS AS SHOWN. MUST USE DOUBLED HEX NUT CONFIGURATION BENEATH HOOD HANGING ANGLES AND ABOVE CEILING ANCHORS. MAINTAIN 1/4" OF EXPOSED THREADS BENEATH BOTTOM HEX NUT. TORQUE ALL HEX NUTS TO 57 FT-LBS.

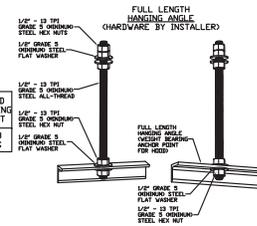

ASSEMBLY INSTRUCTIONS

HANGING ANGLE MUST BE SUPPORTED WITH 1/2" - 13 TPI GRADE 5 (MINIMUM) ALL-THREAD, SANDWICH HANGING ANGLES AND CEILING ANCHOR POINTS WITH 1/2" GRADE 5 (MINIMUM) STEEL FLAT WASHERS AND 1/2" - 13 TPI GRADE 5 (MINIMUM) HEX NUTS AS SHOWN. MUST USE DOUBLED HEX NUT CONFIGURATION ABOVE CEILING ANCHORS. SINGLE HEX NUT BENEATH HANGING ANGLE IS ACCEPTABLE FOR FULL LENGTH HANGING ANGLES. MAINTAIN 1/4" OF EXPOSED THREADS BENEATH BOTTOM HEX NUT. TORQUE ALL HEX NUTS TO 57 FT-LBS.

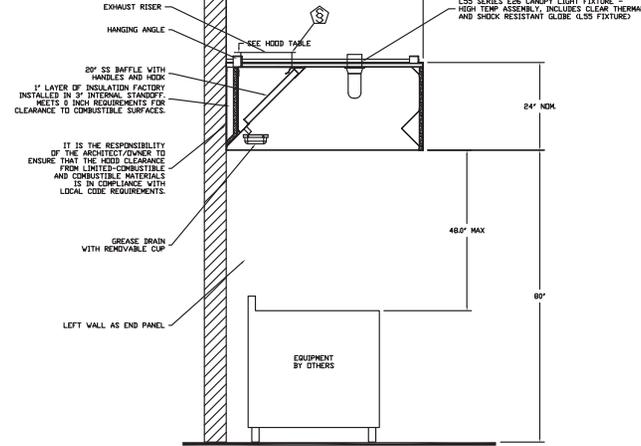

SECTION VIEW - MODEL 5424EX-2 HOOD - #1



REVISIONS	DESCRIPTION	DATE



TopSilog Bistro -
SAN JOSE, CA,

DATE: 9/30/2019
DWG.#: 4001167
DRAWN BY: TT-91
SCALE: 3/4" = 1'-0"
MASTER DRAWING

M-2
SHEET NO.
1

FOR QUESTIONS, CALL THE CAPTIVE-AIR SYSTEMS CENTRAL CALIFORNIA OFFICE

Region 91

8 ADRIAN COURT
BURLINGAME, CA 94010
PHONE: (415) 956-2200
EMAIL: REG9@CAPTIVEAIR.COM

ECON-AIR HOODS ARE BUILT IN COMPLIANCE WITH

UL LISTED 854804-001

KLEEN-GARD FILTERS ARE BUILT IN COMPLIANCE WITH

NFPA #96
NSF STANDARD #2
UL STANDARD #1066
INT. MECH. CLD-C (M)

EXHAUST FAN INFORMATION - Job#4001167

FAN UNIT NO.	TAG	FAN UNIT MODEL #	CFM	ESP.	RPM	H.P.	B.H.P.	#	VOLT	FLA	DISCHARGE VELOCITY	WEIGHT (LBS.)	SDNES
1		EABDU24HP	4000	1.000	886	1.500	1.1590	1	230	6.0	909 FPM	238	16.9

FAN #1 EABDU24HP - EXHAUST FAN

FAN OPTIONS


FAN UNIT NO.	TAG	OPTION (Qty. - Descr.)
1		1 - Grease Box
		1 - Fan Base Ceramic Seal - Installed At Plant - For Grease Ducts

FAN ACCESSORIES

FAN UNIT NO.	TAG	EXHAUST			SUPPLY		
		GREASE CUP	GRAVITY DAMPER	WALL MOUNT	SIDE DISCHARGE	GRAVITY DAMPER	MOTORIZED DAMPER
1		YES					

CURB ASSEMBLIES

NO.	DN FAN	WEIGHT	ITEM	SIZE
1	# 1	48 LBS	Curb	31.500"W x 31.500"L x 20.000"H Vented Hinged

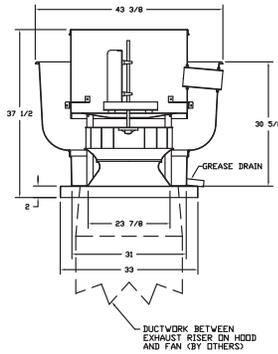

FEATURES:


- ROOF MOUNTED FANS
- RESTAURANT MODEL
- UL759 AND AL745 AND UL-C-5645
- ANCA SOUND AND AIR CERTIFIED
- WIRING FROM MOTOR TO DISCONNECT SWITCH
- WEATHERPROOF DISCONNECT
- HIGH HEAT OPERATION 300°F (149°C)
- GREASE CLASSIFICATION TESTING

NORMAL TEMPERATURE TEST
EXHAUST FAN MUST OPERATE CONTINUOUSLY WHILE EXHAUSTING AIR AT 300°F (149°C) UNTIL ALL FAN PARTS HAVE REACHED THERMAL EQUILIBRIUM AND WITHOUT ANY DETRIMENTARY EFFECTS TO THE FAN WHICH WOULD CAUSE UNSAFE OPERATION.


ABNORMAL FLARE-UP TEST
EXHAUST FAN MUST OPERATE CONTINUOUSLY WHILE EXHAUSTING BURNING GREASE VAPORS AT 600°F (316°C) FOR A PERIOD OF 25 MINUTES WITHOUT THE FAN BECOMING DAMAGED TO ANY EXTENT THAT COULD CAUSE AN UNSAFE CONDITION.

OPTIONS

GREASE BOX
FAN BASE CERAMIC SEAL - INSTALLED AT PLANT - FOR GREASE DUCTS.

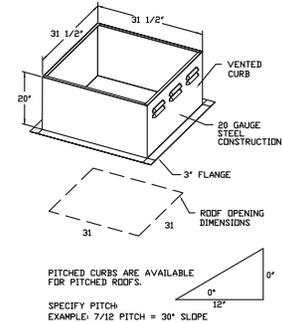

PHOENIX / FRIGIKING - DOWN DISCHARGE

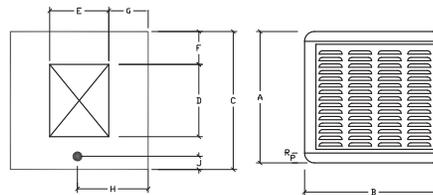

FEATURES

- ALL WELDED, HOT DIPPED GALVANIZED STEEL CABINET.
 - MULTILAYER BOTTOM PAN FINISH
 - PEBLAR XT ARCHITECTURAL FINISH
 - HEAVY DUTY MOTOR AND PUMP
- NOTES**
- RESIDENTIAL UNITS ARE 1 PHASE ONLY
 - MOTORS ARE SHIPPED LOOSE
 - COOLER CAN BE ORDERED AS A DOWN DISCHARGE OR END DISCHARGE

SUPPLY AIR UNIT DIMENSIONAL DATA

MODEL	CABINET DIMENSIONS											APPROX. WT.		
	A	B	C	D	E	F	G	H	J	K	P	R	OPER	SHIP
FRIGIKING 650FB	42.25	37	37	19.875	19.875	3.875	8.5625	8.5	5.25	-	-	-	290	177

FAN INFORMATION

FAN UNIT NO.	FAN UNIT MODEL #	EXHAUST FAN									SUPPLY FAN											
		MODEL	TAG	CFM	S.P.	RPM	H.P.	#	VOLT	FLA	BLOWER	HOUSING	TAG	CFM	S.P.	RPM	H.P.	#	VOLT	FLA		
2	PHOENIX / FRIGIKING MA-1													650FD	DOWN DISCH	3600	.5	446	.75	1	115	13.8



REVISIONS	DESCRIPTION	DATE

ECON-AIR
www.econair.com
Central CA
8 Adlan Court, Bellingham, CA 94910 PHONE: (415) 956-2200 FAX: (415) 927-5346 EMAIL: regff@econair.com



TopSilog Bistrotro -
SAN JOSE, CA,

DATE: 9/30/2019
DWG.#: 4001167
DRAWN BY: TT-91
SCALE: 3/4" = 1'-0"
MASTER DRAWING

M-3
SHEET NO. 2

ELECTRICAL PACKAGE - Job#4001167

NO.	TAG	PACKAGE #	LOCATION	SWITCHES		OPTION	FANS CONTROLLED				
				LOCATION	QUANTITY		TYPE	T	HP	VOL.	FLA
1		SC-C1001102	Wall Mount In SS Box	05 - SS Wall Mount Box	1 Light 1 Fan	Smart Controls Basic	Exhaust	1	1.500	230	6.0
							Supply	1	0.750	115	11.0

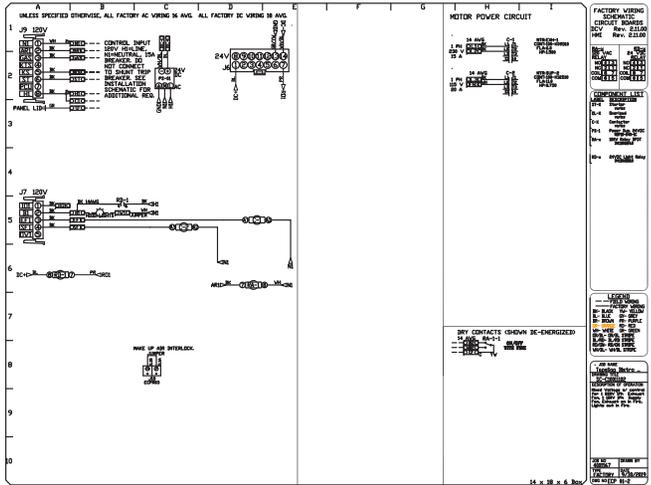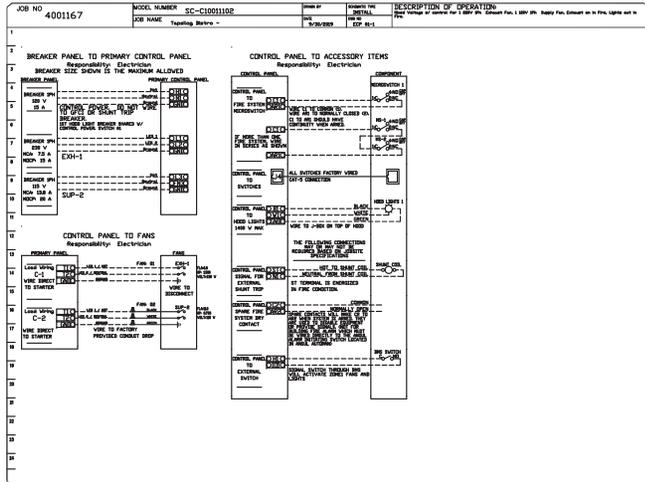


ELECTRICAL PACKAGE NOTES

- A PRE-WIRED ELECTRICAL CONTROL PACKAGE SHALL BE PROVIDED TO OPERATE THE HOOD LIGHTS AND FAN.
- MECHANICAL CONTRACTOR SHALL LOCATE AND MOUNT ELECTRICAL CONTROL BOX.
- MECHANICAL CONTRACTOR SHALL PROVIDE A 1/2" DIA. HOOD LIGHT AND FAN SWITCH CONNECTIONS AND A TERMINAL FOR BOILER-CAL FIRE STRIKE WIRE/CONTROL CONNECTION.
- THE HOOD IS WIRING TO BE MOUNTED ON THE HOOD FOR SUPPLY AIR SECTION AND OTHER ONLY. FOR ADDITIONAL FIRE STRIKE WIRE/CONTROL CONNECTIONS, THE HOOD SHALL BE PROVIDED WITH THE HOOD LIGHT AND FAN SWITCHES. THESE SWITCHES SHALL BE SUPPLIED BY THE ELECTRICAL CONTRACTOR.

NOTE: MECHANICAL CONTRACTOR SHALL LOCATE AND MOUNT ELECTRICAL CONTROL BOX.

LIGHT AND FAN SWITCHES CANNOT INTERFACE WITH HOOD LIGHTS AND EXHAUST FAN.

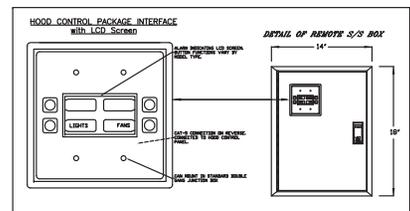

REVISIONS

NO.	DESCRIPTION	DATE
1		
2		
3		

Topsilog Bistrot -
 SAN JOSE, CA,

DATE: 9/30/2019
 DWG.#: 4001167
 DRAWN BY: TT-91
 SCALE: 3/4" = 1'-0"
 MASTER DRAWING

M-4
 SHEET NO. 3

GREASE TRAP SIZING FOR GT-1

FLOW RATE = NUMBER OF COMP. x L x W x D / 231 x 75% FILL FACTOR / DRAIN PERIOD	LENGTH (IN.)	WIDTH (IN.)	DEPTH (IN.)	BOWLS	LOAD(GAL)
3-COMPARTMENT SINK	18	18	12	3	38
PREP SINK (FLOOR SINK)	18	18	12	1	13
MOP SINK	20	20	12	1	16
ICE MACHINE (FLOOR SINK)					1
HAND SINK					3
FLOOR SINK					3
LOAD					74
FLOW RATE FOR 1-MINUTE PERIOD	GPM MINIMUM FLOW RATE				
REQUIRES A "POD" SIZE OF	GPM MINIMUM GREASE TRAP				
	DESIGNED GREASE TRAP CAPACITY (GPM/LBS)				
	75/95				
SIZING METHOD WAS BASED ON THE PDI RECOMMENDED GREASE TRAP SIZING, CPC, TABLE 1014.2.1					

GAS LOAD AND PIPE SIZING

ID	DESCRIPTION	BTU/Hr	PIPE SIZE
1	FRYER, DEEP FAT	120,000	1"
1	FRYER, DEEP FAT	120,000	1"
2	RANGE, GAS	227,000	1-1/4"
3.1	GRIDDLE 36", GAS	90,000	3/4"
3.2	GRIDDLE 24", GAS	60,000	3/4"
4	STOVE, STOCK POT	64,000	3/4"
4	STOVE, STOCK POT	64,000	3/4"
BRANCH TOTAL		745,000	2"
GW-1	WATER HEATER	55,000	
BRANCH TOTAL		55,000	3/4"
BRANCH TOTAL		800,000	2"

TOTAL LENGTH OF PIPE FROM THE GAS METER TO THE MOST REMOTE UNIT IS APPROX. 80 FEET
 1.5" x FOR ELBOWS = 120 FEET DEVELOPED LENGTH
 NATURAL GAS WITH 0.60 SPECIFIC GRAVITY.
 PRESSURE DROP OF 0.5" WC, GAS PRESSURE INLET OF 0.25 PSI, 7"WC OUTLET

WATER HEATER SIZING

BASED ON SANTA CLARA COUNTY DEPARTMENT OF ENVIRONMENTAL HEALTH - GUIDELINES FOR SIZING WATER HEATERS

FIXT. ID	DESCRIPTION OF EQUIPMENT	QTY.	DEMAND (GPH) @ 120°F	TOTAL (GPH)
SK-1	3-COMPARTMENT SINK	1	42	42
SK-2	PREP SINK	1	10	10
SK-3	HAND SINK	2	5	10
LV-1	LAVATORY	1	5	5
MS-1	MOP SINK	1	15	15
TOTAL				82

HOT WATER DEMAND	=	82	GPH
DISHWASHER DEMAND	=	0	GPH
HOT WATER DEMAND (SUB-TOTAL)	=	82	GPH
USAGE FACTOR FOR FOOD SERVICE	=	60	%
TOTAL HOT WATER DEMAND	=	49	GPH
WATER TEMP RISE	=	80	DegF

MINIMUM POWER FOR THE WATER HEATER

$BTU\ input = GPH \times Rise \times 8.33\ lb/gallon\ of\ water$		39984	BTU
$Thermal\ Efficiency$	=	82	EF

HOT WATER HEATER RECOMMENDED	=	55,000	BTU
STORAGE CAPACITY	=	48	GALLONS

COLD WATER PIPING SIZING VELOCITY NOT TO EXCEED 8 FEET PER SECOND

PIPE DIA	GPM	FT FIXT UNIT	FV FIXT UNIT	VELOCITY FPS
3/2"	5.8	6	---	8.0
3/4"	12.1	16	---	8.0
1"	20.6	30	---	8.0

PIPING INSULATION SCHEDULE

FLUID TEMPERATURE RANGE: 105-140(F°)
 PIPE SIZE: < 1" 1" TO <1.5" 1.5" TO < 4"
 INSULATION THICKNESS 1.0" 1.5" 1.5"
 ALL INSULATION SHALL HAVE R VALUES OF 4.0 TO 4.6 PER INCH

HOT WATER PIPING SIZING VELOCITY NOT TO EXCEED 6 FEET PER SECOND

PIPE DIA	GPM	FT FIXT UNIT	FV FIXT UNIT	VELOCITY FPS
3/2"	3.6	3	---	5.0
3/4"	7.5	8	---	5.0
1"	12.9	16	---	5.0

PLUMBING FIXTURE SCHEDULE

FIXTURE ID	DESCRIPTION	MANUFACTURER	MODEL	ROUGH-IN (Inches)						REMARKS
				W	V	CW	HW	G		
GW-1	GAS WATER HEATER	BRADFORD WHITE	UL02PV50H5 63N	-	-	3/4	3/4	3/4		48 GALLON CAPACITY, 56,000 BTU/HR GAS INPUT, ULTRA LOW NO 53 GALLONS FIRST HOUR RECOVERY, 3" EXHAUST VENT, NEEDS 110V ELECTRICAL. OUTLET FULL LINE SIZE T&P RELIEF DISCHARGE TO MOP SINK VIA 2" AIR GAP
FS-1	FLOOR SINK	ZURN	Z415D	SEE PLANS	2	-	-	-	-	12" x 12" RECEPTOR 6" SUMP DEPTH, WITH HALF GATE
FD-1	FLOOR DRAIN	ZURN	ZS-890	SEE PLANS	-	-	-	-	-	TYPE-B STRAINER, NICKEL BRONZE, DURA-COATED CAST IRON, NO-HUB WITH 1/2" TRAP PRIMER CONNECTION.
TP-1	TRAP PRIMER	PRECISION PLUMBING PRODUCTS	P2 500	-	-	1/2	-	-	-	CORROSION RESISTANT, INSTALL AT LEAST 12" ABOVE THE TRAP TO INSURE PROPER FLOW, 1/2" MALE INLET, 1/2" FEMALE OUTLET PROVIDE AND INSTALL ACCESS PANEL
WHA-1	WATER HAMMER ARRESTOR	MIFAB	MWH-A	-	-	1/2	-	-	-	1-11 FU, 1/2" MPT CONNECTION
WCO-1	WALL CLEANOUT	ZURN	ZN-146B	SAME AS PIPE	-	-	-	-	-	SAME AS PIPE, POLISHED BRONZE
ET-1	EXPANSION TANK	AMITROL	ST-5-C	-	-	3/4	-	-	-	2.0 GALLON CAPACITY; 0.45 ACCEPTANCE FACTOR 10 LBS TOTAL OPER. WT.
FCO-1	FLOOR CLEANOUT	ZURN	ZN-1400	SAME AS PIPE	-	-	-	-	-	SAME AS PIPE, BRONZE COVER
MV-1	MIXING VALVE	WILKINS	ZW3870XL1	-	-	1/2	-	-	-	SET OUTLET TEMPERATURE TO 110°F MAXIMUM, TO BE MOUNTED
MS-1	MOP SINK	FLORESTONE	87	3	2	1/2	1/2			FLOOR MOUNT, 24"x34"x12" DEEP WITH WALLMOUNT DELTA FAUCET # 2819, 8" CENTERS, 2 HANDLES, INTEGRAL STOPS, VACUUM BREAKER, HOSE-END SPOUT, WALL BRACKET.
RPZ-1	REDUCED PRESSURE ZONE ASSEMBLY	WATTS	SERIES 009	-	-	1/2	-	-	-	BRONZE BODY, DOUBLE CHECK VALVE AND DRAIN CONNECTION.
F-1	WATER FILTER	MANITOWOCK	ARCIC PURE 48-40000	-	-	1/2	-	-	-	LONG FILTER HOUSINGS, 1/2" INLET/OUTLET WITH SEDIMENT AND CARBON CARTRIDGE FILTERS MOUNT SET ABOVE FIBERGLASS FEEDER
GT-1	GREASE TRAP	THERMACO, TRAFZELLA	TZ-600 ECA	4"	2"					95 LBS CAPACITY, 75 GPM FLOW, 4" INLET/OUTLET WITH 1 MINUTE FLOW CONTROL DEVICE, PROVIDE WITH LID EXTENSION, DIAMOND SHAPE STAMPED COVER, VENT TO ROOF.

PLUMBING FIXTURE BY OTHERS (SHOWN FOR REFERENCE)

KITCHEN ITEM	FIXTURE ID	DESCRIPTION	MANUFACTURER	MODEL	W	V	CW	HW	G	REMARKS
11	SK-2	PREP SINK W/DRAINBOARD	SEE A-2 DRAWING		2"	1-1/2"	1/2"	1/2"		COORDINATE WITH OWNER FOR FAUCET REQUIREMENTS FAUCET WITH 1.5 GPM AERATOR
12	SK-1	3-COMP SINK	SEE A-2 DRAWING		3"	2"	1/2"	1/2"		PREP SINK 3 TUB WITH DRAIN BOARDS FAUCETS 2.2 GPM FLOW RATE AERATOR
10	SK-3	HAND SINK	SEE A-2 DRAWING		2"	1-1/2"	1/2"	1/2"		WITH CHICAGO 4" CENTERS SWING GOOSENECK SPOUT AND 0.5 AERATOR.

PLUMBING FIXTURE LOAD CALCULATION

KITCHEN ITEM NUMBER	FIXTURE ID	DESCRIPTION	QUANTITY	SANITARY F.U.		WATER F.U. COLD		WATER F.U. HOT	
				EACH	TOTAL	EACH	TOTAL	EACH	TOTAL
12	SK-1	3-COMPARTMENT SINK	1	3	3	3	3	3	3
11	SK-2	PREP-SINK	1	2	2	2	2	2	2
10	SK-3	HAND SINK	2	1	2	1	2	1	2
13	MS-1	MOP SINK	1	3	3	3	3	3	3
	LV-1	LV-1 (EXISTING)	1	1	1	1	1	1	1
	WC-1	WC-1 (EXISTING)	1	4	4	2.5	2.5	0	0
TOTAL					15		13.5		11.0

UTILITY LOAD

COLD WATER FIXTURES UNITS = 13.5
 HOT WATER FIXTURES UNITS = 11

SANITARY SEWER	MINIMUM SIZE REQUIRED	3"	19 FU
COLD WATER	MINIMUM SIZE REQUIRED	1"	(11.0CW + 11HW) x 0.75 + 2.5CW = 19 FU = 13.0 GPM

PROVIDE NEW 4" AND CONNECT TO EXISTING 4" SEWER LINE

PLUMBING LEGEND

SYMBOL	ABBREVIATION	DESCRIPTION
---	CW	COLD WATER PIPING
---	HW	HOT WATER PIPING
---	HWR	HOT WATER RETURN PIPING
---	TW	TEMPERED WATER PIPING
---	S OR W	SOIL OR WASTE PIPING
---	V	VENT PIPING
G	N	NATURAL GAS (LOW PRESSURE) PIPING
CD	CD	CONDENSATE DRAIN PIPING
D	D	INDIRECT DRAIN PIPING
WHA	WHA	WATER HAMMER ARRESTOR
P.O.C.	P.O.C.	POINT-OF-CONNECTION
---	---	CAPPED UNION
---	UP	PIPE UP
---	DN	PIPE DOWN
---	DN	PIPE TEE DOWN
---	BV	BALL VALVE
---	CV	CHECK VALVE
---	PUMP	PUMP
---	FCO	FLOOR CLEANOUT
---	WCO	WALL CLEANOUT
---	---	GAS COCK WITH UNION
---	AG	ABOVE GROUND
---	AF	ABOVE FINISHED FLOOR
---	BB	BELOW GROUND
---	(E)	EXISTING
---	IE	INVERT ELEVATION
---	(N)	NEW
---	QTY.	QUANTITY
---	V.T.R.	VENT THRU ROOF
---	BTU	BRITISH THERMAL UNITS
---	MBH	THOUSAND BTUS PER HOUR

MATERIAL SPECIFICATIONS

SERVICES	ABOVE GROUND	BELOW GROUND	TYPE M COPPER	TYPE L COPPER	TYPE K COPPER	ABS	PVC	REMARKS
COLD WATER	ABOVE GROUND	BELOW GROUND						
HOT WATER	ABOVE GROUND	BELOW GROUND						
WASTE	ABOVE GROUND	BELOW GROUND						1.2
VENT	ABOVE GROUND	BELOW GROUND						1.2
INDIRECT WASTE	INDOOR	OUTDOOR						

1. APPROVED ABS/PVC DWV PIPE IS OK IF PERMITTED BY LOCAL JURISDICTION.
 2. ABS/PVC DWV PIPE IS NOT PERMITTED INSIDE RETURN AIR PLUNUMS.

FIXTURE RATES (2016 CALIFORNIA GREEN BUILDING STANDARDS CODE)

FIXTURE TYPE	FLOW RATE
SHOWERHEADS	2.0 GPM @60 PSI
LAVATORY FAUCETS - NONRESIDENTIAL	0.5 GPM @60 PSI
KITCHEN FAUCETS	1.8 GPM @60 PSI
WASH FOUNTAINS	1.8 GPM (RM SPACE (N) @60 PSI)
METERING FAUCETS	0.20 GALLONS PER CYCLE
METERING FAUCETS FOR WASH FOUNTAINS	.20 G/CYCLE (RM SPACE (N) @60 PSI)
GRABBY TANK TYPE WATER CLOSETS	1.28 GALLONS/FLUSH
FLOUSHMETER TANK WATER CLOSETS	1.28 GALLONS/FLUSH
FLOUSHMETER VALVE WATER CLOSETS	1.28 GALLONS/FLUSH
ELECTROMECHANICAL HYDRAULIC WATER CLOSETS	1.28 GALLONS/FLUSH
URINALS	0.125 GALLONS/FLUSH

NOTE: THE EFFECTIVE FLUSH VOLUME OF ALL WATER CLOSETS SHALL NOT EXCEED 1.28 GALLONS PER FLUSH. TANK TYPE WATER CLOSETS SHALL BE CERTIFIED TO THE PERFORMANCE CRITERIA OF THE U.S EPA WATER SENSE SPECIFICATION FOR TANK-TYPE TOILETS.
 NOTE: THE EFFECTIVE FLUSH VOLUME OF DUAL FLUSH TOILETS IS DEFINED AS THE COMPOSITE, AVERAGE FLUSH VOLUME OF TWO DUAL FLUSHES AND ONE FULL FLUSH.

SHEET INDEX

SHEET NO.	DESCRIPTION
PO.1	FIXTURES, SCHEDULES AND CALCULATIONS
PO.2	GENERAL NOTES AND SPECIFICATIONS
PO.0	FLOOR PLANS - WASTE, VENT, WATER, GAS SUPPLY & DETAILS

REV. DATE NO. 12/19/15 PLAN CHECK 02/14/20

GAMA DRAFTING & ENGINEERING 37625 SYCAMORE ST NEWARK, CA 94660 gamadr@att.net

GLENN CUMMINGHAM, DESIGNER BULL'S EYE CADD 434 45TH AVENUE S SAN FRANCISCO, CA 94121 glemcc@att.net

T.I. - TAPSILOG BISTRO 1988 HOWESTEAD ROAD #121 SANTA CLARA, CA 95050

Date: 09/30/19
 Drawn: HP
 Sheet: P0.1

STATE OF CALIFORNIA
WATER HEATING SYSTEM GENERAL INFORMATION
 CEAC/PLB-01.6 (Revised 01/16) CALIFORNIA ENERGY COMMISSION
 CERTIFICATE OF COMPLIANCE NACC-PLB-01.6 (Page 1 of 2)

Water Heating System General Information
 11 TAPLOGO, BOSTON, SANTA CLARA
 1001019

A. GENERAL INFORMATION/SYSTEM INFORMATION

01 Water Heater System Type: WH1
 02 Water Heater System Configuration: Central System
 03 Water Heater System Type: Domestic Hot Water
 04 Building Type: Nonresidential
 05 Total Number of Water Heaters in System: 1
 06 Central Drive Distribution Type: Other
 07 Dwellling Unit DWH Distribution Type: Standard Distribution System (SDS)

B. WATER HEATER INFORMATION
 Each water heater type requires a separate compliance document.

01 Water Heater Type: Gas
 02 Fuel Type: Gas
 03 Manufacturer Name: BRACORDD SHVTS
 04 Model Number: 1810295353N
 05 Number of Identical Water Heaters: 1
 06 Installed Water Heater System Efficiency: 80%
 07 Required Minimum Efficiency: 80%
 08 Standby Loss Percent or Standby Loss Total: 1
 09 Rated Input: 51,000BTU/HK
 10 Pilot Energy: 0
 11 Water Heater Tank Storage Volume: 49 GAL
 12 Leaking Prevention or Water Return: 1
 13 Volume of Supplemental Storage: N/A
 14 External Insulation on Supplemental Storage: N/A
 15 Internal Insulation on Supplemental Storage: N/A

C. PLUMBING COMPLIANCE FORMS & WORKSHEETS
 Check box w/ worksheet is included.
 For detailed instructions on the use of this and all other Standards compliance documents, refer to the 2019 Nonresidential Water Heating and Distribution System Requirements documents to be incorporated into the building plans.

YES	NO	Doc/Worksheet #	Description
<input checked="" type="checkbox"/>	<input type="checkbox"/>	NACC-PLB-01.6	Certificate of Compliance, Declaration, Required on plans for all submittals.
<input checked="" type="checkbox"/>	<input type="checkbox"/>	NMO-PLB-01.6	Certificate of Installation, Required on plans for all submittals.
<input type="checkbox"/>	<input type="checkbox"/>	whs-plb-01.6	Certificate of Installation, required on central systems in high-rise residential, hotel/motel application.
<input type="checkbox"/>	<input type="checkbox"/>	NMO-PLB-21-H	Certificate of Installation, required on single dwelling unit systems in high-rise residential, hotel/motel application.
<input type="checkbox"/>	<input type="checkbox"/>	NMO-PLB-22-H	Certificate of Installation, required on HERS verified central systems in high-rise residential, hotel/motel application.
<input type="checkbox"/>	<input type="checkbox"/>	NMO-07A-01.6	Certificate of Installation, required on any solar water heating.

CA Building Energy Efficiency Standards - 2019 Nonresidential Compliance January 2019

STATE OF CALIFORNIA
WATER HEATING SYSTEM GENERAL INFORMATION
 CEAC/PLB-01.6 (Revised 01/16) CALIFORNIA ENERGY COMMISSION
 CERTIFICATE OF COMPLIANCE NACC-PLB-01.6 (Page 2 of 2)

Water Heating System General Information
 11 TAPLOGO, BOSTON, SANTA CLARA
 1001019

DOCUMENTATION AUTHORITY'S DECLARATION STATEMENT

I certify that you have complied with the requirements of the California Building Code and the California Energy Code for the project described above.

Signature: [Signature]
 Title: [Title]
 Date: 05/05/23

Address: 112525 Sacramento Street
 City: Newark, CA 94560
 Phone: 510.881.3339

RESPONSIBLE PERSON'S DECLARATION STATEMENT

I certify the following under penalty of perjury, under the laws of the State of California:

- The information printed on this Certificate of Compliance is true and correct.
- I am eligible under Section 1 of the Business and Professions Code to accept responsibility for the building design or system design indicated on the Certificate of Compliance responsible document.
- The energy features and performance specifications, materials, components, and manufactured devices for the building design or system design identified on this Certificate of Compliance conform to the requirements of Title 24, Part 1 and Part 1 of the California Code of Regulations.
- The building design features or system design features identified on this Certificate of Compliance are consistent with the information provided on other applicable compliance documents, worksheets, calculations, plans and specifications submitted to the enforcement agency for approval with this building permit application.
- I will ensure that a completed signed copy of this Certificate of Compliance shall be made available with the building permit issued for the building, and made available to the enforcement agency for all applicable inspections. I understand that a completed signed copy of this Certificate of Compliance is required to be included with the documentation the builder provides to the building owner at occupancy.

Signature: [Signature]
 Title: [Title]
 Date: 05/05/23

Address: 112525 Sacramento Street
 City: Newark, CA 94560
 Phone: 510.881.3339

CA Building Energy Efficiency Standards - 2019 Nonresidential Compliance January 2019

SEISMIC RESTRAINTS GUIDELINES FOR PIPING

- ALL SEISMIC RESTRAINTS SHALL BE INSTALLED IN STRICT ACCORDANCE WITH THE MANUFACTURER'S SEISMIC RESTRAINTS GUIDELINES AND ALL CERTIFIED SUBMITTAL DATA.
- TRANSVERSE BRACING SHALL NOT EXCEED 50 FEET UP TO 0.25g, 40 FEET UP TO 1.0g, AND 20 FEET UP TO 2.0g FOR STEEL AND COPPER PIPE WITH WELDED OR BRAZED CONNECTIONS. LONGITUDINAL BRACING SHALL NOT EXCEED 80 FEET UP TO 1.0g, AND 40 FEET UP TO 2.0g FOR STEEL AND COPPER PIPE WITH WELDED OR BRAZED CONNECTIONS.
- STEEL AND COPPER PIPE WITH SCREWED CONNECTIONS BRACE SPACING SHALL NOT EXCEED 1/2 THE SPACING LISTED IN NOTE 2 GUIDELINES FOR PVC, PVD, FRP, AND OTHER SPECIALTY PIPING. BRACE SPACING SHALL NOT EXCEED 1/2 THE SPACINGS LISTED IN NOTE 2. ALL PIPE MUST BE CONSIDERED FULL OF WATER WHEN DETERMINING SEISMIC BRACING REQUIREMENTS UNLESS SPECIFICALLY ENGINEERED OTHERWISE.
- TRANSVERSE RESTRAINTS FOR ONE PIPE SECTION MAY ALSO ACT AS A LONGITUDINAL RESTRAINT FOR A PIPE SECTION OF THE SAME SIZE CONNECTED PERPENDICULAR TO IT IF THE RESTRAINT IS INSTALLED WITHIN 24-INCHES OF THE ELBOW OR TEE OR COMBINED STRESSES ARE WITHIN ALLOWABLE LIMITS AT LONGER DISTANCES.
- HOLD DOWN CLAMPS MUST BE USED TO ATTACH PIPE TO ALL TRAPEZE MEMBERS BEFORE APPLYING RESTRAINTS.
- BRANCH LINES MAY NOT BE USED TO RESTRAIN MAIN LINES.
- PROVIDE REINFORCED CLEVIS BOLTS WHEN REQUIRED.
- PIPING CROSSING BUILDING SEISMIC OR EXPANSION JOINTS, PASSING FROM BUILDING TO BUILDING, OR SUPPORTED FROM DIFFERENT PORTIONS OF THE BUILDING SHALL BE INSTALLED TO ALLOW DIFFERENTIAL SUPPORT DEFLECTION WITHOUT DAMAGING THE PIPE, EQUIPMENT CONNECTIONS, OR SUPPORT CONNECTIONS. PIPE OFFSETS, LOOPS, ANCHORS, AND GUIDES SHALL BE USED AS REQUIRED TO PROVIDE SPECIFIED MOTION CAPABILITY AND LIMIT MOTION OF ADJACENT PIPING.
- PROVIDE APPROPRIATELY SIZED OPENINGS IN WALLS, FLOORS, AND CEILING FOR ANTICIPATED SEISMIC MOVEMENT. PROVIDE FIRE SEALS SYSTEMS IN FIRE-RATED WALLS.
- GAS PIPING LESS THAN 1" I.D. NEED NOT BE BRACED.
- WHERE RIGIDLY SUPPORTED PIPES ARE CONNECTED TO EQUIPMENT WITH VIBRATION ISOLATION, THESE CONNECTIONS SHALL BE INSTALLED TO ALLOW SEISMIC DISPLACEMENTS. CONVERSELY, WHEN SMALLER UNSUPPORTED PIPES ARE CONNECTED TO RIGIDLY SUPPORTED EQUIPMENT (i.e., COLS, etc.), THESE JOINTS MUST BE CAPABLE OF ACCOMMODATING MOVEMENT OF THE PIPES.
- RIGID PIPING SYSTEMS MAY NOT BE BRACED TO DISSIMILAR PARTS OF THE BUILDING OR TO DISSIMILAR BUILDING SYSTEMS WHICH MAY RESPOND DIFFERENTLY DURING AN EARTHQUAKE. DO NOT BRACE A SYSTEM TO TWO INDEPENDENT STRUCTURES SUCH AS CEILING AND WALL.
- SEISMICALLY RESTRAIN ALL FUEL OIL PIPING, GAS PIPING, MEDICAL GAS PIPING, AND COMPRESSED AIR PIPING FOR FLUE GAS, AND ALL GAS PIPING THAT IS 1" I.D. OR LARGER. TRANSVERSE RESTRAINTS MUST BE AT 20" MAXIMUM AND LONGITUDINAL RESTRAINTS AT 40" MAXIMUM SPACING.
- PIPING LOCATED IN BOILER ROOMS, MECHANICAL EQUIPMENT ROOMS, AND REFRIGERATION EQUIPMENT ROOMS THAT IS 1-1/4" I.D. AND LARGER MUST BE SEISMICALLY RESTRAINED.
- ALL OTHER PIPING 2-1/2" DIAMETER AND LARGER MUST BE SEISMICALLY RESTRAINED.
- SEISMIC RESTRAINTS MAY NOT BE USED FOR ALL PIPING SUSPENDED BY INDIVIDUAL HANGERS 12" OR LESS AS MEASURED FROM THE TOP OF THE PIPE TO THE BOTTOM OF THE SUPPORT WHERE THE HANGER IS ATTACHED. HOWEVER, IF THE 12" LIMIT IS EXCEEDED BY ANY HANGER IN THE RUN, SEISMIC BRACING IS REQUIRED FOR THE RUN.
- THE 12" EXEMPTION APPLIES FOR TRAPEZE SUPPORTED SYSTEMS IF THE TOP OF EACH ITEM SUPPORTED BY THE TRAPEZE QUARIES.
- WHERE THERMAL EXPANSION IS A CONSIDERATION, GUIDES AND ANCHORS MAY BE USED AS TRANSVERSE AND LONGITUDINAL RESTRAINTS PROVIDED THEY HAVE A CAPACITY EQUAL TO OR GREATER THAN THE RESTRAINT LOADS IN ADDITION TO THE LOADS INDUCED BY EXPANSION OR CONTRACTION.
- STEEL STRUTS SHALL BE 1-5/8" WIDE IN VARYING HEIGHTS AND MIG-WELDED COMBINATIONS AS REQUIRED TO MEET LOAD CAPACITIES AND DESIGNERS' INTENT. A MATERIAL, HEAT CODE, PART NUMBER, AND MANUFACTURER'S NAME SHALL BE STAMPED ON ALL STRUT AND FITTINGS TO MAINTAIN TRACEABILITY TO MATERIAL TEST REPORTS.
- SEISMIC RESTRAINTS FOR PIPING SYSTEMS WITH SHIELDING A LATERAL FORCE EQUAL TO SOLE OF THE WEIGHT OF THE PIPING SYSTEM AND ITS CONTENTS. SEISMIC BRACING SHALL CONFORM TO THE CURRENT ADOPTED EDITION OF THE CALIFORNIA BUILDING CODE AND THE ADMINISTRATIVE CODE, AND SHALL BE INSTALLED IN ACCORDANCE WITH SMACNA GUIDELINES FOR SEISMIC RESTRAINT, LATEST EDITION.
- SPECIAL PIPE HANGER AND SUPPORT PROVISIONS REQUIRED FOR CONTROL OF PIPE EXPANSION, VIBRATION, AND SOUND TRANSMISSION IN CERTAIN PIPING SHALL BE DONE IN ACCORDANCE WITH GOOD SOUND ATTENUATION PRACTICE.
- SUPPORT CHANNELS, FRAMES, BRACKETS, AND LESS OF SPECIAL SUPPORTS SHALL BE OF UNSURFUT, SUPERFUT, OR ACCEPTED EQUAL, WITH CHANNELS, ATTACHING CLIPS, PIPE CLAMPS, AND OTHER RELATED ACCESSORIES.
- PLASTIC PIPING SHALL BE SUPPORTED IN ACCORDANCE WITH CODE REQUIREMENTS (REVIEW WITH JURISDICTION). SHIMS SHALL BE PROVIDED TO PREVENT PIPE SAG BETWEEN FITTINGS.
- SPACING OF TRAPEZE HANGERS SHALL BE DETERMINED BY THE SMALLEST PIPE ON THE TRAPEZE. SPACING OF RODS FOR TRAPEZES SHALL BE GOVERNED BY THE LARGEST PIPE ON THE TRAPEZE.
- TRAPEZE HANGERS SHALL NOT BE LIGHTER THAN 16 GAUGE AND, WHEN EXPOSED TO WEATHER, NOT LIGHTER THAN 12 GAUGE. CLAMP THAT RUNS IN PARTITIONS AND IS NOT SUPPORTED FROM CEILING OR FLOOR SHALL BE SECURELY AND INDEPENDENTLY FASTENED TO THE PARTITION MEMBERS WITH PIPING OR BRACKETS.
- LATERAL MOTION OF PIPING WILL NOT CAUSE DAMAGE IMPACT WITH SURROUNDING SYSTEMS (e.g. OTHER PIPE, DUCT, EQUIPMENT, SPRINKLER HEADS, etc.) OR CAUSE LOSS OF SYSTEM VERTICAL SUPPORT.
- VERTICAL SUPPORT CONNECTIONS CANNOT DEVELOP MOMENTS (e.g. SWIVEL JOINTS, EYE BOLTS, VIBRATION ISOLATION HANGERS, etc.).
- VERTICAL CAST IRON RISERS ATTACHED WITH SHIELD AND CLAMP ASSEMBLIES MUST BE STIFFENED AT THE CONNECTION POINTS OF ANY UNSUPPORTED SECTION OF PIPE.
- VERTICAL RISERS IN AN OPEN SHAFT MUST BE ATTACHED TO THE SUPPORTS WITH CONNECTIONS SIZED TO ACCEPT THE HORIZONTAL SEISMIC LOADS.
- WHERE EARTHQUAKE LOADS ARE APPLICABLE IN ACCORDANCE WITH THE BUILDING CODE, PLUMBING PIPING SUPPORTS SHALL BE DESIGNED AND INSTALLED FOR THE SEISMIC FORCES IN ACCORDANCE WITH THE BUILDING CODE.
- HANGERS, ANCHORS AND SUPPORTS SHALL SUPPORT THE PIPING AND THE CONTENTS OF THE PIPING. HANGERS AND STRAPPING MATERIAL SHALL BE OF APPROVED MATERIAL THAT WILL NOT PROMOTE GALVANIC ACTION. HANGERS AND ANCHORS SHALL BE ATTACHED TO THE BUILDING CONSTRUCTION IN AN APPROVED MANNER.
- RIGID SUPPORT SKY BRACING SHALL BE PROVIDED AT CHANGES IN DIRECTION GREATER THAN 45 DEGREES FOR PIPE SIZES 4 INCHES AND LARGER.
- ANCHORAGE SHALL BE PROVIDED TO RESTRAIN DRAGGING PIPING FROM AXIAL MOVEMENT.
- FOR PIPE SIZES GREATER THAN 4 INCHES, RESTRAINTS SHALL BE PROVIDED FOR DRAIN PIPES AT ALL CHANGES IN DIRECTION AND AT ALL CHANGES IN DIAMETER GREATER THAN 2 PIPE SIZES.

PLUMBING SPECIFICATIONS AND AMENDMENTS SHALL GOVERN

- GENERAL PROVISIONS** - THE GENERAL CONDITIONS, SUPPLEMENTS AND AMENDMENTS SHALL GOVERN THE SCOPE OF THE SPECIFICATIONS.
- OBJECT REQUIREMENTS** - PROVIDE ALL ITEMS, MATERIALS, EQUIPMENT AND LABOR REQUIRED TO COMPLETE THE WORK OR OPERATIONS MENTIONED HEREIN, OR INDICATED ON THE DRAWINGS AND REASONABLY INFERRED THEREIN, AS REQUIRED TO MAKE A COMPLETE AND WORKING SYSTEM.
- INLET** - WORK SHALL BE DONE IN ACCORDANCE WITH THE DRAWINGS AND SPECIFICATIONS AND THEIR INTENT. COMPLETE WITH ALL NECESSARY COMPONENTS, INCLUDING THOSE NOT NORMALLY SHOWN OR CALLED FOR, AND SHALL BE READY FOR OPERATION BEFORE ACCEPTANCE.
- ALL WORK SHALL BE DONE IN ACCORDANCE WITH ALL APPLICABLE CODES. NOTHING SHOWN IN THE DRAWINGS OR SPECIFICATIONS SHALL BE CONSIDERED TO BE IN CONFLICT WITH ANY CODES OR CONNECTIONS OF ANY ITEM OR DEVICE SHOULD BE DONE CONTRARY TO MANUFACTURER'S INSTRUCTIONS AND ALL APPLICABLE CODES AND REGULATIONS. THE CONTRACTOR IS RESPONSIBLE TO ENSURE THAT THE INSTALLATION AND CONNECTIONS OF ALL ITEMS AND DEVICES CONFORMS TO MANUFACTURER'S INSTRUCTIONS AND TO ALL APPLICABLE CODES AND REGULATIONS.
- ANY REFERENCE TO THE DESIGN AUTHORITY SHALL MEAN GAA DRAFTING AND ENGINEERING.
- THE WORK "PROVIDE" SHALL MEAN "SUPPLY AND INSTALL" UNLESS OTHERWISE INDICATED.
- GOVERNING REGULATIONS** - THE WORK UNDER PLUMBING SCOPE OF WORK SHALL CONFORM, BUT NOT LIMITED TO THE REQUIREMENTS OF THE FOLLOWING CODES, REGULATIONS AND STANDARDS:
 - 2016 EDITIONS OF THE CALIFORNIA BUILDING CODE, INCLUDING BUT NOT LIMITED TO THE MECHANICAL, PLUMBING, FIRE AND ENERGY CODES.
 - OSHA REGULATIONS.
- PERMITS** - OBTAIN ALL REQUIRED PERMITS AND PAY ALL FEES THEREFOR AND COMPLY WITH ALL LOCAL AND STATE REGULATIONS, CODES AND BY-LAWS APPLICABLE TO THE WORK.
- RESPONSIBILITY** - VISIT THE SITE BEFORE SUBMITTING A BID AND EXAMINE ALL LOCAL AND EXISTING CONDITIONS ON WHICH THE WORK IS DEPENDENT.
- NO CONSIDERATION WILL BE GRANTED FOR ANY MISUNDERSTANDING OF WORK TO BE DONE RESULTING FROM FAILURE TO VISIT THE SITE.
- WHEN THE CONTRACT DOCUMENTS DO NOT CONTAIN SUFFICIENT INFORMATION FOR THE PROPER SELECTION OF EQUIPMENT FOR BIDDING, NOTIFY THE DESIGN AUTHORITY DURING THE BIDDING PERIOD. IF CLARIFICATION CANNOT BE OBTAINED, ALLOW FOR THE MOST EXPENSIVE ARRANGEMENT. FAILURE TO DO THIS SHALL NOT RELIEVE THE CONTRACTOR OF THE RESPONSIBILITY TO SUPPLY THE INTENDED EQUIPMENT AND/OR INSTALLATION.
- CHECK DRAWINGS OF ALL TRADES AND SITE SURVEY TO VERIFY SPACE AVAILABILITY FOR THE INSTALLATION. COORDINATE WORK WITH ALL TRADES AND MAKE CHANGES TO FACILITATE SATISFACTORY INSTALLATION. MAKE NO DEVIATIONS TO THE DESIGN INTENT INVOLVING EXTRA COST TO THE OWNER WITHOUT DESIGN AUTHORITY WRITTEN APPROVAL.
- WORKMANSHIP** - WORKMANSHIP SHALL BE IN ACCORDANCE WITH WELL ESTABLISHED PRACTICE AND STANDARDS ACCEPTED AND HONORED BY DESIGN AUTHORITY AND THE TRADE.
- EMPLOY ONLY TRADESMEN HOLDING VALID TRADE QUALIFICATION CERTIFICATES. TRADESMEN SHALL PERFORM ONLY THAT WORK THAT THEIR CERTIFICATE PERMITS.
- DRAWING AND MEASUREMENTS** - DRAWINGS ARE GENERALLY DIAGRAMMATIC AND ARE INTENDED TO INDICATE THE SCOPE AND GENERAL ARRANGEMENT OF WORK. DO NOT SCALE DRAWINGS.
- THE FIELD MEASUREMENTS WHERE EQUIPMENT AND MATERIAL DIMENSIONS ARE DEPENDENT UPON BUILDING DIMENSIONS.
- SUBMITTALS** - SUBMIT THREE SETS OF ALL EQUIPMENT AND RELATED MATERIAL FOR APPROVAL PRIOR TO ORDERING.
- BLOCKED DRAWINGS** - MAINTAIN ONE CONTRACT DRAWING, WHITE PRINT, ON SITE SOLELY FOR THE PURPOSE OF RECORDING, IN RED, ANY CHANGES AND/OR DEVIATION FROM THE CONTRACT DRAWINGS AS IT OCCURS.
- AT THE COMPLETION OF THE PROJECT, CERTIFY THE ABOVE-MENTIONED DRAWINGS AS BEING ACCURATE AND COMPLETE BY LABELLING IN THE LOWER RIGHT HAND CORNER IN LETTERS OF AT LEAST 1/4" HIGH AS FOLLOWS: "AS-BUILT DRAWINGS DATED ____ DELIVER TO DESIGN AUTHORITY."
- OPERATING AND MAINTENANCE MANUALS** - PREPARE INSTRUCTIONS MANUALS WHICH INCLUDE EQUIPMENT MANUFACTURER'S OPERATING AND MAINTENANCE BULLETINS, AND A REPORT ON THE TESTING AND BALANCING. SUBMIT THREE (3) COPIES TO DESIGN AUTHORITY.
- EXISTING SERVICES** - VERIFY AND PROTECT ALL EXISTING SERVICES AND MAKE GOOD ANY DAMAGE CAUSED BY THE WORK IN THIS CONTRACT.
- KEEP UP** - MAKE GOOD AND CLEAN ALL AREAS DISRUPTED BY THIS WORK.
- ARRANGEMENT AND ALIGNMENT OF PIPING:**
 - PIPING SHALL BE GROUDED (WHENEVER PRACTICAL) IN DIRECTION OF STRAIGHT PARALLEL LINES ALIGNED IN A UNIFORM DIRECT MANNER; CHANGES IN DIRECTION OF PIPING SHALL BE MADE WITH FITTINGS.
 - PIPE LINES SHALL BE GUIDED, SUPPORTED AND ANCHORED IN SUCH MANNER THAT PIPE LINES SHALL NOT SAG OR BUCKLE.
- JOINTS:**
 - PIPING TO EQUIPMENT SHALL BE CONNECTED WITH UNION FOR DISMANTLING AND REMOVAL.
 - PIPING SHALL BE BEARED AFTER CUTTING. JOINTS WHEN COMPLETE SHALL BE THOROUGHLY CLEANED OF ALL EXCESS PIPE JOINT MATERIALS.
 - PROVIDE DIELECTRIC FITTINGS BETWEEN DISSIMILAR PIPING CONNECTIONS.
- HANGERS AND SUPPORTS:**
 - PIPING EQUIPMENT, ETC., SHALL BE PROPERLY SUPPORTED WITH THE USE OF APPROVED TYPE CLEVIS AND/OR TRAPEZE HANGERS SPECIALLY SIZED 5'-0" ON CENTERS FOR CAST IRON PIPING AND 8'-0" ON CENTERS FOR WATER PIPING.
 - PIPING AND EQUIPMENT SHALL BE SUPPORTED FROM WALLS, JOISTS OR STRUCTURAL STEEL GIRDERS ONLY.
- PLUMBING FIXTURES:**
 - PLUMBING CONTRACTOR SHALL BE RESPONSIBLE FOR THE PROTECTION OF ALL FIXTURES INCLUDED IN THE CONTRACT FROM DAMAGE CAUSED BY ACES, BUILDING MATERIALS, TOOLS, EQUIPMENT, ETC. UPON COMPLETION OF THE CONTRACT, OR WHEN DIRECTED, PLUMBING CONTRACTOR SHALL CLEAN ALL FIXTURES TO THE SATISFACTION OF THE DESIGN AUTHORITY.
 - WHERE FIXTURES ARE DAMAGED, SAG FIXTURES SHALL BE REPLACED BY THE PLUMBING CONTRACTOR IMMEDIATELY UPON NOTIFICATION.
 - ALL EQUIPMENT FURNISHED BY OWNERS THAT REQUIRE PLUMBING CONNECTION SHALL BE INSTALLED BY THE PLUMBING CONTRACTOR. PROVIDE SHUT-OFF VALVE ON WATER SUPPLY WHERE REQUIRED BY CODE.
 - EQUIPMENT SHALL BE INSTALLED IN STRICT ACCORDANCE WITH MANUFACTURER'S INSTRUCTION.
 - FIXTURES SHALL BE SECURED WITH MOUNTING BOLTS FROM CARRIERS OR HANGERS.
 - FIXTURES SHALL BE INSTALLED LEVEL, PLUMB.
 - FIXTURES SHALL BE NEATLY INSTALLED, MOUNTED TO FIXTURES PRIOR TO INSTALLATION OF FIXTURES. PROVIDE NON-HARDENING PUTTY BETWEEN FITTINGS AND FIXTURE SURFACES.
 - FITTINGS SHALL BE SECURED WITHOUT MARRING OR DAMAGING CHROME PLATING.
- INSULATION:**
 - DOMESTIC HOT AND COLD WATER PIPING SHALL BE INSULATED WITH 1" THICK FLEXIBLE ELASTOMERIC PIPE INSULATION COMPLYING WITH ASTM G534.
 - INSULATION SHALL BE INSTALLED IN STRICT ACCORDANCE WITH MANUFACTURER'S INSTRUCTIONS.
 - INSTALLATION OF INSULATIONS SHALL BE DONE ONLY AFTER PIPING ARE TESTED AND DETERMINED TO BE FREE FROM LEAKS.

GENERAL NOTES

- PLUMBING CONTRACTOR DRAWINGS ARE IN PART DIAGRAMMATIC, COVERING THE SCOPE OF WORK ADDITIONAL ARRANGEMENT OF THE EQUIPMENT, PIPING, ETC., AND THE APPROXIMATE SIZE OF EQUIPMENT AND MATERIALS. THE CONTRACTOR SHALL FURNISH THESE DETAILS AND THE APPROXIMATE SIZE OF EQUIPMENT AND MATERIALS. CONTRACTOR SHALL CONSULT GENERAL, SPECIAL, HEATING/VENTILATING/AIR CONDITIONING CONTRACT AND ELECTRICAL DRAWINGS TO FURNISH DIMENSIONS THAT WORK AND TO VERIFY THE SPACES IN WHICH THE PLUMBING WORK WILL BE INSTALLED.
- BECAUSE OF THE NATURE AND SCALE OF THE DRAWINGS, CERTAIN BASIC PLUMBING ITEMS SUCH AS UNIONS, FITTINGS, ELBOWS, ETC., MAY NOT BE SHOWN. WHERE SUCH ITEMS ARE REQUIRED BY OTHER SECTIONS OF THE SPECIFICATIONS, OR WHERE THEY ARE REQUIRED BY THE NATURE OF THE WORK OR BY CODES AND REGULATIONS, THEY SHALL BE FURNISHED AND INSTALLED. THE CONTRACTOR SHALL VERIFY THE DRAWINGS INCLUDE ALL GENERAL, LOCAL, NATIONAL, AND STATE REGULATIONS, CODES AND STANDARDS. THE EXACT LOCATION TO BE DETERMINED BY THE CONTRACTOR TO BEET IT IN ACCORDANCE WITH THE SPECIFICATIONS.
- ALL EQUIPMENT SHALL BE THOROUGHLY COVERED AND PROTECTED AGAINST DIRT, WATER, AND CHEMICAL OR MECHANICAL INJURY OR THEFT. PLUMBING FIXTURES SHALL BE COVERED WITH HEAT PROOF COVERINGS AFTER INSTALLATION AND SHALL BE THOROUGHLY CLEANED AFTER COMPLETION OF THE PROJECT.
- ALL MATERIALS SUCH AS VALVES, FITTINGS, PIPING, EQUIPMENT, PUMPS, COLS, ETC., SHALL BE PROPERLY PROTECTED, AND ALL PIPING OPERATIONS SHALL BE TEMPORARILY COVERED BY THE CONTRACTOR FOR THE WORK UNDER HIS CHARGE, ON A DAILY BASIS, AT THE END OF EACH WORKING DAY, SO AS TO PREVENT OBSTRUCTION AND DAMAGE. (SEE SPECIFICATIONS REQUIREMENTS FOR PROTECTION).
- THE CONTRACTOR SHALL SEE THAT ALL MATERIALS, INSTALLATION AND WORKMANSHIP IS PERFORMED IN ACCORDANCE WITH THE LATEST EDITIONS OF ALL APPLICABLE CODES, LAWS OR ORDINANCES OF THE STATE OF ANY STATE, AND ALL CITY AND COUNTY ORDINANCES AND INSTALLATION OF PLUMBING WORK, AS WELL AS STATE AND LOCAL BOARD OF HEALTH, FLOORING AND STATE ENVIRONMENTAL PROTECTION REGULATIONS, STATE ENERGY CODES AND UTILITY REGULATORY AGENCIES.
- ALL WORK SHALL BE FURTHER PERFORMED IN ACCORDANCE WITH THE NATIONAL BOARD OF FIRE UNDERWRITERS, THE PLUMBING AND BUILDING CODES, NATIONAL ELECTRICAL CODE, THE OCCUPATIONAL SAFETY AND HEALTH ACT, THE AMERICAN GAS ASSOCIATION, AND ALL SUCH OTHER SPECIAL CODES AS MAY BE REFERRED TO IN THE INDIVIDUAL SECTIONS OF THE SPECIFICATIONS.
- PIPE SIZES SHOWN ON THE DRAWINGS ARE THE MINIMUM SIZES ALLOWED REGARDLESS OF THE CODE MINIMUM, EXCEPT WHERE THE CODE MINIMUM SIZE IS LARGER THAN THAT SHOWN.
- THE CONTRACTOR SHALL MAINTAIN A CORRECT SET OF CONTRACT PRINTS ON THE CONSTRUCTION SITE. AT ALL TIMES THROUGHOUT THE PROJECT, THE CONTRACTOR SHALL MAINTAIN THE ACTUAL, REVISED AND PLUMBING WORK, AS WELL AS APPROVED CHANGES, AND RECORDS OF THE PROJECT. THE CONTRACTOR SHALL BE RESPONSIBLE FOR ANY CHANGES OR OTHER INSTRUMENTS ISSUED BY THE ENGINEER.
- THE PLUMBING CONTRACTOR SHALL INCLUDE PROGRESS BY COLORING IN VARIOUS PIPES, FITTINGS, AND ASSOCIATED APPURTENANCES AS ERECTED DURING CONSTRUCTION.
- THE COMPLETION OF THE JOB THESE PRINTS, INCORPORATING CHANGES, ADDENDA AND ADDING DATA NOTED ON BIDDING-UP PRINTS, INCLUDING DIMENSIONS LOCATIONS OF UNDERGROUND PIPING BEYOND LIMITS OF BUILDING, SHALL BE SUBMITTED TO THE ENGINEER FOR REVIEW AND COMMENT. ALL PRINTS SHALL BE MARKED WITH APPROPRIATE COMMENTS AND RECOMMENDATIONS. THESE CORRECTED PRINTS TOGETHER WITH CORRECTED PRINTS, PRINTS AND CHANGES SHALL BE SUBMITTED TO THE ENGINEER FOR REVIEW AND COMMENT. WORK SHALL BE PROTECTED AS NOTED.
- WHERE SHOWN, OTHER PLUMBING APPROVEMENTS PASS THROUGH FIRE PARTITIONS, FIRE WALLS OR FLOORS, INSTALL A FIRE-STOP THAT PROVIDES AN EFFECTIVE BARRIER AGAINST THE SPREAD OF FIRE, SMOKE AND GASES. FIRE-STOP SHALL BE INSTALLED TO THE FULL HEIGHT AND COMPLETELY FULLY CLEANED BETWEEN RECEIVERS AND OPENINGS. FLOOR, EXTERIOR WALL, AND ROOF SLEAMS SHALL ALSO BE MADE WATER-TIGHT AS APPROVED BY THE ARCHITECT.
- ARRANGE AND INSTALL PIPING APPROPRIATELY AS INDICATED, STRAIGHT, PLUMB AND AS DIRECT AS POSSIBLE. FORM RIGHT ANGLES TO PARALLEL LINES WITH BULGING WALLS. KEEP PIPES CLOSE TO WALLS, PARTITIONS AND CEILING, OFFSETTING ONLY WHERE NECESSARY AND NOTING ALL OFFSETS AND INTERFERENCE WITH OTHER MECHANICAL ITEMS. LOCATE GROUPS OF PIPES PARALLEL TO EACH OTHER, SPACE THEM AT AN DISTANCE TO PERMIT ACCESS OR SERVICE WORK.
- PIPING SHALL BE PITCHED TO POINTS OF DRAINAGE WITH CONSTANT UNIFORM SLOPE.
- INSTALL HORIZONTAL PIPING AS HIGH AS POSSIBLE WITHOUT SACS OR HUMPS.
- GRADE DRAINAGE AT UNIFORM SLOPE OF NOT LESS THAN 1/4" PER FOOT TOWARD THE POINT OF DISPOSAL. WHEN APPROVED BY ADMINISTRATIVE AUTHORITY, PIPE SIZE 4" AND LARGER MAY BE SLOPE OF NOT LESS THAN 1/8" PER FOOT.
- WHERE CHANGES IN PIPE SIZES OCCUR, USE ONLY REDUCING FITTINGS.
- FOR DRAINAGE PIPING CHANGES IN DIRECTION, USE LONG SWEEP WHERE POSSIBLE. OTHERWISE, SHORT SWEEP 1/4" BENDS, OR COMBINATION ONE AND 1/2 BENDS, USE SWEEPY RE-BENDS ONLY FOR HORIZONTAL BRANCHES DISCHARGING TO STACKS.
- INSTALL SECTORIZING VALVES AND ON EACH BRANCH LINE TO MULTI-FLOOR GROUPS, LOCATE VALVES IN A READY ACCESSIBLE LOCATION TO BE OPENED FOR LEAKS AND REPAIRS. VALVES SHALL BE INSTALLED AND INDICATED ON PLANS. LOCATE ANGLE STOP VALVES BELOW THE SINK OR WATER CLOSET.
- WATER SUPPLY TO ALL FIXTURES AND DOWNSTREAM TO ALL FIXTURES SHALL BE INSTALLED AS POSSIBLE BACK OF POLLUTED WATER. ALL SUPPLIES SHALL BE EITHER ABOVE THE FLOOR OR IN A SEPARATE FLOOR OR UNDER FLOOR. EXCEPT BY AN APPROVED WORK ORDER.
- PROVIDE PIPING AND FLOOR TRAP TO PROTECT ALL EXISTING SERVICES AND MAKE GOOD ANY DAMAGE CAUSED BY THE WORK IN THIS CONTRACT.
- LAY ALL PIPING TIGHT TO LINE AND GRADE. FIT ENDS TOGETHER MATCH SO THAT SEWER OR DRAIN WORK HAVE SMOOTH AND UNIFORM INTERIOR. FLOOR LOCATIONS AND ELEVATIONS AT SITE, AS THE PIPE AND GRADE, AUTHORITY'S CLEAR INTERIOR OF CEILING, FLOOR AND OTHER FORM MATERIALS. DRAINING WORK STOPPING PERIODS, PROVIDE EFFECTIVE FLOOR COVERINGS FOR EACH END OF PIPE AND GRADE.
- PROVIDE CLEANOUTS WHERE INDICATED AND AT INTERVALS OF 100' OR AS REQUIRED BY LOCAL PLUMBING CODE AND WHERE REQUIRED AT CHANGES OF DIRECTIONS OF SOIL AND WASTE STACKS. INSTALL CLEANOUTS SO AS TO BE ACCESSIBLE FOR EASY REMOVAL AND TO PROVIDE CLEANOUTS FOR ROOMS. CLEANOUTS SHALL BE THE SAME SIZE AS PIPE SERVED EXCEPT THAT NO CLEANOUT NEED BE LARGER THAN FOUR INCHES.
- EXTEND VENT PIPES 12 INCHES ABOVE ROOF AND THE 180° TURN AWAY FROM ANY FRESH AIR INLET.
- SAFETY VENT PIPING SHALL BE GROUDED SO THAT THE 180° TURN TO THE OUTSIDE WILL BE CONTINUOUSLY UPWARD AND SO THAT NO LOW POINTS WILL BE DRAINED.
- MAKE TIGHT CONNECTION BETWEEN WATER CLOSET FLANGES AND FURNISHMENT FITTURE BY MEANS OF AN APPROVED METAL WIRE NUT OR SETTING COMPOUND AND BOLTING.
- VENTS: PROVIDE HOUSING FOR STACKS PASSED THROUGH ROOF. MAKE WATER-TIGHT AT ROOF WITH 4 SHEET LEAD. EXTEND INTO RAISING FELT AT LEAST 24" FROM PIPES. EXTEND LEAD COLAR UP ABOVE OUTSIDE AND TURN DOWN INSIDE VENTS AT THE TOP LOCATE VENT THROUGH ROOF 180° MINIMUM AWAY FROM ANY FRESH AIR INTAKE.
- ALL PLUMBING FIXTURES AND PIPING IS TO BE USED BY AN APPROVED LISTING AND TESTING AGENCY AND PROPERLY LABELED.
- COORDINATE ALL LOCATIONS, SIZES AND ELEVATIONS OF ALL SLICES THROUGH WALLS, BEAMS, SLABS AND FLOORING WITH STRUCTURAL AND ARCHITECTURAL DRAWINGS. ALL PIPES SLEWING THROUGH FLOORING SHALL HAVE A SLEAVE DIAMETER OF TWO PIPE SIZES OVER THE PIPE PASSING THROUGH THE FLOORING. NO PIPE TO BE PLACED THROUGH FLOORING UNLESS APPROVED BY THE STRUCTURE ENGINEER.
- ALL PIPES SHALL BE PROTECTED AT THE POINT THEY CROSS BUILDING EXPANSION JOINT, EITHER WITH AN EXPANSION FITTINGS OR IN ANOTHER MANNER ACCEPTABLE TO THE ENGINEER.
- PLUMBING CONTRACTOR SHALL OPERATE ALL GAS PIPING TO ALL GAS RELATED UTILITY PER PLAN WITH LISTED AND APPROVED GAS SHUT-OFF VALVES. SEWER, DRAIN, AND URN.
- FAULTY CONTRACTORS SHALL BE CORRECTED WITH ONE HAND AND SHALL NOT REQUIRE TYPING, GRINDING, OR POLISHING OF THE WORK. THE WORK REQUIRED TO ACTIVATE CONTROLS SHALL BE NO GREATER THAN 3 FEET.
- PLEASUREMENT OF FLOOR/CEILING ASSEMBLIES AND ASSEMBLIES REQUIRED TO HAVE A FIRE-RESISTANCE RATING SHALL BE PROTECTED IN ACCORDANCE WITH THE BUILDING CODE.
- WHERE WATER PRESSURE WITH A BUILDING EXCEEDS 80 PSI, AN APPROVED WATER-PRESSURE REDUCING VALVE CONFORMING TO ASSE 1003 WITH STRAINER SHALL BE INSTALLED TO REDUCE THE PRESSURE IN THE BUILDING WATER DISTRIBUTION PIPING TO 80 PSI STATIC OR LESS.
- DISSECTION OF POTABLE WATER SYSTEM SHALL COMPLY WITH THE LOCAL AND THE CALIFORNIA PLUMBING CODE.
- PROPER ACCESS MUST BE PROVIDED FOR THE INSPECTION AND MAINTENANCE OF THE BACKFLOW PREVENTER. IF THE BACKFLOW PREVENTER IS INSTALLED MORE THAN 5'-0" ABOVE THE FLOOR, SPECIAL PROVISIONS MUST BE MADE.
- ALL PIPING SHALL MAINTAIN A CLEAR 5'-0" CLEARANCE IN FRONT OF THE HUNG SUPPLY AND RETURN OUTLETS.
- CONTRACTOR IS REQUIRED TO SECURE THE EXISTING SANITARY SEWER LINE PRIOR OF WORK. IF REQUIRED, CONTRACTOR SHALL REMOVE ROOMS TO GUARANTEE FREE FLOWING OF THE EXISTING WASTE LINE AND NOTIFY THE ENGINEER IF THE EXISTING SANITARY SEWER LINE IS NOT ADEQUATE TO MEET THE INTENT LOCATIONS INDICATED ON THE PLANS.

REV. DATE NO.
 PLAN CHECK
 12/19/19

NO. M31187
 14-0000
 10/18/2019

ISSUED: 12/19/19


GLENN CUNNINGHAM, DESIGNER
 DRAFTING & ENGINEERING
 37625 SLOANWAY CT
 SAN FRANCISCO, CA 94131
 gamedrafting@sbcglobal.net
 (415) 866-3024
 (415) 866-3024
 emc@dmccat.net

GLENN CUNNINGHAM, DESIGNER
 BULL'S EYE CADD
 424 ALSTON AVENUE
 SAN FRANCISCO, CA 94112
 G. 415.696.3024
 E.M.C. @dmccat.net


THE INFORMATION ON THESE PLANS WAS PREPARED BY THE ARCHITECT OR ENGINEER REGISTERED IN THE STATE OF CALIFORNIA. THE ARCHITECT OR ENGINEER HAS EXAMINED THE PLANS AND IS NOT PROVIDING ANY GUARANTEE OR WARRANTY, EXPRESS OR IMPLIED, THAT THE PLANS WILL BE CONFORMANT WITH ALL APPLICABLE CODES, LAWS, ORDINANCES, REGULATIONS, AND STANDARDS. THE ARCHITECT OR ENGINEER IS NOT PROVIDING ANY GUARANTEE OR WARRANTY, EXPRESS OR IMPLIED, THAT THE PLANS WILL BE CONFORMANT WITH ALL APPLICABLE CODES, LAWS, ORDINANCES, REGULATIONS, AND STANDARDS. THE ARCHITECT OR ENGINEER IS NOT PROVIDING ANY GUARANTEE OR WARRANTY, EXPRESS OR IMPLIED, THAT THE PLANS WILL BE CONFORMANT WITH ALL APPLICABLE CODES, LAWS, ORDINANCES, REGULATIONS, AND STANDARDS.

T.J. - PISLOG BISTRO
 1988 HOMESTEAD ROAD #4121
 SANTA CLARA, CA 95050


Date: 09/30/19
 Drawn: HP
 Sheet: P0.2

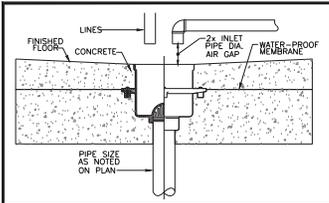


FLOOR SINK DETAIL SCALE: NONE 11

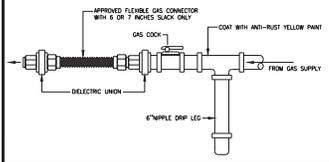


GAS CONNECTION SCALE: NONE 10

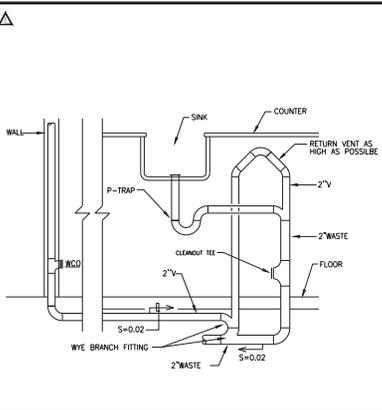


ISLAND VENT DETAIL SCALE: NONE 12

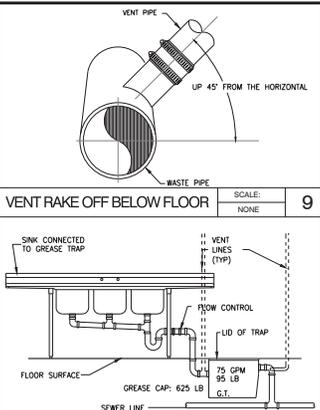


GREASE TRAP SCALE: NONE 8

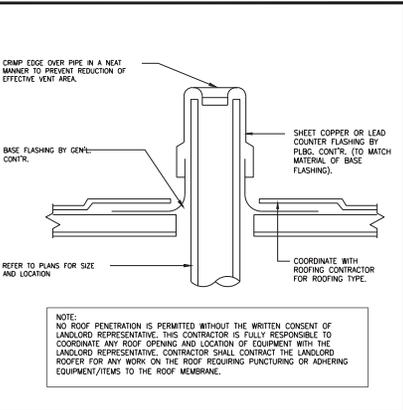


VENT THRU ROOF SCALE: NONE 7

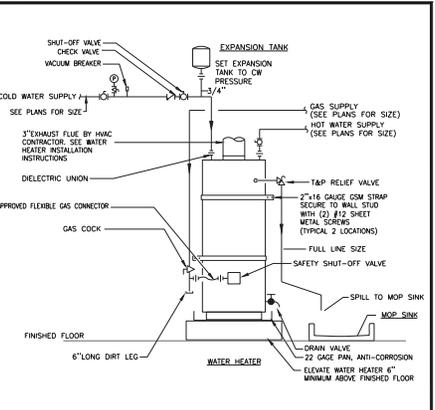


WATER HEATER DETAIL SCALE: NONE 6

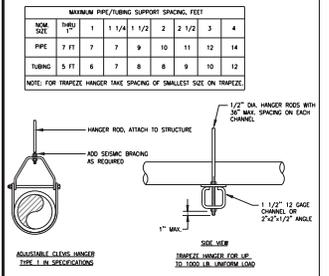


PIPE SUPPORT SCALE: NONE 5

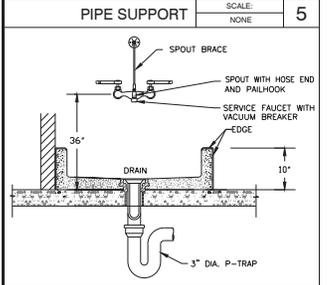


MOP SINK DETAIL SCALE: NONE 4

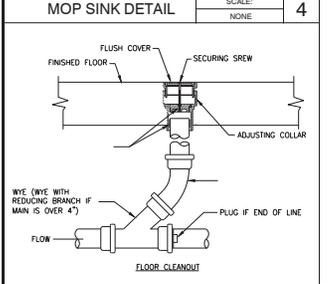

FLOOR CLEAN OUT SCALE: NONE 3

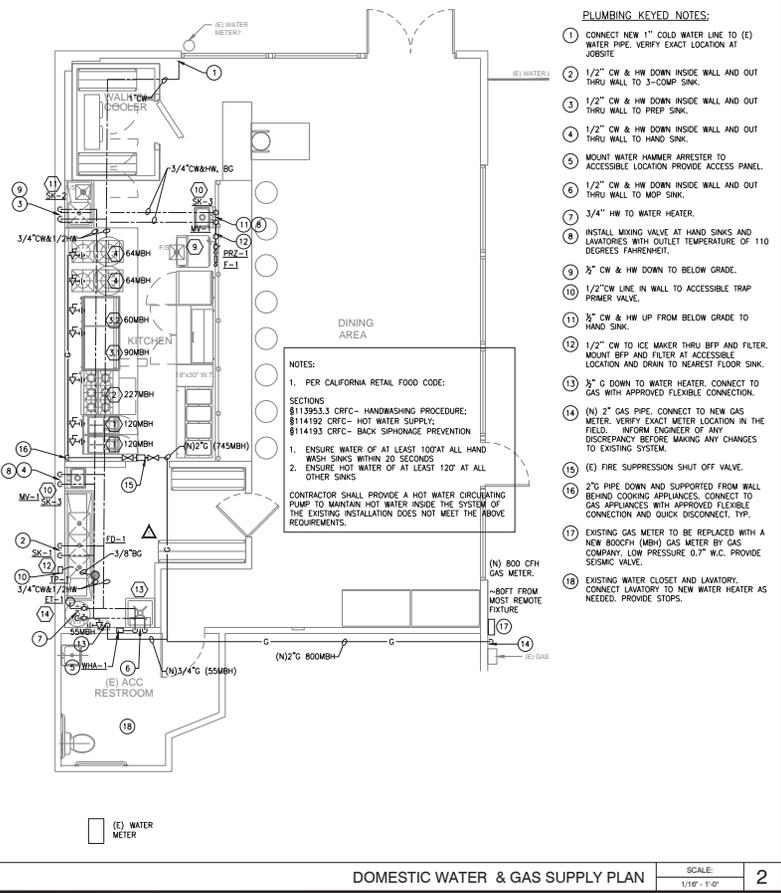

DOMESTIC WATER & GAS SUPPLY PLAN SCALE: 1/4\"/>

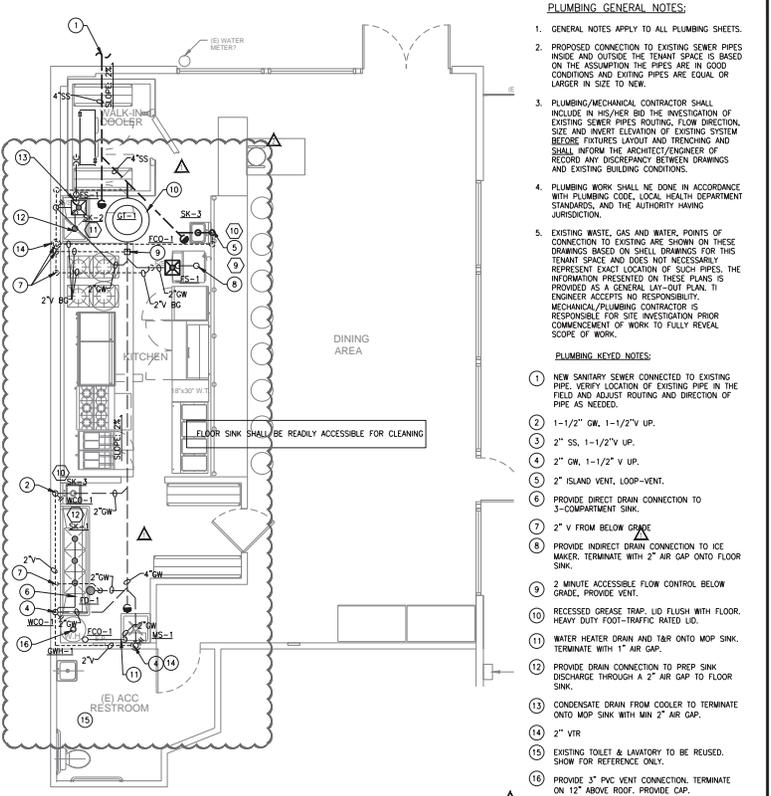

WASTE AND VENT PLAN SCALE: 1/4\"/>

- PLUMBING KEYED NOTES:
- CONNECT NEW 1" COLD WATER LINE TO (E) WATER PIPE. VERIFY EXACT LOCATION AT JOBSITE.
 - 1/2" CW & HW DOWN INSIDE WALL AND OUT THRU WALL TO 3-COMP SINK.
 - 1/2" CW & HW DOWN INSIDE WALL AND OUT THRU WALL TO HAND SINK.
 - 1/2" CW & HW DOWN INSIDE WALL AND OUT THRU WALL TO PREP SINK.
 - MOUNT WATER HAMMER ARRESTER TO ACCESSIBLE LOCATION PROVIDE ACCESS PANEL.
 - 1/2" CW & HW DOWN INSIDE WALL AND OUT THRU WALL TO MOP SINK.
 - 3/4" HW TO WATER HEATER.
 - INSTALL MIXING VALVE AT HAND SINKS AND LAVATORIES WITH OUTLET TEMPERATURE OF 110 DEGREES FAHRENHEIT.
 - 3/2" CW & HW DOWN TO BELOW GRADE.
 - 1/2" CW LINE IN WALL TO ACCESSIBLE TRAP PRIMER VALVE.
 - 3/2" CW & HW UP FROM BELOW GRADE TO HAND SINK.
 - 1/2" CW TO ICE MAKER THRU BFP AND FILTER. MOUNT BFP AND FILTER AT ACCESSIBLE LOCATION AND DRAIN TO NEAREST FLOOR SINK.
 - 3/2" G DOWN TO WATER HEATER. CONNECT TO GAS WITH APPROVED FLEXIBLE CONNECTION.
 - (N) 2" GAS PIPE. CONNECT TO NEW GAS METER. VERIFY EXACT METER LOCATION IN THE FIELD. INFORM ENGINEER OF ANY DISCREPANCY BEFORE MAKING ANY CHANGES TO EXISTING SYSTEM.
 - (E) FIRE SUPPRESSION SHUT OFF VALVE.
 - 2" G PIPE DOWN AND SUPPORTED FROM WALL BEHIND COOKING APPLIANCES. CONNECT TO GAS APPLIANCES WITH APPROVED FLEXIBLE CONNECTION AND QUICK DISCONNECT. TYP.
 - EXISTING GAS METER TO BE REPLACED WITH A NEW 800CFH (MBH) GAS METER BY GAS COMPANY. LOW PRESSURE 0.7" W.C. PROVIDE SEISMIC VALVE.
 - EXISTING WATER CLOSET AND LAVATORY. CONNECT LAVATORY TO NEW WATER HEATER AS NEEDED. PROVIDE STOPS.

- PLUMBING GENERAL NOTES:
- GENERAL NOTES APPLY TO ALL PLUMBING SHEETS.
 - PROPOSED CONNECTION TO EXISTING SEWER PIPES INSIDE AND OUTSIDE THE TENANT SPACE IS BASED ON THE ASSUMPTION THE EXISTING SYSTEM BEFORE FUTURES LAYOUT AND RENOVATING AND SHALL INFORM THE ARCHITECT/ENGINEER OF RECORD ANY DISCREPANCY BETWEEN DRAWINGS AND EXISTING BUILDING CONDITIONS.
 - PLUMBING/MECHANICAL CONTRACTOR SHALL INCLUDE IN HIS/HER BID THE INVESTIGATION OF EXISTING SEWER PIPES ROUTING, FLOW DIRECTION, SIZE AND INVERT ELEVATION OF EXISTING SYSTEM BEFORE FUTURES LAYOUT AND RENOVATING AND SHALL INFORM THE ARCHITECT/ENGINEER OF RECORD ANY DISCREPANCY BETWEEN DRAWINGS AND EXISTING BUILDING CONDITIONS.
 - PLUMBING WORK SHALL BE DONE IN ACCORDANCE WITH PLUMBING CODE, LOCAL HEALTH DEPARTMENT STANDARDS, AND THE AUTHORITY HAVING JURISDICTION.
 - EXISTING WASTE, GAS AND WATER, POINTS OF CONNECTION TO EXISTING ARE SHOWN ON THESE DRAWINGS BASED ON SHEET DRAWINGS FOR THIS TENANT SPACE AND DOES NOT NECESSARILY REPRESENT EXACT LOCATION OF SUCH PIPES. THE INFORMATION PRESENTED ON THESE PLANS IS PROVIDED AS A GENERAL LAY-OUT PLAN. THE ENGINEER ACCEPTS NO RESPONSIBILITY. MECHANICAL/PLUMBING CONTRACTOR IS RESPONSIBLE FOR SITE INVESTIGATION PRIOR COMMENCEMENT OF WORK TO FULLY REVEAL SCOPE OF WORK.
- PLUMBING KEYED NOTES:
- NEW SANITARY SEWER CONNECTED TO EXISTING PIPE. VERIFY LOCATION OF EXISTING PIPE IN THE FIELD AND ADJUST ROUTING AND DIRECTION OF PIPE AS NEEDED.
 - 1-1/2" CW, 1-1/2" V. UP.
 - 2" SS, 1-1/2" V. UP.
 - 2" CW, 1-1/2" V. UP.
 - 2" ISLAND VENT, LOOP-VENT.
 - PROVIDE DIRECT DRAIN CONNECTION TO 3-COMPARTMENT SINK.
 - 2" V FROM BELOW GRADE.
 - PROVIDE INDIRECT DRAIN CONNECTION TO ICE MAKER. TERMINATE WITH 2" AIR GAP ONTO FLOOR SINK.
 - 2 MINUTE ACCESSIBLE FLOW CONTROL BELOW GRADE. PROVIDE VENT.
 - RECESSED GREASE TRAP. LID FLUSH WITH FLOOR. HEAVY DUTY FOOT-TRAFFIC RATED LID.
 - WATER HEATER DRAIN AND T&B ONTO MOP SINK. TERMINATE WITH 1" AIR GAP.
 - PROVIDE DRAIN CONNECTION TO PREP SINK. DISCHARGE THROUGH A 2" AIR GAP TO FLOOR SINK.
 - CONDENSATE DRAIN FROM COOLER TO TERMINATE ONTO MOP SINK WITH MIN 2" AIR GAP.
 - 2" VTR
 - EXISTING TOILET & LAVATORY TO BE REUSED. SHOW FOR REFERENCE ONLY.
 - PROVIDE 3" PVC VENT CONNECTION. TERMINATE ON 12" ABOVE ROOF. PROVIDE CAP.

REV. DATE NO.
 PLAN CHECK 12/19/19
 PLAN CHECK 02/14/20
 GAMA DRAFTING & ENGINEERING
 3762 Sycamore St Newark, CA 94560
 gamedrafting@sbcglobal.net (916) 881-1310

GLENN CUNNINGHAM, DESIGNER
 BULL'S EYE CADD
 424 45TH AVENUE, STE 6
 SAN FRANCISCO, CA 94121
 E-MAIL: glenncc@att.net
 G: (415) 301-3005
 F: (415) 860-3024

T.I. - TAPSILOG BISTRO
 1988 HOMESTEAD ROAD #121
 SANTA CLARA, CA 95050
 Date: 09/30/19
 Drawn: HP
 Sheet: P2.0

**STUDS TABLE PER DIETRICH INDUSTRIES
(PER I.C.B.O. #4782)**

ALLOWABLE WALL HEIGHT L/120 DEFLECTION				L/240 DEFLECTION			
MEMBER	GAGE	SPSF		MEMBER	GAGE	SPSF	
		12	24			12	24
1-5/8"	STN 25	9-10	8-11	1-5/8"	STN 22	7-10	7-11
	SHT 22	11-5	10-4		SHT 22	8-0	8-2
	STE 20	12-11	11-0		STE 20	9-7	8-8
2-1/2"	STN 25	13-7	12-4	2-1/2"	STN 25	10-10	9-10
	SHT 22	15-8	14-6		SHT 22	12-6	11-4
	STE 20	16-10	15-4		STE 20	13-4	12-1
3-1/2"	STN 25	17-7	16-0	3-1/2"	STN 25	14-0	12-8
	SHT 22	20-5	18-4		SHT 22	16-2	14-8
	STE 20	21-10	19-10		STE 20	17-4	15-8
3-5/8"	STN 25	18-1	16-4	3-5/8"	STN 25	14-4	13-0
	SHT 22	22-0	19-0		SHT 22	16-7	15-2
	STE 20	22-5	20-4		STE 20	17-10	16-1
4"	STN 25	19-8	17-1	4"	STN 25	15-8	14-1
	SHT 22	22-7	20-7		SHT 22	18-0	16-4
	STE 20	24-2	22-0		STE 20	19-2	17-5
5-1/2"	STN 25	20-5	18-6	5-1/2"	STN 25	16-2	14-8
	SHT 22	23-2	21-2		SHT 22	18-2	16-8
	STE 20	24-1	22-5		STE 20	20-1	18-0
6"	STN 25	21-6	20-5	6"	STN 25	17-4	15-6
	SHT 22	24-4	22-7		SHT 22	19-7	17-9
	STE 20	25-6	23-7		STE 20	21-7	19-8

- NOTE 1** STEEL STUDS AND RUNNERS (TRACK) COMPLY WITH ASTM STANDARD C 645-70, STEEL SCREWS RECOMMENDED SPECIFICATION FOR THE APPLICATION AND FINISHING OF GYPSUM BOARD (GA-216)
- NOTE 2** FOR HEAVY DOORS INSTALLED IN PARTITIONS, IT IS RECOMMENDED THAT DOOR CLOSURES BE USED. FOR DOOR FRAME INSTALLATION IN FIRE RATED STEEL STUD PARTITIONS SEE SECTION V.
- NOTE 3** DESCRIPTION.
- NOTE 4** CALCULATIONS ARE BASED ON ALLOWABLE DESIGN STRESS OF 20,000 PSI.
- CONTRACTOR SHALL CONSULT WITH MANUFACTURER**
COMPLY WITH ASTM STANDARD C 1002 AND ARE SPACED IN ACCORDANCE WITH GYPSUM ASSOCIATION

STUD TABLE WHEN HEIGHTS EXCEED THOSE LISTED ABOVE.

**SECTION VI
LIMITING HEIGHTS (NONLOAD-BEARING)**


NOTE: THE LIMITING HEIGHT CALCULATIONS IN TABLE V ARE SPECIFIC TO 0.0209 INCH BASE METAL THICKNESS AND MAY NOT BE REPRESENTATIVE OF ALL NOMINAL 25 GAGE METAL STUDS AVAILABLE INT. THE MARKETPLACE. WHERE BASE METAL THICKNESS ARE UNKNOWN OR KNOWN TO BE LESS THAN 0.0209 INCH, CONSULT THE METAL STUDIO MANUFACTURER FOR LIMITING HEIGHTS.

MAXIMUM HEIGHT LIMITATIONS ARE GIVEN FOR SOME NONLOAD-BEARING PARTITIONS. IN INSTANCES WHERE NO HEIGHT LIMIT IS GIVEN FOR SPECIAL PURPOSE PARTITIONS, SUCH AS MOVABLE OR SHAFT WALL SYSTEMS, THE MANUFACTURER SHALL BE CONSULTED.


CRITERIA USED TO EVALUATE TRANSVERSE LOAD TESTS, CONDUCTED TO DETERMINE MAXIMUM HEIGHTS, ARE 5 POUNDS PER SQUARE FOOT FOR BOTH STRESS AND DEFLECTION REQUIREMENTS WITH A DEFLECTION LIMITATION OF HEIGHT DIVIDED BY 120 FOR GYPSUM BOARD AND HIGH STRENGTH GYPSUM VENEER FINISHES, AND HEIGHT DIVIDED BY 240 FOR GYPSUM OR METAL LATH AND PLASTER PARTITION HEIGHTS WITH GYPSUM BOARD, SCREW ATTACHED TO STEEL STUDS, ARE BASED UPON A COMPOSITE SECTION WITH STEEL STUDS COMPLYING WITH ASTM C 645-70 UNLESS OTHERWISE INDICATED.

A LIMITING HEIGHT IN EXCESS OF THAT SHOWN MAY BE OBTAINED BY USING A DEEPER STUD THAN THAT TESTED, BY SPACING THE STUDS CLOSER TOGETHER BY USING A HEAVIER GAGE STUD, OR BY ADDING AN ADDITIONAL PLY OF GYPSUM BOARD. TABLE VI MAY BE USED AS A GUIDE FOR GYPSUM BOARD AND HIGH STRENGTH GYPSUM VENEER FINISHES.


A HIGHER DEGREE OF DEFLECTION RESISTANCE FOR SOME APPLICATIONS MAY BE DESIRABLE SUCH AS FOR OFFICES AND INSTITUTIONAL BUILDINGS AS COMPARED TO INDUSTRIAL BUILDINGS. LOWER LIMITING HEIGHTS THAN THOSE BASED ON DEFLECTION AND STRESS CRITERIA MAY THEREFORE BE WARRANTED FOR IMPROVED PERFORMANCE AS RELATED TO HUMAN RESPONSE TO FLEXURE FROM IMPACT, OR TO

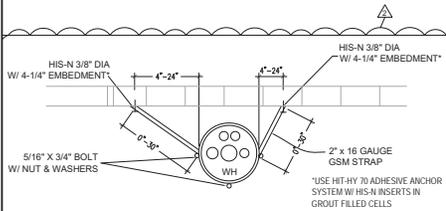


9 DETAIL - WATER HEATER STRAPPED TO WALL
N.T.S.

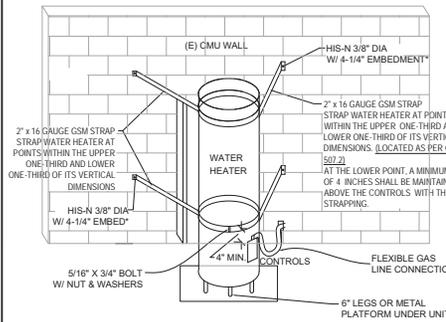


8 DETAIL - WATER HEATER STRAPPED TO WALL
N.T.S.

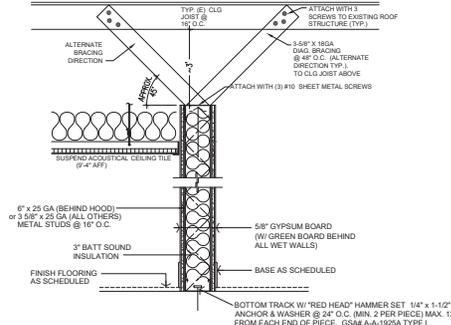


1 MTL STUD PARTITION WALL DETAIL
N.T.S.

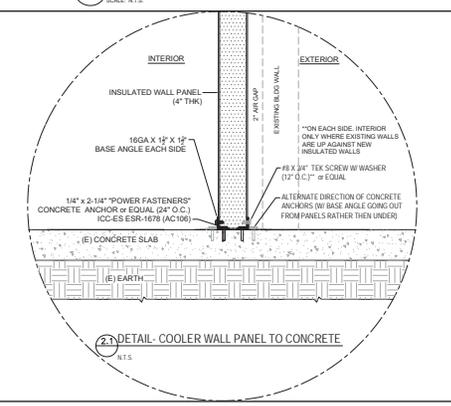


2 DETAIL - COOLER WALL PANEL TO CONCRETE
N.T.S.

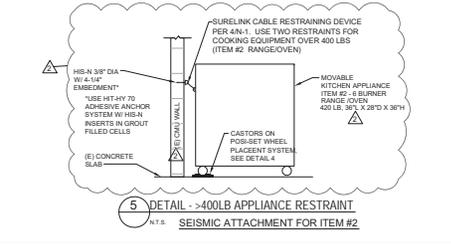

5 DETAIL - 400LB APPLIANCE RESTRAINT
N.T.S.

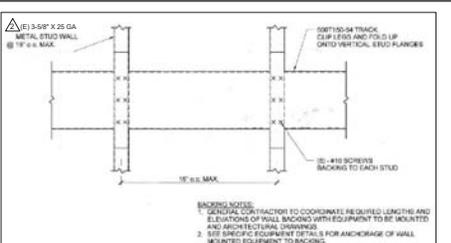

6 DETAIL - WALL BACKING
N.T.S.

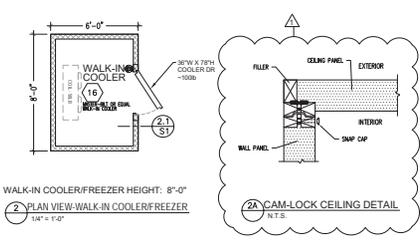

2A PLAN VIEW - WALK-IN COOLER/FREEZER
1/4" = 1'-0"

WALK-IN COOLER/FREEZER HEIGHT: 8'-0"

PANEL SPECIFICATIONS: (N.B.) WALLS, FLOOR, & CEILING - MASTER-BILT 4" THK. CLASS 1 FOAM-IN-PLACE URETHANE CAM-LOCK COOLER PANEL ON EQUAL (2.2 B-945).

R-VALUES: COOLER WALLS/CEILING/DOOR - R-25 min

FINISH: ALL WALLS & CEILING - 26 GA GALVALUM NEF PANELS COOLER FLOOR - EPOXY W/ COVED BASE. SEE SHEET EH-1

3 GAS EQUIPMENT RESTRAINT SYSTEM
N.T.S.

4 GAS EQUIPMENT RESTRAINT SYSTEM
N.T.S.

5 GAS EQUIPMENT RESTRAINT SYSTEM
N.T.S.

REV. DATE NO.
12/27/19 1
1/31/20 2

TAKAMI ENGINEERING GROUP, INC.
Herold E. Howell, P.E.
1041A Folger Ave., Berkeley CA 94710
510.549.0440 fax: 510.704.1975

GLENN CUNNINGHAM DESIGNER
BULL'S EYE CADD
434 45TH AVENUE
SAN FRANCISCO, CA 94111
E-MAIL: glenn@getnet.net

1988 HOMESTEAD ROAD #121
SANTA CLARA, CA 95050

T.I. - TAPSILOG BISTRO
1988 HOMESTEAD ROAD #121
SANTA CLARA, CA 95050

Date: 10/7/19
Drawn: GJC
Sheet: S-1

