




STEVENS CREEK SUBARU

3215 STEVENS CREEK BLVD.
SANTA CLARA, CA.

BAKHTIARI AUTO GROUP

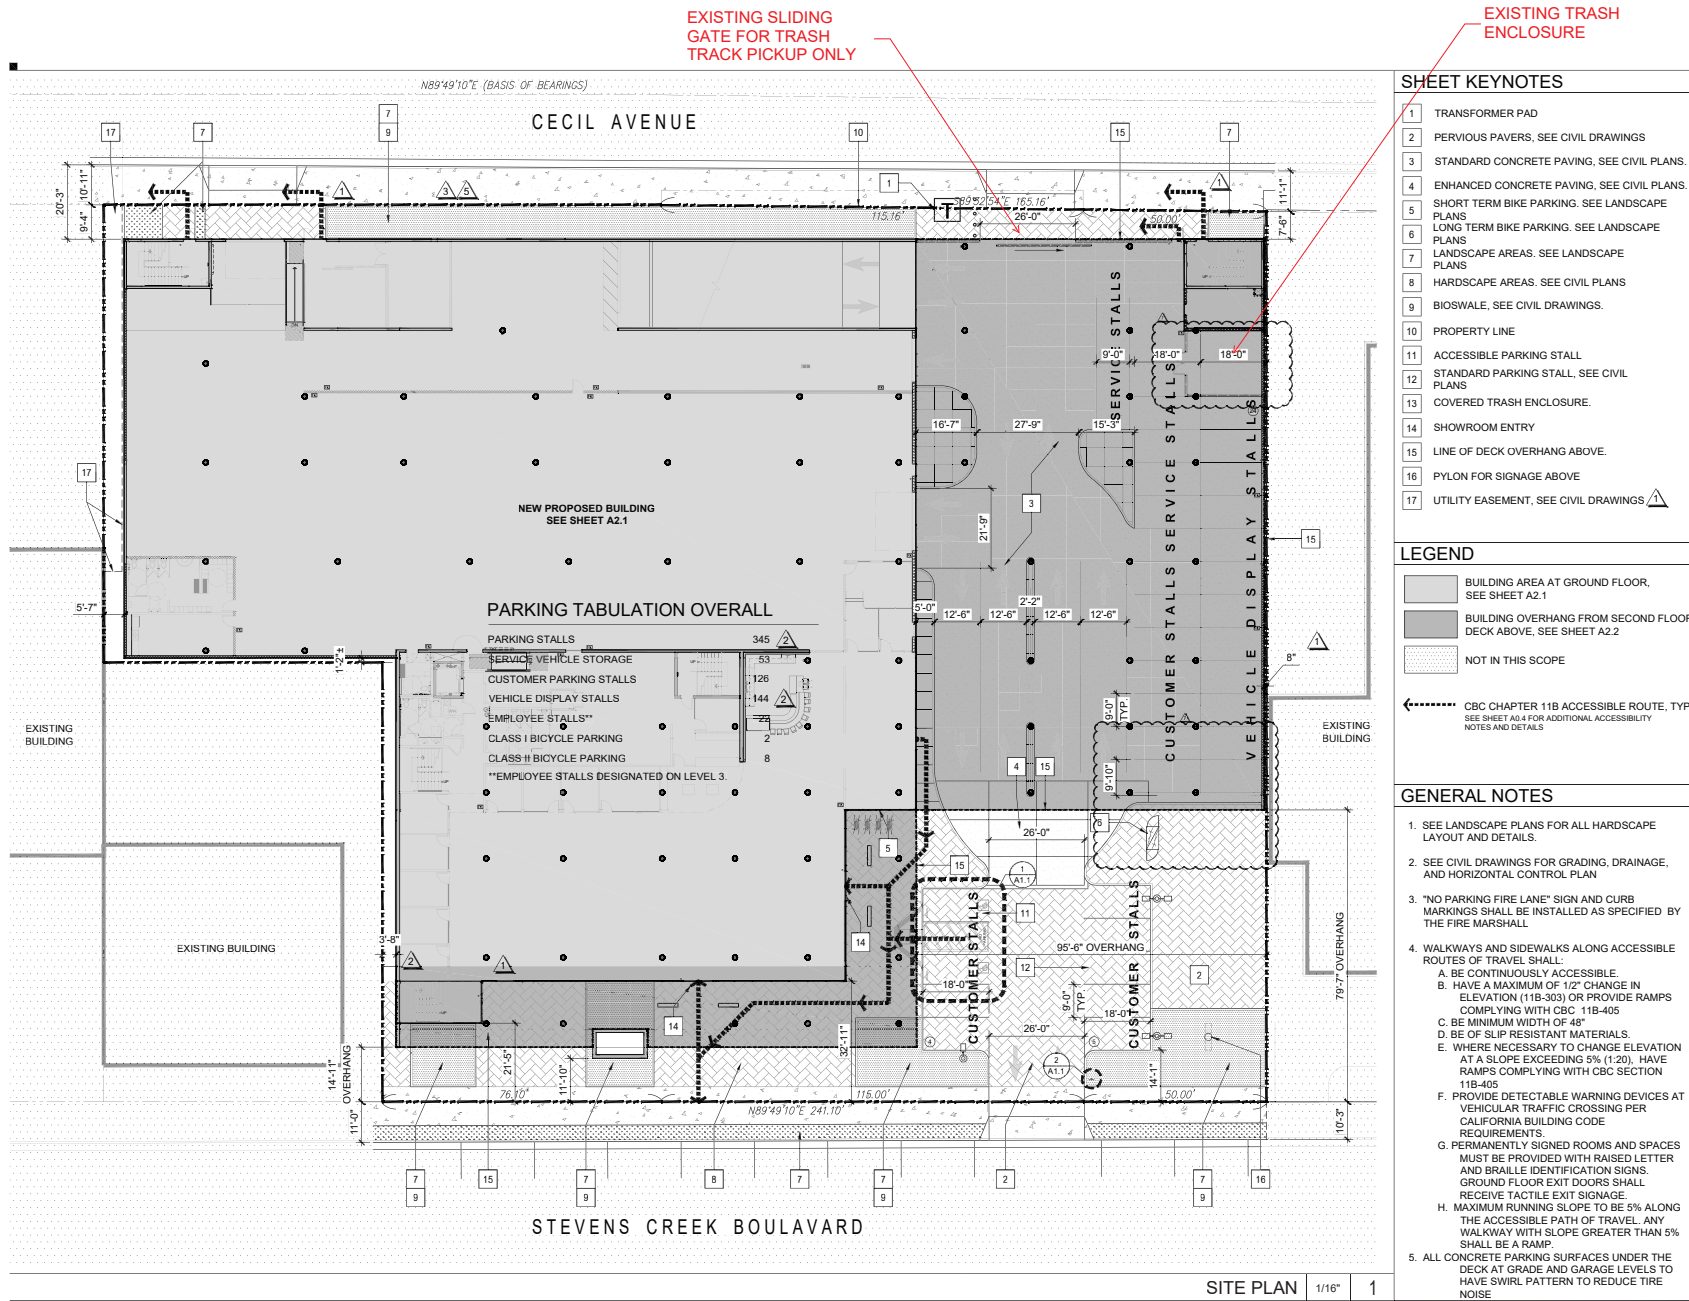

KENNETH RODRIGUES & PARTNERS INC.
440 NORTH WHITTIER ROAD, SUITE 200
MOUNTAIN VIEW, CA 95035-0700

CONSULTANT



KEYMAP



REVISION

08.16.16	BUILDING DEPARTMENT SUBMITTAL
10.31.16	PLAN CHECK 1 RESPONSE
12.22.16	PLAN CHECK 2 RESPONSE
3.24.17	PLAN CHECK 3 & OWNER REVISIONS
5.25.17	PLAN CHECK 4 & OWNER REVISIONS
08.10.17	PLANNING REVISION
10.08.18	OWNER REVISIONS

PROJECT NO. 30.604 DATE 08.16.16
DRAWN BY MV SCALE AS SHOWN
CHECKED BY

SITE PLAN

A1.0

© 2017 KENNETH RODRIGUES & PARTNERS, INC.