



## Agenda Report

25-1682

Agenda Date: 12/10/2025

### REPORT TO DEVELOPMENT REVIEW HEARING

#### SUBJECT

Public Hearing: Action of an Architectural Review (PLN25-00295) for a 621 Square Foot First Floor Addition and a 397 Square Foot Second Floor Addition to an Existing Two-Story 2,081 Square Foot Single-Family Residence with a 500 Square Foot Attached Garage on a 7,351 Square Foot Lot at 2892 Mesquite Drive. CEQA Status: Exempt from CEQA per Section 15332. Continued from the November 19, 2025, Development Review Hearing.

**File No.:** PLN25-00295

**Location:** 2892 Mesquite Drive

**Applicant:** Fiona Wang

**Owner(s):** Ling Zhou

**Request:** **Architectural Review** for a 621 square foot first floor addition and a 397 square foot second floor addition to an existing two-story 2,081 square foot single-family residence with a 500 square foot attached garage on a 7,351 square foot lot.

#### PROJECT DATA

The Project Data and Compliance Table is included as Attachment 3.

#### POINTS FOR CONSIDERATION

- This item was heard at the November 19, 2025, Development Review Hearing (DRH) but due to technical difficulties with Zoom it was continued to allow for community feedback to be received.
- The November 19, 2025 DRH staff report is available as Attachment 2.
- Based on community feedback submitted prior to the November 19, 2025 DRH, the front first story addition breaks the prevailing development pattern of the subdivision and creates shadow and view impacts to the neighboring properties.
- Based on this feedback, the applicant is open to adding privacy screening to their kitchen window, hedges to the front and side yard, and a code compliant front fence.
- The changes mentioned above will help refine the proposal and get the project closer to being consistent with the City's Single-Family & Duplex Residential Design Guidelines. Staff offers the following comments and recommendations to further enhance the project design to meet the required Architectural Review findings:
  - The proposed design should minimize, to the extent possible, shading of the adjacent home and front yard. The proposal has, scale, shadow, view, and light impacts. The

development proposal shall adhere to the prevailing development pattern in the subdivision by providing a greater front setback on the proposed guest bedroom. The proposed guest bedroom shall have a reduced footprint to preserve the streetscape along the front and sight lines of the adjacent property.

This recommendation has been added to the Conditions of Approval and will be found in Attachment 4.

### **FINDINGS SUPPORTING STAFF'S RECOMMENDATION**

Granting the Architectural Review approval requires the following findings consistent with City Code Section 18.120.020(F):

- 1) *That any off-street parking area, screening strips, and other facilities and improvements necessary to secure the purpose and intent of this title and the general plan of the City area a part of the proposed development, in that:*
  - The proposal is consistent with SCCC 18.38.060D as the garage still maintains the code compliant two parking spaces of at least 8.5 feet wide by 18 feet deep and
  - The proposed parking spaces are not located in the required front yard or side yard landscape areas as they are in the existing garage.
  - The vehicle parking is in an all-weather material surfaced area.
  
- 2) *That the design and location of the proposed development and its relation to neighboring developments and traffic is such that it will not impair the desirability of investment or occupation in the neighborhood, will not unreasonably interfere with the use and enjoyment of neighboring developments, and will not create traffic congestion or hazard, in that:*
  - The proposed construction would not create any traffic congestion or hazards.
  - The public streets are adequate in size to accommodate a single-family residence of this size.
  - The proposed design matches nearby residence in scale and would not impair the desirability of the neighborhood.
  
- 3) *That the design and location of the proposed development is such that it is in keeping with the character of the neighborhood and is such as not to be detrimental to the harmonious development contemplated by this title and the general plan of the City, in that:*
  - Building height and bulk is appropriate relative to the neighborhood.
  - Roof materials, building materials, and finishes work in conjunction with one another and consistent with the architectural style of the building.
  - Architectural features of the proposed design are true to the architectural form and appropriate for the neighborhood.
  - A tree will remain in the front yard to provide shade, soften the building, improve the streetscape, and comply with the City's Climate Action Plan.
  
- 4) *That the granting of such approval will not, under the circumstances of the particular case, materially affect adversely the health, comfort or general welfare of persons residing or working in the neighborhood of said development, and will not be materially detrimental to the public welfare or injuries to property or improvements in said neighborhood, in that:*

- The project is subject to the California Building Code and City Code requirements. Which serve to regulate new construction to protect public health, safety, and general welfare.

5) *That the proposed development, as set forth in the plans and drawings, are consistent with the set of more detailed policies and criteria for architectural review as approved and updated from time to time by the City Council, which set shall be maintained in the planning division office. The policies and criteria so approved shall be fully effective and operative to the same extent as if written into and made a part of this title, in that:*

- With adherence to condition P3 of the Conditions of Approval, the proposed construction is consistent with the City's Single-Family & Duplex Residential Design Guidelines (2014):
  - As conditioned, the project would create a house design that is compatible in scale and character with the housing types that are typical in the neighborhood as the proposed design will have similar massing to the adjacent properties.
- The proposed construction complies with the R1-6L Zoning Districts development standards.
- The proposed construction complies with the intent of the Santa Clara General Plan and all its policies.

### CONDITIONS OF APPROVAL

Conditions of approval are proposed for the project and are contained in Attachment 4.

### ENVIRONMENTAL REVIEW

The action being considered is categorically exempt from the California Environmental Quality Act (CEQA) pursuant to CEQA Guidelines Section 15332 (Class 32 - Infill Development Projects), in that the project site is less than five acres, served by utilities, and complies with the General Plan.

### PUBLIC CONTACT

Public contact was made by posting the Development Review Hearing agenda on the City's official-notice bulletin board outside City Hall Council Chambers. A complete agenda packet is available on the City's website and in the City Clerk's Office. A hard copy of any agenda report may be requested by contacting the City Clerk's Office at (408) 615-2220, email [clerk@santaclaraca.gov](mailto:clerk@santaclaraca.gov) or at the public information desk at any City of Santa Clara public library.

A public hearing notice was mailed to property owners within a 300-foot radius of the project site on November 26, 2025, to 67 owners/tenants. As of the writing of this report, planning staff has not received public comments for this application.

### RECOMMENDATION


**Determine** the project to be exempt from the California Environmental Quality Act (CEQA) formal pursuant to CEQA Guidelines Section 15332 (Class 32 -- Infill Development Projects), and **Approve** the Architectural Review for the construction of a 621 square foot first floor addition and a 397 square foot second floor addition to an existing two-story 2,081 square foot single-family residence with a 500 square foot attached garage on a 7,351 square foot lot at 2892 Mesquite Drive, subject to findings and conditions of approval.

Prepared by: Alex Tellez, Assistant Planner, Community Development Department  
Approved by: Sheldon S. Ah Sing, Development Review Officer, Community Development Department

**ATTACHMENTS**

1. Vicinity Map
2. November 19, 2025 DRH Staff Report
3. Project Data and Compliance Table
4. Conditions of Approval
5. Development Plans

# Vicinity Map (Zoning) - 2892 Mesquite Drive

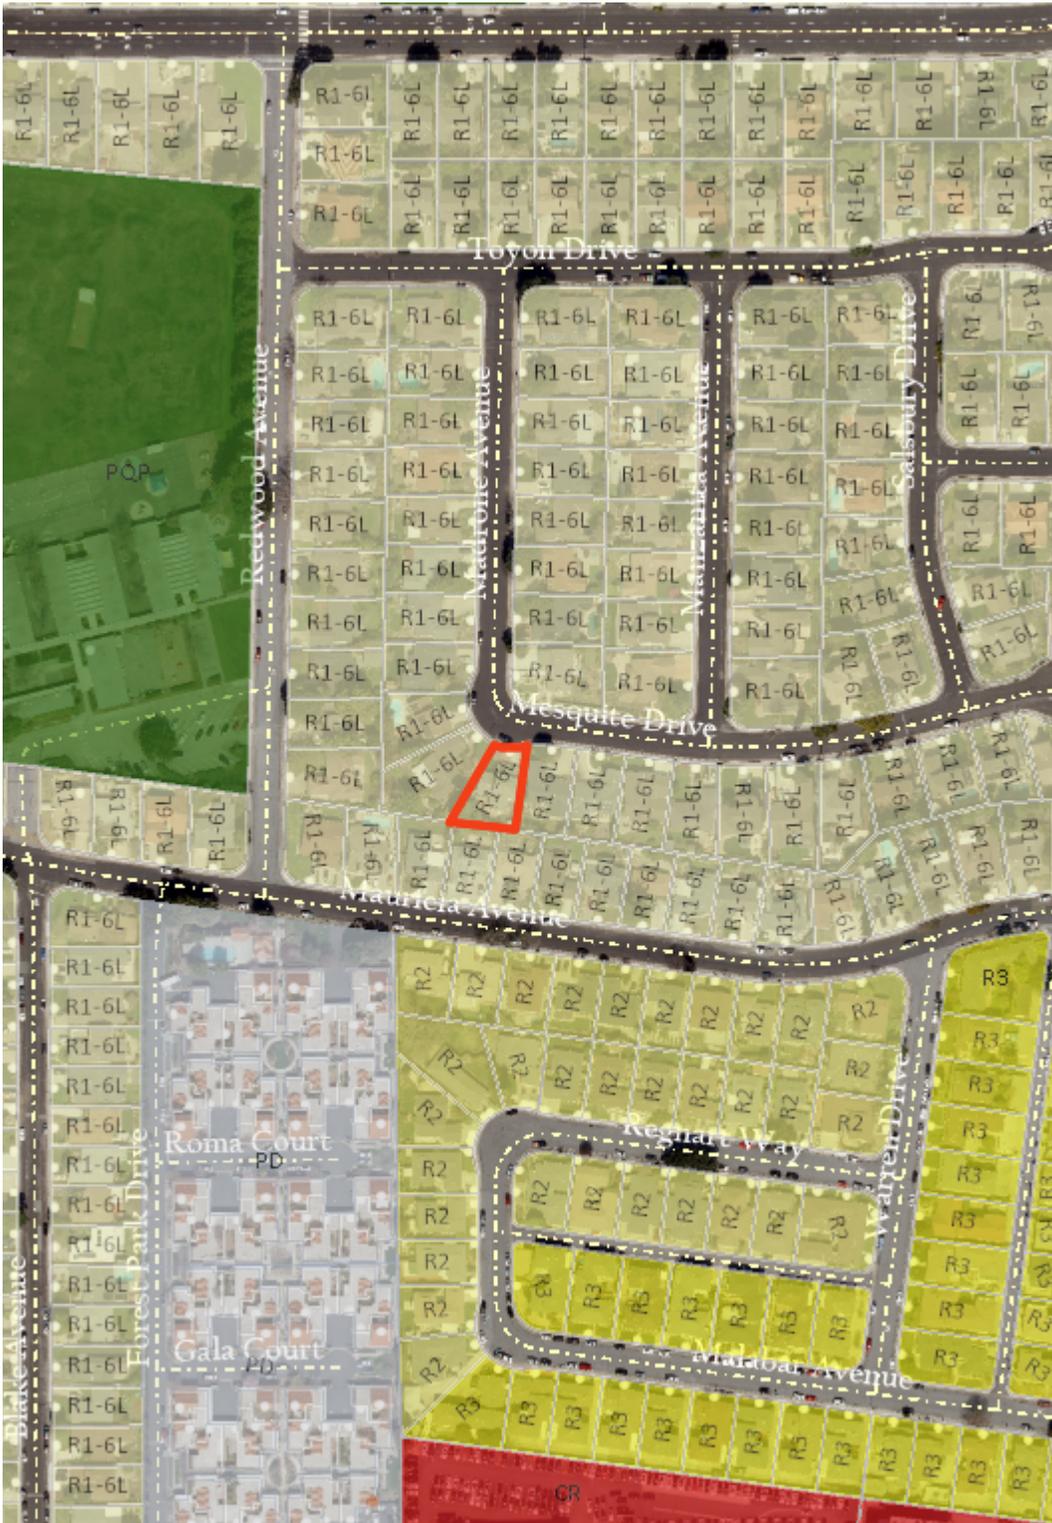

**Zoning**

Land Parcels

 CR - Commercial Regional

**Base Layers**

Site Addresses

• Place

• Single

• Utility

Streets

Land Parcels

 Land Parcels

 Common Areas

**Imagery2024**

 Red: Band\_1

 Green: Band\_2

 Blue: Band\_3

**Notes:**

PLN25-00295

10/29/2025 3:28:33 PM



This map is a user generated static output from an Internet mapping site and is for reference only. Data layers that appear on this map may or may not be accurate, current, or otherwise reliable.



## Agenda Report

25-1589

Agenda Date: 11/19/2025

### REPORT TO DEVELOPMENT REVIEW HEARING

#### SUBJECT

Public Hearing: Action on an Architectural Review (PLN25-00295) for a 621 Square Foot First Floor Addition and a 397 Square Foot Second Floor Addition to an Existing Two-Story 2,081 Square Foot Single-Family Residence with a 500 Square Foot Attached Garage on a 7,351 Square Foot Lot at 2892 Mesquite Drive. CEQA Status: Exempt from CEQA per Section 15332.

**File No.:** PLN25-00295

**Location:** 2892 Mesquite Drive

**Applicant:** Fiona Wang

**Owner(s):** Ling Zhou

**Request:** **Architectural Review** for a 621 square foot first floor addition and a 397 square foot second floor addition to an existing two-story 2,081 square foot single-family residence with a 500 square foot attached garage on a 7,351 square foot lot.

#### PROJECT DATA

The Project Data and Compliance Table is included as Attachment 2.

#### POINTS FOR CONSIDERATION

- The proposed project is in a residential tract that consists of single-story and two-story residences built in the ranch style architectural style popular in the 1960s as shown in the Vicinity Map on Attachment 1.
- The site consists of a two-story raised ranch style four-bedroom, two-bathroom residence built in 1955.
- There are no significant historical features in the existing residence other than the structure's age therefore not eligible to be designated a Historical Resource under Santa Clara City Code ("SCCC") 18.130.030.
- Per SCCC 18.120.020(D)(1), the request to expand an existing second story element requires Architectural Review approval through a Development Review Hearing.
- The result of the project will be a 3,164 square foot five-bedroom, five-bathroom two-story residence with a 500 square foot attached garage.
- The applicant proposes to change the architectural design of the existing residence from a raised ranch style to a contemporary eclectic architectural style with gable roofs and minimalistic massing.
- The proposed construction will consist of new stone coated metal tile roofing, masonry stucco, and stone veneer wainscoting.
- The project is consistent with the City's Single-Family & Duplex Residential Design Guidelines ("Residential Guidelines") (2014):
  - Building height and bulk is appropriate relative to the neighborhood.

- The architectural features of the proposal are appropriate for the neighborhood
- The roof materials, building materials, and finishes work in conjunction with one another and are consistent with the architectural style of the building.
- The entry feature's height as proposed is higher than the rest of the first floor roof line. Staff recommends that the height of the entry feature be reduced to match the rest of the first floor or be below it. This recommendation will be added as a Condition of Approval.
- The design went through multiple revision to ensure compliance with the SCCC and the Residential Guidelines. The roof form was simplified through the removal of a gable element by the front bay window, wainscoting was added on the front elevation, and the entry feature's size & height was reduced.
- The proposed project meets the required findings set forth in Santa Clara City Code 18.120.
- There are no active City code enforcement cases for this property.
- A neighborhood notice was distributed within a 300-foot radius of the subject site for this project review.

#### **FINDINGS SUPPORTING STAFF'S RECOMMEDATION**

Granting the Architectural Review approval requires the following findings consistent with City Code Section 18.120.020(F):

- 1) *That any off-street parking area, screening strips, and other facilities and improvements necessary to secure the purpose and intent of this title and the general plan of the City area a part of the proposed development, in that:*
  - The proposal is consistent with SCCC 18.38.060D as the garage still maintains the code compliant two parking spaces of at least 8.5 feet wide by 18 feet deep and
  - The proposed parking spaces are not located in the required front yard or side yard landscape areas as they are in the existing garage.
  - The vehicle parking is in an all-weather material surfaced area.
- 2) *That the design and location of the proposed development and its relation to neighboring developments and traffic is such that it will not impair the desirability of investment or occupation in the neighborhood, will not unreasonably interfere with the use and enjoyment of neighboring developments, and will not create traffic congestion or hazard, in that:*
  - The proposed construction would not create any traffic congestion or hazards.
  - The public streets are adequate in size to accommodate a single-family residence of this size.
  - The proposed design matches nearby residence in scale and would not impair the desirability of the neighborhood.
- 3) *That the design and location of the proposed development is such that it is in keeping with the character of the neighborhood and is such as not to be detrimental to the harmonious development contemplated by this title and the general plan of the City, in that:*
  - Building height and bulk is appropriate relative to the neighborhood.
  - Roof materials, building materials, and finishes work in conjunction with one another and consistent with the architectural style of the building.
  - Architectural features of the proposed design are true to the architectural form and appropriate for the neighborhood.

- A tree will remain in the front yard to provide shade, soften the building, improve the streetscape, and comply with the City's Climate Action Plan.
- 4) *That the granting of such approval will not, under the circumstances of the particular case, materially affect adversely the health, comfort or general welfare of persons residing or working in the neighborhood of said development, and will not be materially detrimental to the public welfare or injuries to property or improvements in said neighborhood, in that:*
- The project is subject to the California Building Code and City Code requirements. Which serve to regulate new construction to protect public health, safety, and general welfare.
- 5) *That the proposed development, as set forth in the plans and drawings, are consistent with the set of more detailed policies and criteria for architectural review as approved and updated from time to time by the City Council, which set shall be maintained in the planning division office. The policies and criteria so approved shall be fully effective and operative to the same extent as if written into and made a part of this title, in that:*
- With adherence to condition P3 of the Conditions of Approval, the proposed construction is consistent with the City's Single-Family & Duplex Residential Design Guidelines (2014):
    - The project would create a house design that is compatible in scale and character with the housing types that are typical in the neighborhood as the proposed design will have similar massing to the adjacent properties.
  - The proposed construction complies with the R1-6L Zoning Districts development standards.
  - The proposed construction complies with the intent of the Santa Clara General Plan and all its policies.

### CONDITIONS OF APPROVAL

Conditions of approval are proposed for the project and are contained in Attachment 3.

### ENVIRONMENTAL REVIEW

The action being considered is categorically exempt from the California Environmental Quality Act (CEQA) pursuant to CEQA Guidelines Section 15332 (Class 32 - Infill Development Projects), in that the project site is less than five acres, served by utilities, and complies with the General Plan.

### PUBLIC CONTACT

Public contact was made by posting the Development Review Hearing agenda on the City's official-notice bulletin board outside City Hall Council Chambers. A complete agenda packet is available on the City's website and in the City Clerk's Office. A hard copy of any agenda report may be requested by contacting the City Clerk's Office at (408) 615-2220, email [clerk@santaclaraca.gov](mailto:clerk@santaclaraca.gov) or at the public information desk at any City of Santa Clara public library.

A public hearing notice was mailed to property owners within a 300-foot radius of the project site on November 6, 2025, to 67 owners/tenants. As of the writing of this report, planning staff has not received public comments for this application.

### RECOMMENDATION

**Determine** the project to be exempt from the California Environmental Quality Act (CEQA) formal pursuant to CEQA Guidelines Section 15332 (Class 32 -- Infill Development Projects), and **Approve**


the Architectural Review for the construction of a 621 square foot first floor addition and a 397 square foot second floor addition to an existing two-story 2,081 square foot single-family residence with a 500 square foot attached garage on a 7,351 square foot lot at 2892 Mesquite Drive, subject to findings and conditions of approval.

Prepared by: Alex Tellez, Assistant Planner, Community Development Department  
Reviewed by: Nimisha Agrawal, Senior Planner, Community Development Department  
Approved by: Sheldon S. Ah Sing, Development Review Officer, Community Development Department

### **ATTACHMENTS**

1. Vicinity Map
2. Project Data and Compliance Table
3. Conditions of Approval
4. Development Plans

# Vicinity Map (Zoning) - 2892 Mesquite Drive

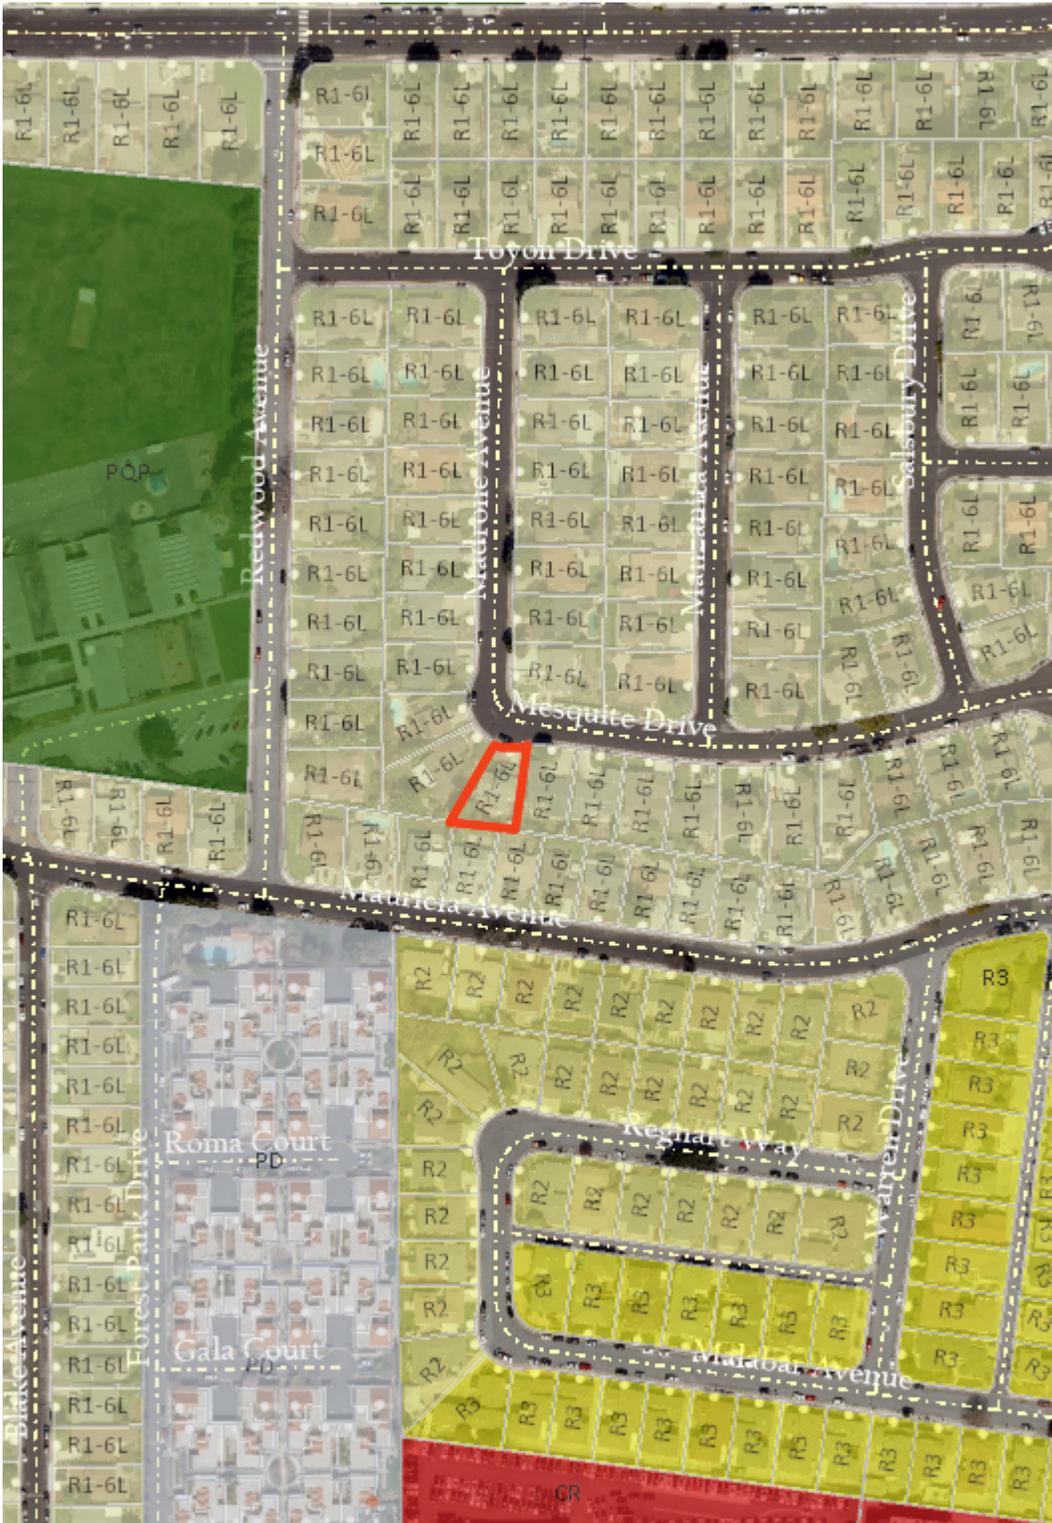

**Zoning**

Land Parcels

 CR - Commercial Regional

**Base Layers**

Site Addresses

 Place

 Single

 Utility

Streets

Land Parcels

 Land Parcels

 Common Areas

**Imagery2024**

 Red: Band\_1

 Green: Band\_2

 Blue: Band\_3

**Notes:**

PLN25-00295

10/29/2025 3:28:33 PM



This map is a user generated static output from an Internet mapping site and is for reference only. Data layers that appear on this map may or may not be accurate, current, or otherwise reliable.

**Attachment 2: Project Data/Compliance**

**Project Address: 2892 Mesquite Drive  
Zoning: R1-6L**

**Project Number: PLN25-00295**

Standard	Existing	Proposed	Requirement	Complies? (Y/N)
<b>Lot Area (SF) (min):</b>	7,351	7,351	6,000	Y
<b>Lot Area per Dwelling Unit (SF):</b>	7,351	7,351	--	--
<b>Building Square Footage (SF)</b>				
<b>1<sup>st</sup> Floor:</b>	1,363	1,984	--	--
<b>2<sup>nd</sup> Floor:</b>	718	1,116	--	--
<b>Garage:</b>	500	500	600 SF max	Y
<b>Porch/Patio:</b>	76	64	--	--
<b>Total:</b>	2,657	3,663	--	--
<b>Floor Area Ratio:</b>	0.36	0.49	--	--
<b>% of 2<sup>nd</sup> floor to 1<sup>st</sup> floor:</b>	0.52	0.56	66% max	Y
<b>Building Coverage (%)</b>				
<b>Building Coverage (All):</b>	0.26	0.34	40% max	Y
<b>Rear Yard Accessory Building Coverage:</b>	--	--	40% max	--
<b>Main Building Setbacks (FT)</b>				
<b>Front (1<sup>st</sup> floor):</b>	17	20	20	Y
<b>(2<sup>nd</sup> floor):</b>	34	37	25	Y
<b>Left Side (1<sup>st</sup> floor):</b>	5'-0	5'	5	Y
<b>(2<sup>nd</sup> floor):</b>	9'-3	9'-3	10	Y
<b>Right Side (1<sup>st</sup> floor):</b>	6' – 11"	7	5	Y
<b>(2<sup>nd</sup> floor):</b>	32' – 11"	8' – 3"	10	Y
<b>Side, Corner:</b>	--	--	--	--
<b>Rear (1<sup>st</sup> floor):</b>	22' – 9"	22' – 9"	20	Y
<b>(2<sup>nd</sup> floor):</b>	39' – 9"	39' – 9"	20	Y
<b>Height (FT)</b>				
<b>Main building:</b>	22' – 9"	25' – 3"	25	N (Conditioning Height to 25')
<b>Accessory building:</b>	--	--	--	--
<b># of Bedrooms/Bathrooms:</b>	4/2	5/5	--	--
<b>Parking:</b>				
<b>Is the site Gov. Code 65863.2 (AB 2097) eligible?</b>				N
<b>Off-street</b>	2	2	2	Y
<b>Common Living Area (SFR)</b>	35%	47%	Min 25%	Y
<b>Open Landscaped Area (Front):</b>	2,900	3,100	--	--

## Conditions of Architectural Review Approval

### PLN25-00295/ 2892 Mesquite Drive

**Architectural Review** for the construction of a 621 square foot first floor addition and a 397 square foot second floor addition in an existing two-story 2,081 square foot single-family residence with a 500 square foot attached garage in a 7,351 square foot lot.

#### GENERAL

- G1. **Permit Expiration.** This Permit shall automatically be revoked and terminated if not used within **two years** of original grant or within the period of any authorized extensions thereof. The date of granting of this Permit is the date this Permit is approved by the Development Review Officer and all appeal periods have been exhausted. The expiration date is November 26, 2027
- G2. **Conformance with Plans.** Prior to the issuance of Building Permit, the development of the site and all associate improvements shall substantially conform to the approved plans on file with the Community Development Department, Planning Division. No change to the plans will be made without prior review by the Planning Division through approval of a Minor Amendment or through an Architectural Review, at the discretion of the Director of Community Development or designee. Each change shall be identified and justified in writing.
- G3. **Conditions on Plans.** All conditions of approval for this Permit shall be reprinted and included within the first three sheets of the building permit plan sets submitted for review and approval. At all times these conditions of approval shall be on all grading and construction plans kept on the project site.
- G4. **Code Compliance.** Comply with all requirements of Building and associated codes (the California Building Code, California Electric Code, California Mechanical Code, California Plumbing Code, California Green Building Code, the California Energy Code, etc.) current at the time of application for Building Permit, that includes grading and site utility permits.

#### DESIGN / PERFORMANCE – PRIOR TO BUILDING PERMIT ISSUANCE

- P1. **Tree Protection (On-site).** Trees on-site shall be protected from construction activity through ISA tree care best practices.
- P2. **Roof Height.** The roof shall be 25 feet as required by the R1-6L zoning code.
- P3. **Entry Feature's Height.** The Entry Feature's height shall be less than or at the same height as the rest of the first floor's eaves.

#### DURING CONSTRUCTION

- P4. **Construction Hours.** Construction activity shall be limited to the hours of 7:00 a.m. to 6:00 p.m. weekdays and 9:00 a.m. to 6:00 p.m. Saturdays for projects within 300 feet of a residential use and shall not be allowed on recognized State and Federal holidays.

- P5. **Construction Trash/Debris.** During construction activities, the owner or designee is responsible for collection and pick-up of all trash and debris on-site and adjacent public right-of-way.
- P6. **Landscape Water Conservation.** The owner or designee shall ensure that landscaping installation meets City water conservation criteria in a manner acceptable to the Director of Community Development.
- E1. **Stormwater Control Measures.** The owner or designee shall incorporate Best Management Practices (BMPs) into construction plans in accordance with the City's Urban Runoff Pollution Prevention Program for construction-related water runoff measures prior to issuance of permits.

**OPERATIONAL CONDITIONS**

- P7. **Use of Garage.** The owner or designee shall ensure that the garage always be maintained free and clear for vehicle parking use. It shall not be used only for storage.
- P8. **Landscaping Installation & Maintenance.** The owner or designee shall ensure that the landscaping installed and accepted with this project shall be maintained on the site as per the approved plans. Any alteration or modification to the landscaping shall not be permitted unless otherwise approved by the Director of Community Development.
- P9. **Landscaping.** The owner or designee shall maintain the front yard landscaping between the house and sidewalk. New landscape areas of 500 square feet or more or rehabilitated landscape areas of 2,500 square feet or more shall conform to the California Department of Water Resources Water Efficient Landscape Ordinance.
- E2. **Stormwater Control Measures.** The owner or designee shall incorporate Best Management Practices (BMPs) into construction plans in accordance with the City's Urban Runoff Pollution Prevention Program for post-construction water runoff measures prior to issuance of a building permit.

**KEY:**

G = General

P = Planning Division

E = Public Works Engineering (Stormwater)

**ACKNOWLEDGEMENT AND ACCEPTANCE OF CONDITIONS OF APPROVAL**

*Permittee/Property Owner*

The undersigned agrees to each condition of approval and acknowledges and hereby agrees to use the project property on the terms and conditions set forth in this permit.

Signature: \_\_\_\_\_

Printed Name: \_\_\_\_\_

Relationship to Property: \_\_\_\_\_

Date: \_\_\_\_\_

Pursuant to Santa Clara City Code 18.128.100, the applicant shall return this document to the Department, properly signed and dated, within 30-days following the date of the Acknowledgement.

# GREEN BUILDING NOTES

**WATER EFFICIENCY AND CONSERVATION**  
 PLUMBING FIXTURES (WATER CLOSETS AND URINALS) SHALL COMPLY WITH THE FOLLOWING:  
 1. THE EFFECTIVE FLUSH VOLUME OF ALL WATER CLOSETS SHALL NOT EXCEED 1.28 GAL./FLUSH (CGC 403.1.1)  
 2. THE EFFECTIVE FLUSH VOLUME OF URINALS SHALL NOT EXCEED 0.5 GAL./FLUSH (CGC 403.1.2)  
 3. FITTINGS (FAUCETS AND SHOWERHEADS) HAVE ALL REQUIRED STANDARDS LISTED ON PLANS AND ARE IN ACCORDANCE TO CGC 4.303.1.3 AND CGC 403.1.4  
 4. AUTOMATIC IRRIGATION SYSTEM CONTROLLER FOR LANDSCAPING PROVIDED BY THE BUILDER AND INSTALLED AT THE TIME OF FINAL INSPECTION SHALL COMPLY WITH CGC 4.304

**ENHANCED DURABILITY AND SERVICE MAINTENANCE**  
 5. ANNUAL SPACES AROUND PIPES, ELECTRIC CABLES, CONDUITS OR OTHER OPENINGS IN SOLE/BOTTOM PLATES AT EXTERIOR WALLS SHALL BE RODENT PROOFED BY CLOSING SUCH OPENINGS WITH CEMENT MORTAR, CONCRETE MASONRY, OR SIMILAR METHOD ACCEPTABLE TO THE ENFORCING AGENCY PER CGC 4.406.1

**BUILDING MAINTENANCE AND OPERATION**  
 6. AN OPERATION AND MAINTENANCE MANUAL WILL BE PROVIDED TO THE BUILDING OCCUPANT OR OWNER PER CGC 4.410.1  
**ENVIRONMENTAL QUALITY**  
 7. ANY GAS FIREPLACES SHALL BE A DIRECT-VENT SEALED-COMBUSTIBLE TYPE.  
 8. ANY WOOD STOVE OR PELLET STOVE SHALL COMPLY WITH US EPA PHASE II EMISSION LIMITS PER CGC 4.503.1

**POLLUTANT CONTROL**  
 9. AT THE TIME OF ROUGH INSTALLATION, DURING STORAGE ON THE CONSTRUCTION SITE AND UNTIL FINAL STARTUP OF THE HEATING, COOLING AND VENTILATING EQUIPMENT, ALL DUCT AND OTHER RELATED AIR DISTRIBUTION COMPONENTS OPENINGS SHALL BE COVERED WITH TAPE, PLASTIC, SHEET METALS, OR OTHER METHODS ACCEPTABLE TO THE ENFORCING AGENCY TO REDUCE THE AMOUNT OF WATER, DUST OR DEBRIS, WHICH MAY ENTER THE SYSTEM PER CGC 4.504.1  
 10. ADHESIVE, SEALANTS AND CAULKS SHALL MEET THE VOC OR OTHER TOXIC COMPOUND LIMITS PER CGC 4.504.2.1.  
 11. PAINTS AND COATINGS SHALL COMPLY WITH VOC LIMITS PER CGC 4.504.2.2.  
 12. AEROSOL PAINTS AND COATINGS SHALL MEET THE PRODUCT-WEIGHTED MIR LIMITS FOR ROC AND OTHER REQUIREMENTS PER CGC 4.504.2.3.

13. DOCUMENTATION WILL BE PROVIDED, AT THE REQUEST OF THE BUILDING DIVISION, TO VERIFY COMPLIANCE WITH VOC FINISH MATERIALS PER CGC 4.504.2.4.  
 14. CARPET SYSTEM INSTALLED IN THE BUILDING INTERIOR SHALL MEET THE TESTING AND PRODUCT REQUIREMENT PER CGC 4.504.3.  
 15. WHERE RESILIENT FLOORING IS INSTALLED, AT LEAST 80% OF THE FLOOR AREA RECEIVING RESILIENT FLOORING WILL COMPLY WITH THE REQUIREMENTS PER CGC 4.504.4.  
 16. HARDWOOD PLYWOOD, PARTICLEBOARD AND MEDIUM DENSITY FIBERBOARD COMPOSITE WOOD PRODUCTS USED ON THE INTERIOR AND EXTERIOR OF THE BUILDING SHALL COMPLY WITH THE LOW FORMALDEHYDE EMISSION STANDARDS PER CGC 4.504.5.

**INTERIOR MOISTURE CONTROL**  
 17. A CAPILLARY BREAK SHALL BE INSTALLED IF A SLAB ON GRADE FOUNDATION SYSTEM IS USED. THE USE OF A 4" THICK BASE OF 1/2" OR LARGER CLEAN AGGREGATE UNDER A 1/8" ML VAPOR RETARDER WITH JOINT LAPPED NOT LESS THAN 6" WILL BE PROVIDED PER CGC 4.505.2 AND CRC R506.2.3. BUILDING MATERIALS WITH VISIBLE SIGNS OF WATER DAMAGE SHALL NOT BE INSTALLED. WALL AND FLOOR FRAMING SHALL NOT BE ENCLOSED WHEN THE FRAMING MEMBERS EXCEED 19% MOISTURE CONTENT. MOISTURE CONTENT SHALL BE CHECKED PRIOR TO FINISH MATERIAL BEING APPLIED PER CGC 4.505.3.

**INDOOR AIR QUALITY AND EXHAUST**  
 18. EXHAUST FANS, WHICH ARE ENERGY STAR COMPLIANT AND BE DUCTED TO TERMINATE OUTSIDE THE BUILDING SHALL BE PROVIDED IN EVERY BATHROOM PER CGC 4.506.1. ENVIRONMENTAL CONTROL HEATING AND AIR-CONDITIONING SYSTEM SHALL BE SIZED, DESIGNED AND HAVE THEIR EQUIPMENT SELECTED USING THE FOLLOWING METHODS: HEAT LOSS/HEAT GAIN VALUES IN ACCORDANCE WITH ANSI/ACCA 2 MANUAL, 1-2004 OR EQUIVALENT; DUCT SYSTEMS ARE SIZED ACCORDING TO ANSI/ACCA 1, MANUAL D-2009 OR EQUIVALENT; SELECT HEATING AND COOLING EQUIPMENT IN ACCORDANCE WITH ANSI/ACCA 3, MANUAL S-2004 OR EQUIVALENT.

**INSTALLER AND SPECIAL INSPECTOR QUALIFICATION**  
 19. HVAC SYSTEM INSTALLERS SHALL BE TRAINED AND CERTIFIED IN THE PROPER INSTALLATION OF HVAC SYSTEMS AND EQUIPMENT BY A RECOGNIZE TRAINING OR CERTIFICATION PROGRAM PER CGC 702.1.

**VERIFICATION**  
 20. UPON REQUEST, VERIFICATION OF COMPLIANCE WITH THIS CODE MAY INCLUDE CONSTRUCTION DOCUMENTS, PLAN SPECIFICATIONS, BUILDER OR INSTALLER CERTIFICATION, INSPECTION REPORTS, OR OTHER METHODS ACCEPTABLE TO THE BUILDING DEPARTMENT WHICH WILL SHOW SUBSTANTIAL CONFORMANCE.

## SCOPE OF WORK

- ON THE FIRST FLOOR:
  - ADD ONE NEW BEDROOM AND ONE NEW BATHROOM IN THE FRONT YARD.
  - ADD NEW OFFICE IN THE REAR YARD.
  - RELOCATE KITCHEN.
  - REMOVE GARAGE PARTITION WALL.
- ON THE SECOND FLOOR:
  - RECONFIGURE LAYOUT.
  - ADD NEW BATHROOM.
- GENERAL:
  - RELOCATE FURNACE.
  - UPGRADE EXISTING ELECTRICAL METER FROM 100AMP TO 200AMP.
- FINALIZING 4/25/19 INSPECTION CORRECTION NOTICE.

## SYMBOLS

	COLUMN GRID LINE NO.		EXISTING DOOR
	SECTION NO.		DOOR NO.
	SECTION SHEET NO.		DOOR SCHEDULE
	ELEVATION NO.		INTERIOR ELEVATIONS
	ELEVATION SHEET NO.		INDICATOR
	DETAIL NO.		ROOM NAME
	DETAIL SHEET NO.		FLOOR FINISH

# BLDG DATA

LOT SIZE: 7,351 S.F.  
 CURRENT ZONING: R1-BL  
 PROPOSED USE: 289  
 EXISTING PROPERTY BUILT: 1952  
 (E) BUILDING FLOOR AREA:  
 (E) 1st FLOOR: 1,363 S.F.  
 (E) 2ND FLOOR: 718 S.F.  
 (E) GARAGE: 500 S.F.  
 (E) PORCH: 76 S.F.  
 (E) TOTAL HABITABLE AREA: 2,081 S.F.  
 (E) TOTAL BUILDING AREA: 2,581 S.F.  
 PROPOSED BUILDING FLOOR AREA:  
 (E) 1st FLOOR: 1,363 S.F.  
 (N) 1ST NEW ADDITION: 621 S.F.  
 (E) 2ND FLOOR: 718 S.F.  
 (N) 2ND NEW ADDITION: 307 S.F.  
 (N) PORCH: 64 S.F.  
 (E) 1ST PORCH: 607 S.F.  
 (N) TOTAL HABITABLE AREA: 3,099 S.F.  
 (N) TOTAL BUILDING AREA: 3,599 S.F.  
 (N) LOT COVERAGE = 2,581 / 7,351 = 0.351 → 34.83% > 40%  
 (N) 2ND LOT = 1,152 / 1,304 = 0.884 → 88.09%  
 (N) OPEN LANDSCAP AREA: 3,109 S.F.  
 OCCUPANCY: R37U  
 CONSTRUCTION TYPE: VB  
 STORY (CS): 2  
 AUTO. FIRE SPRINKLER: NO  
 DESIGN COMPLY WITH:  
 CITY OF SANTA CLARA MUNICIPAL CODE  
 2022 CALIFORNIA BUILDING CODE  
 2022 CALIFORNIA RESIDENTIAL CODE  
 2022 CALIFORNIA ELECTRICAL CODE  
 2022 CALIFORNIA MECHANICAL CODE  
 2022 CALIFORNIA PLUMBING CODE  
 2022 CALIFORNIA FIRE CODE  
 2022 CALIFORNIA GREEN BUILDING STANDARDS CODE  
 2022 CALIFORNIA ENERGY CODE

## VICINITY MAP



## SHEET INDEX

ARCHITECTURAL	
A1.1	TITLE SHEET & PROPOSED SITE PLAN
A1.2	EXISTING SITE PLAN & AREA CALC.
A2.0	DEMOLISH NOTE EXISTING 1ST FLOOR PLAN
A2.1	NOTE EXISTING 2ND FLOOR PLAN
A2.2	PROPOSED 1ST FLOOR PLAN
A2.3	PROPOSED 2ND FLOOR PLAN
A2.4	EXISTING & PROPOSED ROOF PLAN
A3.1	EXISTING ELEVATIONS
A3.2	PROPOSED ELEVATIONS
A3.3	PROPOSED ELEVATIONS
A3.4	PROPOSED SECTION
CBCL	GREEN BUILDING CHECK LIST

# RESIDENCE ADDITION

2892 Mesquite Dr, Santa Clara, CA 95051

APN: 296-31-032

1ST FLOOR  
 NEW ADDITION:  
 220 SQ FT

2ND FLOOR  
 NEW ADDITION:  
 379 SQ FT

1ST FLOOR  
 NEW ADDITION:  
 401 SQ FT


NEW PORCH:  
 64 SQ FT

## SITE NOTE

- LOT DRAINAGE WILL BE 5% AWAY FROM THE BUILDING AND 2% TOWARDS THE PUBLIC RIGHT-OF-WAY. LOT DRAINAGE SHALL NOT CROSS A PROPERTY LINE. CRC R401.3, CPC 1101.2
- ALL WET AND DRY UTILITIES TO SERVICE PROPOSED ADDITION ARE TO COME FROM EXISTING ON-SITE UTILITIES. CONNECTION WITHIN THE CITY ROW AND EASEMENTS IS NOT PERMITTED.
- CONSTRUCTION RELATED MATERIALS, EQUIPMENT, ETC. MUST BE STORED ON SITE UNLESS PERMITTED IN ADVANCE BY THE PUBLIC WORKS DEPARTMENT. THIS IS TO AVOID CAUSING SAFETY AND/OR OPERATIONAL ISSUES FOR THE MOVEMENTS OF PEDESTRIANS, CYCLISTS AND VEHICULAR TRAFFIC.
- PRIOR TO ANY WORK IN THE PUBLIC RIGHT-OF-WAY, OBTAIN AN ENCROACHMENT PERMIT ALONG WITH INSURANCE REQUIREMENTS FOR ALL PUBLIC IMPROVEMENTS INCLUDING A TRAFFIC CONTROL PLAN PER THE LATEST CALIFORNIA MANUAL ON UNIFORM TRAFFIC CONTROL DEVICES (MUTCD) STANDARDS TO BE REVIEWED AND APPROVED BY THE DEPARTMENT OF PUBLIC WORKS.
- INCREMENTAL WATER AND SEWER CONNECTION FEES ARE NOT TO BE COLLECTED AS COUNTY RECORDS INDICATE EXISTING DWELLING UNIT IS AT STANDARD OCCUPANCY WITH 4 BEDROOMS.
- IF THE MAIN WATER SERVICE LINE WILL BE PLASTIC, INSTALL BLUE INSULATED 18 AWG COPPER TRACER WIRE SUITABLE FOR DIRECT BURIAL ADJACENT TO THE PIPE AND SHALL TERMINATE ABOVE GROUND AT BOTH ENDS.
- NO TREES OF 38" OR GREATER IN CIRCUMFERENCE ARE TO BE REMOVED.

## LEGEND

---	PROPERTY LINE
---	ROOF LINE
---	SETBACK LINE
---	EASEMENT
---	2ND FLOOR LINE
	(N) 1ST FLOOR ADDITION
	(N) 2ND FLOOR ADDITION
	(N) PORCH

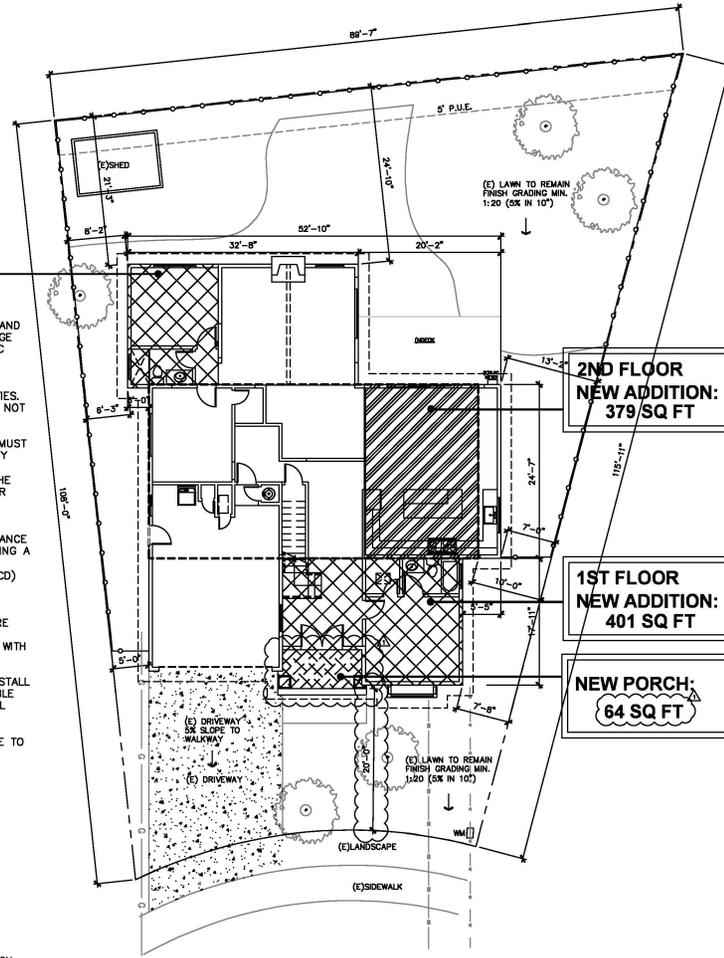

PROPOSED SITE PLAN  
 SCALE: 1/8" = 1'-0"



REVISIONS	DATE
SUBMITAL	06/20/25
RE-SUBMITAL	09/26/25

**RESIDENCE ADDITION**  
 2892 Mesquite Dr, Santa Clara, CA 95051  
 PROJECT:

SHEET TITLE:  
**TITLE SHEET  
 PROPOSED  
 SITE PLAN**

DRAWN BY: *Fiona Wong*  
 REVIEWED BY: -  
 DATE: -  
 SCALE: -  
 SHEET NO.:  
**A1.1**  
 OF SHEETS



RENDERING 1




RENDERING 2

**FLOOR AREA CALCULATION DIAGRAM:**

LOT SIZE : 7,351 S.F.

	(E) 1ST EXISTING FLOOR	1,363 S.F.
	(E) 2ND EXISTING FLOOR	718 S.F.
	(N) 1ST ADDITION FLOOR	621 S.F.
	(N) 2ND ADDITION FLOOR	397 S.F.
<hr/>		
	(N) FAR	3,099 S.F.
	(E) 2 CAR GARAGE	500 S.F.
	(N) FRONT PORCH	64 S.F.
<hr/>		
	(N) LOT COVERAGE.	2,548 S.F.

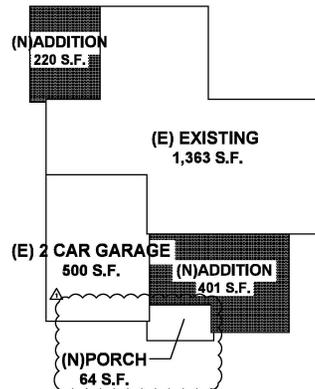


**FLOOR AREA CALC. DIAGRAM**

SCALE : 3/32" = 1'-0"

**LEGEND**

- PROPERTY LINE
- ROOF LINE
- SETBACK LINE
- P.U.E.
- CONCRETE
- DEMOLITION

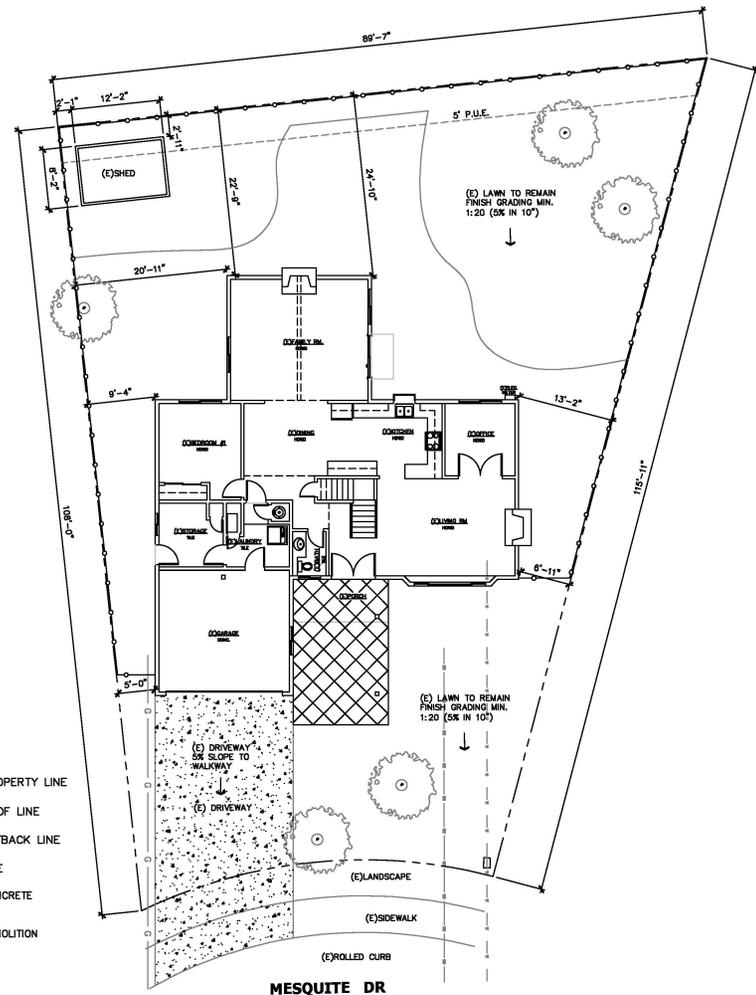

**EXISTING SITE PLAN**

SCALE : 1/8" = 1'-0"



REVISIONS	DATE
SUBMITTAL	06/20/25
RE-SUBMITTAL	09/26/25

**PROJECT:**

**RESIDENCE ADDITION**

2892 Mesquite Dr, Santa Clara, CA 95051


**SHEET TITLE:**

**EXISTING SITE PLAN & AREA CALC**

<b>DRAWN BY:</b> <i>Fima Wong</i>
<b>REVIEWED BY:</b> -
<b>DATE:</b> -
<b>SCALE:</b> -
<b>SHEET NO.:</b>
<b>A1.2</b>
OF SHEETS

## DEMOLITION NOTES

1. THE GENERAL CONTRACTOR SHALL FURNISH ALL LABOR AND MATERIALS AS REQUIRED TO COMPLETE DEMOLITION AND REPAIR OF ALL ITEMS INDICATED ON TSGG DRAWINGS OR AS OTHERWISE DIRECTED BY THE OWNER.
2. THE CONTRACTOR IS TO VIEW AND VERIFY ACTUAL CONDITIONS AT ALL LOCATIONS WHERE ALTERATIONS TO THE EXISTING BUILDING OCCUR. WHEN WALLS, PARTITIONS, AND OTHER WORK EXISTS WHERE NEW WORK IS INDICATED, ALL SUCH EXISTING WORK SHALL BE REMOVED. VERIFY ALL SUCH CONDITIONS AT THE SITE.
3. THE CONTRACTOR SHALL REPORT TO ARCHITECT ANY AND ALL CONDITIONS WHICH MAY INTERFERE WITH OR OTHERWISE AFFECT OR PREVENT THE PROPER EXECUTION AND COMPLETION OF THE WORK OF THIS CONTRACT.
4. THE GENERAL CONTRACTOR SHALL EXECUTE ALL WORK WITHIN THE REGULATIONS OF THE BUILDING FOR DEMOLITION AND REMOVAL OF DEBRIS, INCLUDING OVERTIME WORK REQUIRED.
5. THE GENERAL CONTRACTOR SHALL AT ALL TIMES PROTECT THE PROPERTY OF THE BUILDING LANDLORD INCLUDING, BUT NOT LIMITED TO FLOOR COVERING, CEILING GRID AND TILE, LIGHT FIXTURES, DOORS, WINDOWS, FRAMES, HARDWARE, CABINETRY, PLUMBING FIXTURES, ELECTRICAL AND AIR CONDITIONING EQUIPMENT, PERIPHERAL ENCLOSURES, ETC.
6. THE GENERAL CONTRACTOR SHALL ERECT ALL NECESSARY PLASTIC DROP CLOTH BARRIERS TO PROTECT ADJACENT BUILDING PROPERTY WHILE DEMOLITION AND CONSTRUCTION ARE IN PROGRESS.
7. THE GENERAL CONTRACTOR SHALL SURVEY ALL EXISTING FINISHED SURFACES TO INCLUDE CORNER BEADS, STOPS, ETC. FOR CHIPS, CRACKS, HOLES, DAMAGED SURFACES, AND ANY OTHER DEFECTS CAUSING AN APPEARANCE DIFFERENT FROM A NEW FINISHED INSTALLATION. THESE DEFECTIVE SURFACES SHALL BE REPAIRED OR, IF BEYOND REPAIR, THE GENERAL CONTRACTOR SHALL REMOVE ALL EXISTING AND INSTALL NEW SURFACES TO THE SATISFACTION OF TSGG AND THE OWNER.
8. THE GENERAL CONTRACTOR SHALL INSPECT ALL EXISTING SURFACES AND WHERE AS A RESULT OF DEMOLITION, FINISHED SURFACES DO NOT ALIGN, THE EXISTING SURFACE SHALL BE CUT AND PATCHED.
9. ALL DAMAGED EXISTING AREAS TO REMAIN AND EXISTING AREAS AFFECTED BY DEMOLITION OR NEW CONSTRUCTION WORK SHOWN ON DRAWINGS SHALL BE PATCHED AS REQUIRED TO MATCH IMMEDIATE EXISTING ADJACENT AREAS IN MATERIAL, FIRE-RATING, FINISH, AND COLOR, UNLESS OTHERWISE NOTED.
10. ALL WORK DEMOLISHED SHALL BE REMOVED FROM THE PREMISES EXCEPT ITEMS TO BE REUSED OR RETURNED TO THE OWNER OR AS OTHERWISE DIRECTED.
11. IN ALL AREAS WHERE DEMOLITION (REMOVAL OF TILE, PARTITIONS, ETC. CAUSES AN UNEVENNESS IN THE SLAB, THE CONTRACTOR SHALL PATCH TO LEVEL THE SLAB TO RECEIVE NEW FINISH FLOORING.
12. ALL EXPOSED LIGHT FIXTURES, WIRING, SWITCHES, CONDUIT, AND METAL MOLDING NOT BEING REUSED SHALL BE REMOVED AND EITHER STORED OR DISPOSED OF BY THE GENERAL CONTRACTOR AS INSTRUCTED BY THE OWNER.
13. THE GENERAL CONTRACTOR SHALL FURNISH A SYSTEM OF TEMPORARY LIGHTS THROUGHOUT THE SPACE UNDER DEMOLITION AS REQUIRED.
14. THE GENERAL CONTRACTOR SHALL CAP OFF BEHIND FINISHED SURFACES ALL PROJECT PLUMBING, FLOOR ELECTRICAL, TELEPHONE OUTLETS, AND ALL OTHER PROJECTING ITEMS THAT ARE BEING ABANDONED.
15. THE GENERAL CONTRACTOR SHALL REMOVE ALL WALL CONDUITS LEFT AFTER WALL DEMOLITION INCLUDING SWITCH BOXES, PLATES, BRIDGES, OR ANY OTHER TELEPHONE OR ELECTRICAL WIRING OR EQUIPMENT. VERIFY WITH TENANT REUSE OF EXISTING CABLING PRIOR TO REMOVAL.
16. ALL "EXISTING TO REMAIN", "EXISTING", "RELOCATED", OR "NEW" ITEMS INSTALLED BY THE GENERAL CONTRACTOR, IN ADDITION TO BEING AMPPLY PROTECTED THROUGHOUT THE PERIOD OF CONSTRUCTION, SHALL BE THOROUGHLY CLEANED TO THE SATISFACTION OF TSGG PRIOR TO BEING TURNED OVER TO THE OWNER.
17. REFER TO ENGINEERING DRAWINGS FOR REMOVAL AND/OR RELOCATION IF REQUIRED OF HAVOC DUCTS, DIFFUSERS, SPRINKLER HEADS, EXOT LIGHTS, ETC.
18. SOME DOORS AND FRAMES TO BE REMOVED SHALL BE RETURNED TO OWNER. HANDLE CAREFULLY AND STORE ON SITE.

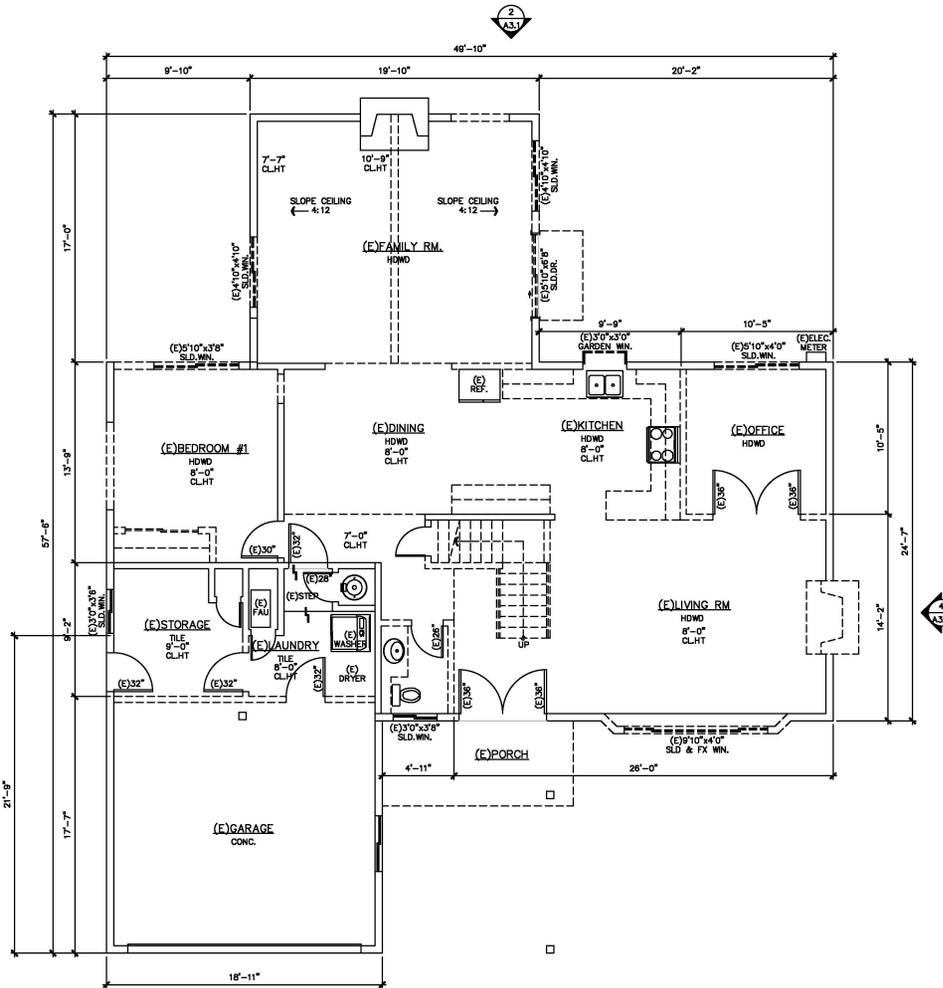

### LEGEND

- ==== EXISTING WALLS TO REMAIN REPAIR AS REQUIRED
- EXISTING WINDOWS WALLS AND DOORS TO BE REMOVED

### EXISTING 1ST FLOOR PLAN

SCALE: 1/4" = 1'-0"



REVISIONS	DATE
SUBMITTAL	06/20/25
RE-SUBMITTAL	09/26/25

**RESIDENCE ADDITION**  
2892 Mesquite Dr, Santa Clara, CA 95051

PROJECT: **RESIDENCE ADDITION**  
SHEET TITLE: **DEMOLISH NOTES**

DRAWN BY: *Fima Wong*  
REVIEWED BY: -  
DATE: -  
SCALE: -  
SHEET NO.: **A2.0**  
OF SHEETS

## NOTES TO WINDOW AND DOOR

- EMERGENCY EGRESS WINDOWS  
2022 CRC SECTION R310-EMERGENCY ESCAPE AND RESCUE OPENINGS  
A. PROVIDE AT LEAST ONE WINDOW IN EACH SLEEPING ROOM, BASEMENT, AND HABITABLE ATTIC.  
B. R310.2.1 MINIMUM OPENING AREA. ALL EMERGENCY ESCAPE AND RESCUE OPENINGS SHALL HAVE A MINIMUM NET CLEAR OPENING OF 5.7 SQUARE FEET.  
C. WHERE EMERGENCY ESCAPE AND RESCUE OPENINGS HAVE A MINIMUM NET CLEAR OPENING OF 5 SQUARE FEET.  
D. WHERE EMERGENCY ESCAPE AND RESCUE OPENINGS ARE PROVIDED THEY SHALL HAVE A SILL HEIGHT OF NOT MORE THAN 44 INCHES. MINIMUM OPENING HEIGHT, THE MINIMUM NET CLEAR OPENING HEIGHT SHALL BE 24 INCHES. MINIMUM OPENING WIDTH SHALL BE 20 INCHES.  
E. R310.1.1 OPERATIONAL CONSTRAINTS. EMERGENCY ESCAPE AND RESCUE OPENINGS SHALL BE MAINTAINED FREE OF ANY OBSTRUCTIONS OTHER THAN THOSE ALLOWED BY THIS SECTION AND SHALL BE OPERATIONAL FROM THE INSIDE OF THE ROOM WITHOUT THE USE OF KEYS, TOOLS OR SPECIAL KNOWLEDGE.  
F. R310.2.2 WINDOW SILL HEIGHT: WHERE A WINDOW IS PROVIDED AS AN EMERGENCY ESCAPE AND RESCUE OPENING, IT SHALL HAVE A BOTTOM OF THE CLEAR OPENING NOT GREATER THAN 44 INCHES MEASURED FROM THE FLOOR. WHERE THE SILL HEIGHT IS BELOW GRADE, IT SHALL BE PROVIDED WITH A WINDOW WELL IN ACCORDANCE WITH SEC. R310.2.3.
- FALL PROTECTION (CBC 1015.1 AND CRC R312.2)  
WHERE THE WINDOW OPENING (MEASURED AT THE WINDOW SILL) IS LOCATED MORE THAN 72 INCHES ABOVE THE EXTERIOR FINISHED GRADE, ANY WINDOW LOCATED LESS THAN 24 INCHES ABOVE THE FINISHED FLOOR OR THE INTERIOR SHALL BE EITHER FIXED GLAZING OR HAVE A PROTECTIVE GUARDRAIL WITH OPENINGS LESS THAN 4 INCHES.
- 2022 CRC SECTION R308 - SAFETY OR TEMPERED GLASS WILL BE REQUIRED FOR THE FOLLOWING LOCATIONS AND OTHER HAZARDOUS LOCATIONS REQUIRED BY CRC SECTION R308.1:  
A. GLAZING WITHIN 24" OF A DOOR AND WHERE BOTTOM EDGE IS LESS THAN 60" ABOVE FLOOR OR WALKING SURFACE OR WHERE THE GLAZING IS NOT PERPENDICULAR TO THE PLANE OF THE DOOR IN A CLOSED POSITION AND WITHIN 24 INCHES OF THE HINGE SIDE.  
B. WHERE THE GLAZING IS LESS THAN 36" ABOVE THE PLANE OF THE ADJACENT WALKING SURFACE AND WITHIN 36" HORIZONTALLY FROM THE WALKING SURFACE OF STAIRWAYS, LANDINGS AND RAMPS AND WITHIN A 60-INCH ARC LESS THAN 180 DEGREES FROM THE BOTTOM TREAD NOSING.
- TEMPERED GLAZING LABEL (2022 CRC SEC. 2406)  
WHERE REQUIRED, TEMPERED GLAZING (EXCEPT TEMPERED SPARKING GLASS) SHALL BE PERMANENTLY IDENTIFIED BY A MANUFACTURER MARKING THAT IS PERMANENTLY APPLIED AND CANNOT BE REMOVED WITHOUT BEING DESTROYED (E.G. SAND BLASTED, ADD ETCHED, CERAMIC FIRED, LASER ETCHED, OR EMBOSSED). STICKERS ATTACHED TO THE WINDOW ARE NOT SUFFICIENT.
- 2022 CRC SECTION R303 - ALL HABITABLE ROOMS SHALL HAVE AN AGGREGATE GLAZING AREA OF NOT LESS THAN 8 PERCENT OF THE FLOOR AREA OF SUCH ROOMS. THE KITCHEN IS A HABITABLE ROOM. (2022 CRC SECTION R303.1) AMEND THE PLANS TO SPECIFY AND SHOW HOW NATURAL LIGHT SHALL BE PROVIDED FOR THE KITCHEN OR SHOW THAT THE KITCHEN MEETS ONE OF THE EXCEPTIONS OF 2022 CRC, SEC. R303.10 OR SHOW THAT NATURAL LIGHT SHALL BE PROVIDED FROM AN ADJOINING ROOM IN ACCORDANCE. (2022 CRC, SEC. R303.2).
- PLEASE SEE TITLE 24 ENERGY REPORT CF-1R FORMS FOR REAL U VALUES OF WINDOWS OR DOORS.

## NOTES TO BUILDING

- BRACED WALL PANELS SHALL BEGIN NO MORE THAN 8 FEET (2440 MM) FROM EACH END OF A BRACED WALL LINE AND SHALL BE SPACED AT A MAXIMUM OF 25 FEET (7620 MM) ON CENTER. (2022 CRC R602.12.5)
- IN R-3 AND U OCCUPANCIES, NO OPENINGS ARE ALLOWED IN WALLS 3 FEET OR CLOSER TO PROPERTY LINE. OPENINGS IN WALLS BETWEEN 3 FEET AND UP TO 5 FEET FROM PROPERTY LINE CAN BE UP TO 25% OF AREA. WALLS LESS THAN 5 FEET FROM THE PROPERTY LINE MUST BE FIRE RESISTIVE CONSTRUCTION. (2022 CRC TABLE 301.1) FIRE RESISTIVE CONSTRUCTION SHALL BE 2-HOUR EXTENDS INTO THE AREA WHERE OPENINGS ARE PROHIBITED. THIS MEANS THAT AN EAVE CAN EXTEND TO A POINT 24 INCHES FROM THE PROPERTY LINE, BUT NO CLOSER.
- PROVIDE 2X6 @ ALL PLUMBING WALL LOAD BEARING WALL AS INDICATED ON STRUCTURE DWG.
- PLATE WASHERS, A MINIMUM OF 0.229 INCH BY 3 INCHES BY 3 INCHES (6.0 MM BY 76 MM BY 76 MM) IN SIZE SHALL BE PROVIDED BETWEEN THE FOUNDATION SILL AND THE NUT EXCEPT WHERE APPROVED ANCHOR STRAPS ARE USED. (2022 CRC R602.11.1)
- SURFACE DRAINAGE SHALL BE DIVERTED TO A STORM SEWER CONVEYANCE OR OTHER APPROVED POINT OF COLLECTION THAT DOES NOT CREATE A HAZARD. LOTS SHALL BE GRADED TO DRAIN SURFACE WATER AWAY FROM FOUNDATION WALLS. THE GRADE SHALL FALL A MINIMUM OF 6 INCHES (152 MM) WITHIN THE FIRST 10 FEET (3048 MM). (2022 CRC R401.3)
- DUCT PENETRATION: DUCTS IN THE GARAGE AND DUCTS PENETRATING THE WALLS OR CEILING SEPARATING THE DWELLING FROM GARAGE SHALL BE CONSTRUCTED OF A MIN. NO. 26 GAGE SHEET STEEL OR OTHER PROVIDED MATERIALS AND SHALL NOT HAVE OPENINGS INTO THE GARAGE. (2022 CRC SEC. R302.5.2)
- MIN. ROOM AREA: HABITABLE ROOMS, EXCEPT KITCHENS, SHALL HAVE A MIN. OF 70 SQUARE FEET OF FLOOR AREA. MIN. DIMENSION: HABITABLE ROOMS SHALL BE NOT LESS THAN 7 FT IN ANY DIMENSION (2022 CRC SEC. R304)
- PROVIDE CORRECT TYPE GLAZING FOR ALL GLAZING LOCATED IN HAZARDOUS LOCATIONS AS SPECIFIED IN (2022 CRC SEC. R306.4.)
- BATHUBS AND SHOWERS IN ALL OCCUPANCIES SHALL BE FINISHED WITH A NONABSORBENT SURFACE TO A HEIGHT OF 6- FEET ABOVE THE FLOOR. (2022 CRC SEC. R307.7)
- PROVIDE AN APPROVED ATTIC ACCESS 22"x30" WITH 30 INCHES MINIMUM VERTICAL HEADROOM. (2022 CRC SEC. R807.1)
- ENCLOSED ACCESSIBLE SPACE NUDDER STAIRS SHALL HAVE WALLS, UNDER-STAR SURFACES, AND ANY SOFFITS PROTECTED ON THE ENCLOSED SIDE WITH 1/2 INCH GYPSUM BOARD. (2022 CRC SEC. R302.7)
- PROVIDE ATTIC VENTILATION AS PER (2022 CRC SEC. R806 AND THE CALIFORNIA ENERGY STANDARDS COMMISSION.)
- FACTORY BUILT FIREPLACES AND FACTORY BUILT CHIMNEYS SHALL BE LISTED AND INSTALLED IN ACCORDANCE WITH LISTING AND THE MANUFACTURER'S INSTRUCTIONS AS PER (2022 CRC SEC. R1004 AND R1005.)
- PROVIDE UNDER FLOOR CLEARANCES AS PER 2013 CRC SECTION R317, A MINIMUM OF 12" CLEARANCE TO UNDER FLOOR GRIDDERS AND 18" CLEARANCE TO FLOOR JOISTS IS REQUIRED UNLESS PRESERVATIVE-TREATED WOOD OR WOOD NATURALLY DURABLE TO DECAY IS UTILIZED. A MINIMUM 18-INCH BY 24-INCH ACCESS OPENING SHALL BE PROVIDED TO THE DRAIN. SPACE. (2022 CRC SEC. R406.4.)
- FIRE BLOCKING AND DRAFT STOPPING SHALL BE INSTALLED ACCORDING. (2022 CRC SEC. R302.1.1)
- ALL GYPSUM BOARD, STUCCO, PLASTER, AND LATH SHALL BE INSTALLED. (2022 CRC CHAPTER 7.)
- EXTERIOR WALL COVERINGS SHALL BE APPLIED. (2022 CRC SEC. R703.)
- ALL CHIMNEYS ATTACHED TO ANY APPLIANCE OR FIREPLACE THAT BURNS SOLID FUEL SHALL BE EQUIPPED WITH AN APPROVED SPARK ARRESTER. (2022 CRC R1003.9.2)
- FIXTURES SHALL BE SPACED IN ACCORDANCE WITH THE CALIFORNIA PLUMBING CODE. (2022 CRC R307.1)

- SURFACE DRAINAGE SHALL BE DIVERTED TO A STORM SEWER CONVEYANCE OR OTHER APPROVED POINT OF COLLECTION THAT DOES NOT CREATE A HAZARD. LOTS SHALL BE GRADED TO DRAIN SURFACE WATER AWAY FROM FOUNDATION WALLS. THE GRADE SHALL FALL A MINIMUM OF 6 INCHES (152 MM) WITHIN THE FIRST 10 FEET (3048 MM). (2022 CRC R401.3)

## NOTES TO BATHROOM

- TUB/SHOWER REQUIREMENTS:**  
FOLLOWING IS A LISTING OF THE GENERAL REQUIREMENTS BASED ON THE 2022 CALIFORNIA BUILDING CODE, 2022 CALIFORNIA RESIDENTIAL CODE, 2016 CALIFORNIA ELECTRIC CODE, 2022 CALIFORNIA GREEN BUILDING STANDARDS (CALGREEN), AND 2022 CALIFORNIA ENERGY EFFICIENCY STANDARDS. THIS BROCHURE IS INTENDED TO PROVIDE GENERAL INFORMATION, CONTACT THE BUILDING SAFETY DIVISION FOR ANY QUESTIONS OR ADDITIONAL INFORMATION.
- THE MIXING VALVE IN A SHOWER (INCLUDING A TUB) SHALL BE PRESSURE BALANCING SET AT A MAXIMUM 120°F. THE WATER-FILLER VALVE IN BATHUBS AND SHOWERS SHALL HAVE A TEMPERATURE LIMITING DEVICE SET AT A MAXIMUM OF 120°F. THE WATER HEATER THERMOSTAT CANNOT BE USED TO MEET THESE PROVISIONS. (2022 CPC 408.3, 409.4)
  - NEW OR RECONFIGURED SHOWER STALLS SHALL BE A MINIMUM FINISHED INTERIOR OF 1/24 SQUARE INCHES, BE CAPABLE OF ENCOMPASSING A 30 INCH DIAMETER CIRCLE. ANY DOORS SHALL SWING OUT OF THE ENCLOSURE HAVE A CLEAR OPENING OF 22 INCHES MINIMUM. (2022 CPC 408.5, 408.6)
  - SHOWER STALLS AND BATHUBS WITH SHOWER HEADS INSTALLED, SHALL HAVE WALLS FINISHED WITH A NONABSORBENT SURFACE FOR A MINIMUM OF 6 FEET ABOVE THE FLOOR. (2022 CBC 1210 AND CRC R307.2)
  - HYDRO-MASSAGE TUBS (I.E. JACUZZI TUBS) SHALL HAVE ACCESS TO THE MOTOR BE SUPPLIED BY A GFCI PROTECTED DEDICATED CIRCUIT, AND BE LISTED BY A RECOGNIZED TESTING AGENCY (I.E. UL.) ALL METAL GAS, FITTINGS, PIPING, OR OTHER METAL SURFACES, WITHIN 5 FEET OF THE INSIDE WALL OF THE HYDRO-MASSAGE TUB SHALL BE PROPERLY BONDED. HYDRO-MASSAGE TUBS SHALL BE BONDED WITH A MINIMUM #8 AWG BARE COPPER WIRE AND THE BONDING SHALL BE ACCESSIBLE. (2022 CPC 680.70)
  - UNDERLAYMENT MATERIAL USED AS BACKERS FOR WALL TILE OR SOLID SURFACE MATERIAL IN TUB AND SHOWER ENCLOSURES SHALL BE EITHER GLASS MAT/FIBER-REINFORCED GYPSUM BOARDING PANELS (I.E. DENSSHEILD, DENS ARMOR PLUS), NON-ASBESTOS FIBER-CEMENT/FIBER MAT BACK BOARD (I.E. HARDIBOARD, CEMENT BOARD). ALL MATERIAL SHALL BE INSTALLED IN ACCORDANCE WITH THE MANUFACTURER'S RECOMMENDATIONS. WATER-RESISTANT GYPSUM BOARD (I.E. PURPLE BOARD) MAY BE USED WHERE ATTACHED DIRECTLY TO STUDS, OVERLAY WITH MINIMUM GAGE 8 BUILDING PAPER AND WIRE LATH. TILE SHALL BE ATTACHED TO THE WIRE LATH. (2022 CBC 2702.4) SHOWER FLOORS SHALL BE LINED WITH AN APPROVED SHOWER PAN OR AN ON-SITE BUILT WATERIGHT APPROVED LINING (I.E. HOT MPO). ON-SITE BUILT SHOWER UNITS SHALL EXTEND A MINIMUM OF 3 INCHES VERTICALLY UP THE WALL AND SHALL BE SLOPED 1/4" PER FOOT TO POLE HOLES. (2022 CPC 408.7)
  - WHEN A CURB IS PROVIDED AT A SHOWER, IT SHALL BE A MINIMUM OF 1 INCH ABOVE THE SHOWER FLOOR AND BETWEEN 2 INCHES AND 9 INCHES ABOVE THE TOP OF THE DRAIN. A WATERIGHT NAULING FLANGE THAT EXTENDS A MINIMUM OF 1 INCH HIGH SHALL BE INSTALLED WHERE THE SHOWER FLOOR MEETS THE VERTICAL SURFACE OF THE SHOWER COMPARTMENT. THE FINISHED FLOOR OF THE SHOWER COMPARTMENT SHALL BE UNIFORMLY SLOPED BETWEEN 1/4" AND 1/2" PER FOOT TOWARDS THE DRAIN. (2022 CPC 408.5) WHERE A CURB IS NOT PROVIDED AT THE SHOWER COMPARTMENT, THE ENTIRE BATHROOM SHALL BE CONSIDERED A WET LOCATION. THE FLOORING IN THE ENTIRE BATHROOM SHALL COMPLY WITH THE WATER PROOFING REQUIREMENTS DESCRIBED ABOVE FOR SHOWER FLOORS (PREVIOUS BULLET) AND ALL LIGHTING FIXTURES SHALL BE APPROVED FOR WET LOCATIONS.

- WATER CLOSET REQUIREMENTS:**
- THE WATER CLOSET SHALL HAVE A CLEARANCE OF 30 INCHES WIDE (15 INCHES ON CENTER) AND 24 INCHES IN FRONT. (2022 CPC 402.3)
  - WHERE THE WATER CLOSET (OR OTHER PLUMBING FIXTURE) COMES INTO CONTACT WITH THE WALL OR FLOOR, THE JOINT SHALL BE CALKED AND SEALED TO BE WATERTIGHT. (2022 CPC 402.2)

- TEMPERED GLAZING (2022 CRC 2406.4, 2403.1 AND CRC 308.1, R308.4)**  
TEMPERED GLAZING SHALL BE PERMANENTLY IDENTIFIED BY A MANUFACTURER MARKING THAT IS PERMANENTLY APPLIED AND CANNOT BE REMOVED WITHOUT BEING DESTROYED (E.G. SAND BLASTED, ADD ETCHED, CERAMIC FIRED, LASER ETCHED, OR EMBOSSED).
- WITHIN A PORTION OF WALL ENCLOSING A TUB/SHOWER WHERE THE BOTTOM EXPOSED EDGE OF THE GLAZING IS LESS THAN 60 INCHES ABOVE THE STANDING SURFACE AND DRAIN LINE.
  - WITHIN 60 INCHES OF A TUB/SHOWER WHERE THE GLAZING IS LESS THAN 80 INCHES ABOVE THE WALKING SURFACE.
  - GLAZING ON THE HINGE-SIDE OF AN IN-SWINGING DOOR THAT IS INSTALLED PERPENDICULAR TO A DOOR IN A CLOSED POSITION AND WITHIN 24 INCHES OF THE DOOR.

## GREEN BUILDING

- WATER EFFICIENCY AND CONSERVATION:**  
PLUMBING FIXTURES (WATER CLOSETS AND URINALS) SHALL COMPLY WITH THE FOLLOWING:
- THE EFFECTIVE FLUSH VOLUME OF ALL WATER CLOSETS SHALL NOT EXCEED 1.28 GAL/FLUSH (COC 403.1.1)
  - THE EFFECTIVE FLUSH VOLUME OF URINALS SHALL NOT EXCEED 0.5 GAL/FLUSH (COC 403.1.2)
  - FITTINGS (FAUCETS AND SHOWERHEADS) HAVE ALL REQUIRED STANDARDS LISTED ON PLANS AND ARE IN ACCORDANCE TO COC 4.303.1.3 AND COC 403.1.4
  - AUTOMATIC IRRIGATION SYSTEM CONTROLLER FOR LANDSCAPING PROVIDED BY THE BUILDER AND INSTALLED AT THE TIME OF FINAL INSPECTION SHALL COMPLY WITH COC 4.304
- ENHANCED DURABILITY AND REDUCED MAINTENANCE:**
- ANNULAR SPACES AROUND PIPES, ELECTRIC CABLES, CONDUITS OR OTHER OPENINGS IN SOLE/RESTON PLATES AT EXTERIOR WALLS SHALL BE ROBERT PROOFED BY CLOSING SUCH OPENINGS WITH CEMENT MORTAR, CONCRETE MASONRY, OR SIMILAR METHOD ACCEPTABLE TO THE ENFORCING AGENCY PER COC 4.406.1
- BUILDING MAINTENANCE AND OPERATION:**
- AN OPERATION AND MAINTENANCE MANUAL WILL BE PROVIDED TO THE BUILDING OCCUPANT OR OWNER PER COC 4.410.1
- ENVIRONMENTAL QUALITY:**
- ANY GAS FIREPLACES SHALL BE A DIRECT-VENT SEALED-COMBUSTIBLE TYPE.
  - ANY WOOD STOVE OR PELLET STOVE SHALL COMPLY WITH US EPA PHASE II EMISSION LIMITS PER COC 4.503.1.
- POLLUTANT CONTROL:**
- AT THE TIME OF ROUGH INSTALLATION, DURING STORAGE ON THE CONSTRUCTION SITE AND UNTIL FINAL STARTUP OF THE HEATING, COOLING AND VENTILATING EQUIPMENT, ALL DUCT AND OTHER RELATED AIR DISTRIBUTION COMPONENTS OPENINGS SHALL BE COVERED WITH TAPE, PLASTIC SHEET METALS, OR OTHER METHODS ACCEPTABLE TO THE ENFORCING AGENCY TO REDUCE THE AMOUNT OF WATER, DUST OR DEBRIS, WHICH MAY ENTER THE SYSTEM PER COC 4.504.1.

- POLLUTANT CONTROL:**
- AT THE TIME OF ROUGH INSTALLATION, DURING STORAGE ON THE CONSTRUCTION SITE AND UNTIL FINAL STARTUP OF THE HEATING, COOLING AND VENTILATING EQUIPMENT, ALL DUCT AND OTHER RELATED AIR DISTRIBUTION COMPONENTS OPENINGS SHALL BE COVERED WITH TAPE, PLASTIC SHEET METALS, OR OTHER METHODS ACCEPTABLE TO THE ENFORCING AGENCY TO REDUCE THE AMOUNT OF WATER, DUST OR DEBRIS, WHICH MAY ENTER THE SYSTEM PER COC 4.504.1.
  - ADHESIVE, SEALANTS AND CAULKS SHALL MEET THE VOC OR OTHER TOXIC COMPOUND LIMITS PER COC 4.504.2.1.
  - PAINTS AND COATINGS SHALL COMPLY WITH VOC LIMITS PER COC 4.504.2.2.
  - AEROSOL PAINTS AND COATINGS SHALL MEET THE PRODUCT-WEIGHTED MFR LIMITS FOR ROC AND OTHER REQUIREMENTS PER COC 4.504.2.3.
  - DOCUMENTATION WILL BE PROVIDED, AT THE REQUEST OF THE BUILDING DIVISION, TO VERIFY COMPLIANCE WITH VOC FINISH MATERIALS PER COC 4.504.2.4.
  - CARPET SYSTEM INSTALLED IN THE BUILDING INTERIOR SHALL MEET THE TESTING AND PRODUCT REQUIREMENT PER COC 4.504.3.
  - WHERE RESILIENT FLOORING IS INSTALLED, AT LEAST 80% OF THE FLOOR AREA RECEIVING RESILIENT FLOORING WILL COMPLY WITH THE REQUIREMENTS PER COC 4.504.4.
  - HARDWOOD PLYWOOD, PARTICLEBOARD AND MEDIUM DENSITY FIBERBOARD COMPOSITE WOOD PRODUCTS USED ON THE INTERIOR AND EXTERIOR OF THE BUILDING SHALL COMPLY WITH THE LOW FORMALDEHYDE EMISSION STANDARDS PER COC 4.504.5.

- INDOOR AIR QUALITY AND EXHAUST:**
- EXHAUST FANS, WHICH ARE ENERGY STAR COMPLIANT AND ARE DUCTED TO TERMINATE OUTSIDE THE BUILDING, SHALL BE PROVIDED IN EVERY BATHROOM PER COC 4.506.1. ENVIRONMENTAL COMFORT HEATING AND AIR-CONDITIONING SYSTEM SHALL BE SIZED, DESIGNED AND HAVE THEIR EQUIPMENT SELECTED USING THE FOLLOWING METHODS: HEAT LOSS/HEAT GAIN VALUES IN ACCORDANCE WITH ANS/ACCA 2 MANUAL, J-2004 OR EQUIVALENT; DUCT SYSTEMS ARE SIZED ACCORDING TO ANS/ACCA 1, MANUAL, D-2009 OR EQUIVALENT; SELECT HEATING AND COOLING EQUIPMENT IN ACCORDANCE WITH ANS/ACCA 3, MANUAL, S-2004 OR EQUIVALENT.




- INSTALLER AND SPECIAL INSPECTOR QUALIFICATION:**
- HVAC SYSTEM INSTALLERS SHALL BE TRAINED AND CERTIFIED IN THE PROPER INSTALLATION OF HVAC SYSTEMS AND EQUIPMENT BY A RECOGNIZED TRAINING OR CERTIFICATION PROGRAM PER COC 702.1.

- VERIFICATION:**  
ON UPON REQUEST, VERIFICATION OF COMPLIANCE WITH THIS CODE MAY INCLUDE CONSTRUCTION DOCUMENTS, PLANS, SPECIFICATIONS, BUILDER OR INSTALLER CERTIFICATION, INSPECTION REPORTS, OR OTHER METHODS ACCEPTABLE TO THE BUILDING DEPARTMENT WHICH WILL SHOW SUBSTANTIAL COMPLIANCE.

## NOTES TO THRESHOLDS & LANDINGS

- THERE SHALL BE A LANDING OR FLOOR ON EACH SIDE OF EACH EXTERIOR DOOR. THE WIDTH OF EACH LANDING SHALL BE NOT LESS THAN THE DOOR SERVED. EVERY LANDING SHALL HAVE A DIMENSION OF NOT LESS THAN 36 INCHES, MEASURED IN THE DIRECTION OF TRAVEL. (2022 CRC R311.3)
- LANDING OR FINISHED FLOORS AT THE REQUIRED EGRESS DOOR SHALL BE NOT MORE THAN 1/2 INCH LOWER THAN TOP OF THE THRESHOLD. (2016 CRC R311.3.1) DOORS OTHER THAN REQUIRED EGRESS DOOR SHALL BE PROVIDED WITH LANDING OR FLOORS NOT MORE THAN 7 1/2 INCHES BELOW THE TOP OF THE THRESHOLD. (2022 CRC R311.3.2)
- THRESHOLDS AT DOORWAYS SHALL NOT EXCEED 0.75 INCHES IN HEIGHT ABOVE THE FINISHED FLOOR OR LANDING FOR SLIDING DOORS SERVING DWELLING UNITS OR 1/2 INCH ABOVE THE FINISHED FLOOR OR LANDING FOR OTHER DOORS. AND 0.5 INCHES FOR OTHER DOORS. (2022 CBC 1010.1.7 THRESHOLDS). FOR R-2 OR R-3, AND IN ADAPTABLE OR ACCESSIBLE DWELLING UNITS SEE EXCEPTION IN CBC 1010.1.7
- LANDINGS AT DOORS, LANDINGS SHALL HAVE A WIDTH NOT LESS THAN THE WIDTH OF THE STAIRWAY, OR THE DOOR, WHICHEVER IS GREATER. DOORS IN THE FULLY OPEN POSITION MUST NOT REDUCE A REQUIRED DIMENSION BY MORE THAN 7 INCHES WHERE A LANDING SERVES AN OCCUPANT LOAD OF 50 OR MORE. DOORS IN ANY POSITION SHALL NOT REDUCE THE LANDING TO LESS THAN ONE-HALF ITS REQUIRED WIDTH. LANDING SHALL HAVE A LENGTH MEASURED IN THE DIRECTION OF TRAVEL OF NOT LESS THAN 44 INCHES (2022 CBC 1010.1.6)

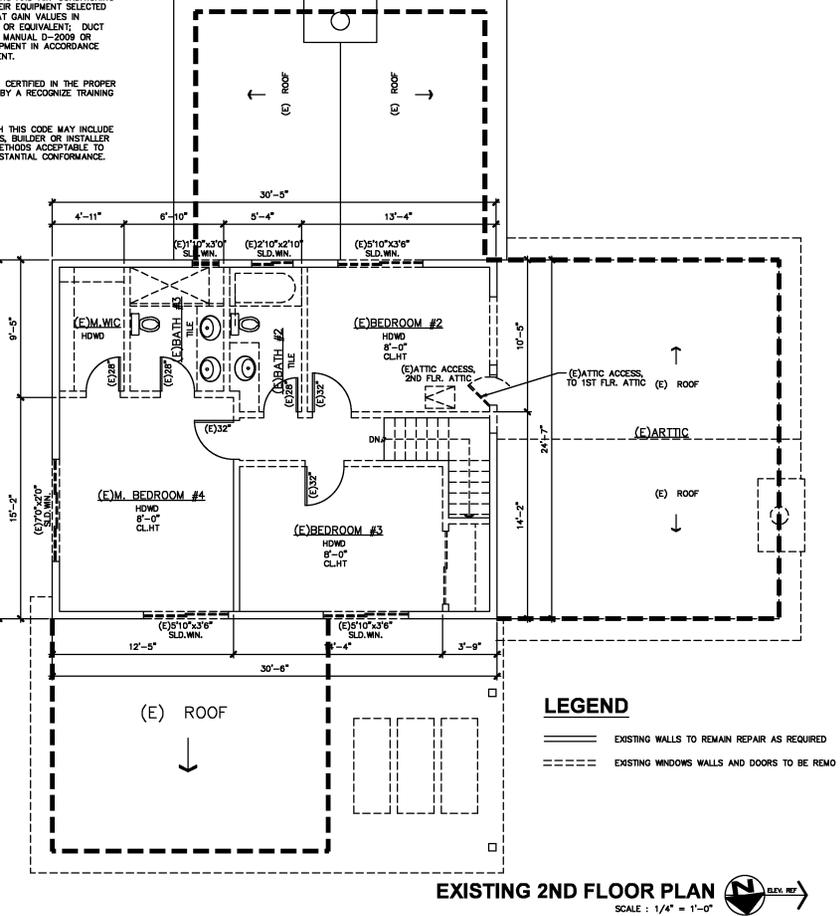

REVISIONS	DATE
SUBMITAL	06/30/25
RE-SUBMITAL $\Delta$	09/26/25

**RESIDENCE ADDITION**  
2892 Mesquite Dr, Santa Clara, CA 95051

PROJECT: \_\_\_\_\_

SHEET TITLE: \_\_\_\_\_

**NOTES**  
**EXISTING 2N**  
**FLOOR PLAN**

DRAWN BY: *FirmaWorm*

REVIEWED BY: -

DATE: -

SCALE: -


SHEET NO.: \_\_\_\_\_

**A2.1**

OF \_\_\_\_\_ SHEETS

**WALL LEGEND**

-  EXISTING CONSTRUCTION TO REMAIN
-  (N) FURRED WALL / COLUMN
-  NEW WOOD FRAMING WALL OUT OF 2X4 WOOD STUDS @ 16" O.C. AND IN THE EXTERIOR STUCCO 1/8" MIN. STUCCO O/ METAL LATH O/ TWO LAYERS OF GRADE 'D' BLDG. PAPER O/ PLYWOOD.
-  NEW 2X4 WOOD STUDS @ 16" O.C. W/ 1/2" THK. GYP. BD. ON THE BOTH SIDES
-  NEW 2X4 WOOD STUDS @ 16" O.C. W/ 1/2" THK. GYP. BD. ON THE BOTH SIDES USE WOODER BD. OR GURUCK AS BACKING MATERIAL AND WATER PROOFED MATERIAL.
-  ONE HOUR RATED WALL 2X4 WOOD STUDS @ 16" O.C. W/ 5/8" TYPE 'X' GYP. BD. @ GARAGE INTERIOR SIDE.
-  S.G. SAFETY GLAZING WINDOW/TEMPERED GLASS
-  CRAWL ACCESS 16"x24" MIN. (2022 CRC SEC. R408.4)
-  ATTIC ACCESS 22"x30" MIN. (2022 CRC SEC. R807.1) ATTIC ACCESS 36"x36" MIN. WHEN FURNACE AT ATTIC. A HEAD ROOM CLEAR HEIGHT IN A ATTIC AT LEAST 30" AT THE ATTIC ACCESS
-  EXTERIOR STAIR STEPS, MAX 7-3/4" RISE
-  SKYLIGHT 2'-0" X 4'-0"

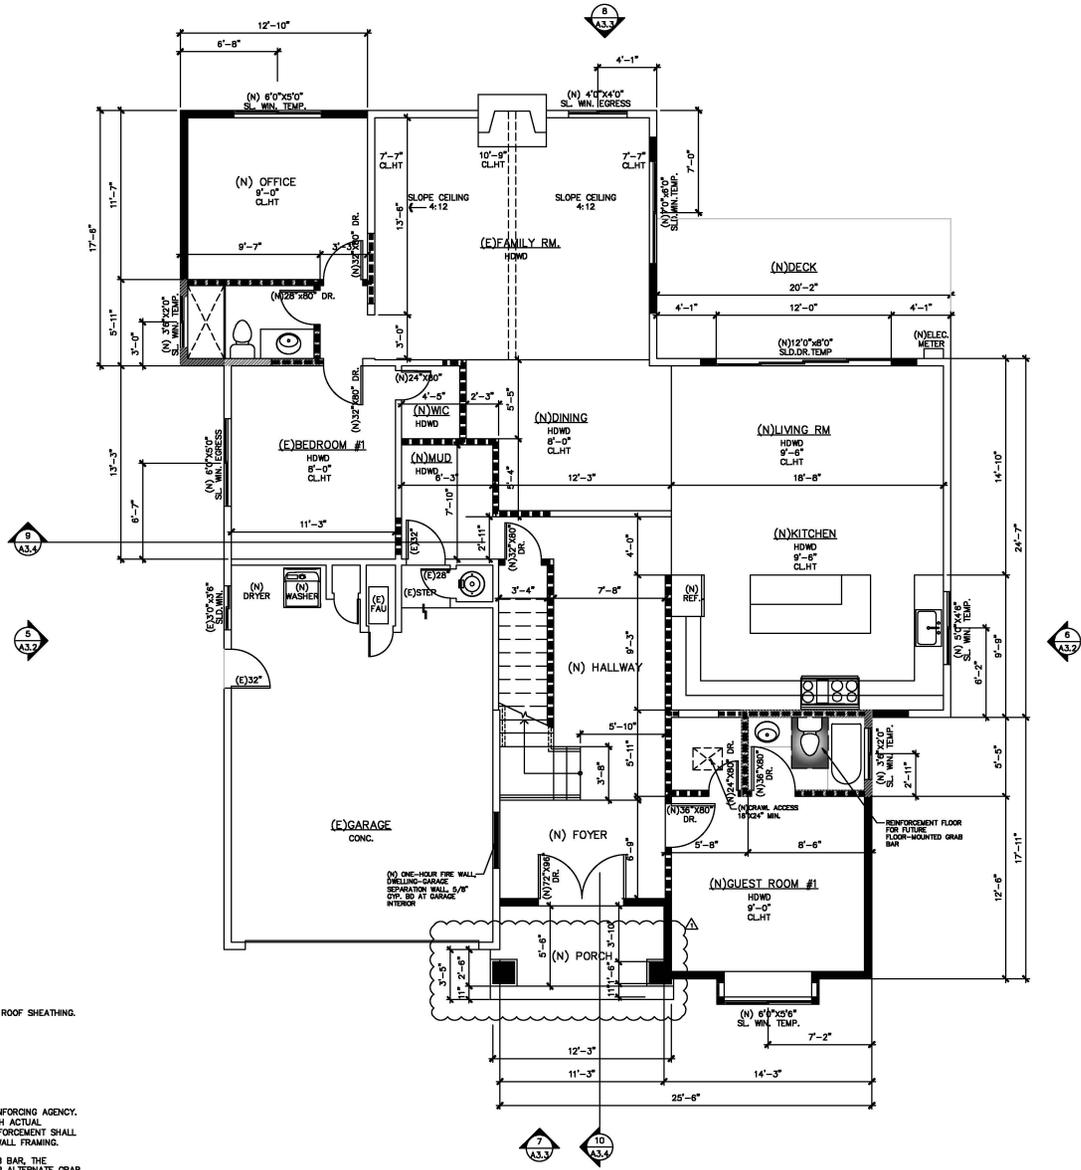

**ONE-HOUR RATED WALL NOTE:**

ONE-HOUR RATED WALL ASSEMBLY SHALL EXTEND FROM THE FOUNDATION TO THE UNDERSIDE OF THE ROOF SHEATHING.

**AGING-IN-PLACE REINFORCEMENT BATHROOM FLOOR AND WALLS INSTALLATION:**

1. REINFORCEMENT SHALL BE SOLID LUMBER OR OTHER CONSTRUCTION MATERIALS APPROVED BY THE ENFORCING AGENCY.
2. REINFORCEMENT SHALL NOT BE LESS THAN 2 BY 8 INCH NOMINAL LUMBER, [1 1/2 INCH BY 7 1/4 INCH ACTUAL DIMENSION] OR OTHER CONSTRUCTION MATERIAL PROVIDING EQUAL HEIGHT AND LOAD CAPACITY. REINFORCEMENT SHALL BE LOCATED BETWEEN 32 INCHES AND 39 1/4 INCHES ABOVE THE FINISHED FLOOR FLUSH WITH THE WALL FRAMING.
3. SHOWER REINFORCEMENT SHALL BE CONTINUOUS WHERE WALL FRAMING IS PROVIDED.
4. WHERE THE CLOSET IS NOT PLACED ADJACENT TO A SIDE WALL CAPABLE OF ACCOMMODATING A GRAB BAR, THE BATHROOM SHALL HAVE PROVISIONS FOR INSTALLATION OF FLOOR-MOUNTED, FOLD-AWAY, OR SIMILAR ALTERNATE GRAB BAR REINFORCEMENTS APPROVED BY THE ENFORCING AGENCY.

**PROPOSED FLOOR PLAN**  ELEV. REF.  
SCALE: 1/4" = 1'-0"

REVISIONS	DATE
SUBMITTAL	06/20/25
RE-SUBMITTAL 	09/26/25

**RESIDENCE ADDITION**  
2892 Mesquite Dr, Santa Clara, CA 95051


PROJECT: **PROPOSED 1ST FLOOR PLAN**

DRAWN BY: *Fiona Wong*  
REVIEWED BY: -  
DATE: -  
SCALE: -

SHEET NO.: **A2.2**  
OF SHEETS

**WALL LEGEND**

-  EXISTING CONSTRUCTION TO REMAIN
-  (N) FURRED WALL / COLUMN
-  NEW WOOD FRAMING WALL OUT OF 2X4 WOOD STUDS @ 16" O.C. AND IN THE EXTERIOR STUCCO 7/8" MIN. STUCCO O/ METAL LATH O/ TWO LAYERS OF GRADE 'D' BLDG. PAPER O/ PLYWOOD.
-  NEW 2X4 WOOD STUDS @ 16" O.C. W/ 1/2" THK. GYP. BD. ON THE BOTH SIDES
-  NEW 2X4 WOOD STUDS @ 16" O.C. W/ 1/2" THK. GYP. BD. ON THE BOTH SIDES USE WOODEN BD. OR DUROCK AS BACKING MATERIAL AND WATER PROOFED MATERIAL.
-  ONE HOUR RATED WALL 2X4 WOOD STUDS @ 16" O.C. W/ 5/8" TYPE 'X' GYP. BD. @ GARAGE INTERIOR SIDE.
-  S.G. SAFETY GLAZING WINDOW/TEMPERED GLASS
-  DRAWL ACCESS 18"x24" MIN. (2022 CRC SEC. R408.4)
-  ATTIC ACCESS 22"x30" MIN. (2022 CRC SEC. R807.1)  
ATTIC ACCESS 36"x36" MIN. WHEN FURNACE AT ATTIC. A HEAD ROOM CLEAR HEIGHT IN A ATTIC AT LEAST 30" AT THE ATTIC ACCESS\*
-  EXTERIOR STAIR STEPS, MAX 7-3/4" RISE
-  SKYLIGHT 2'-0" X 4'-0"

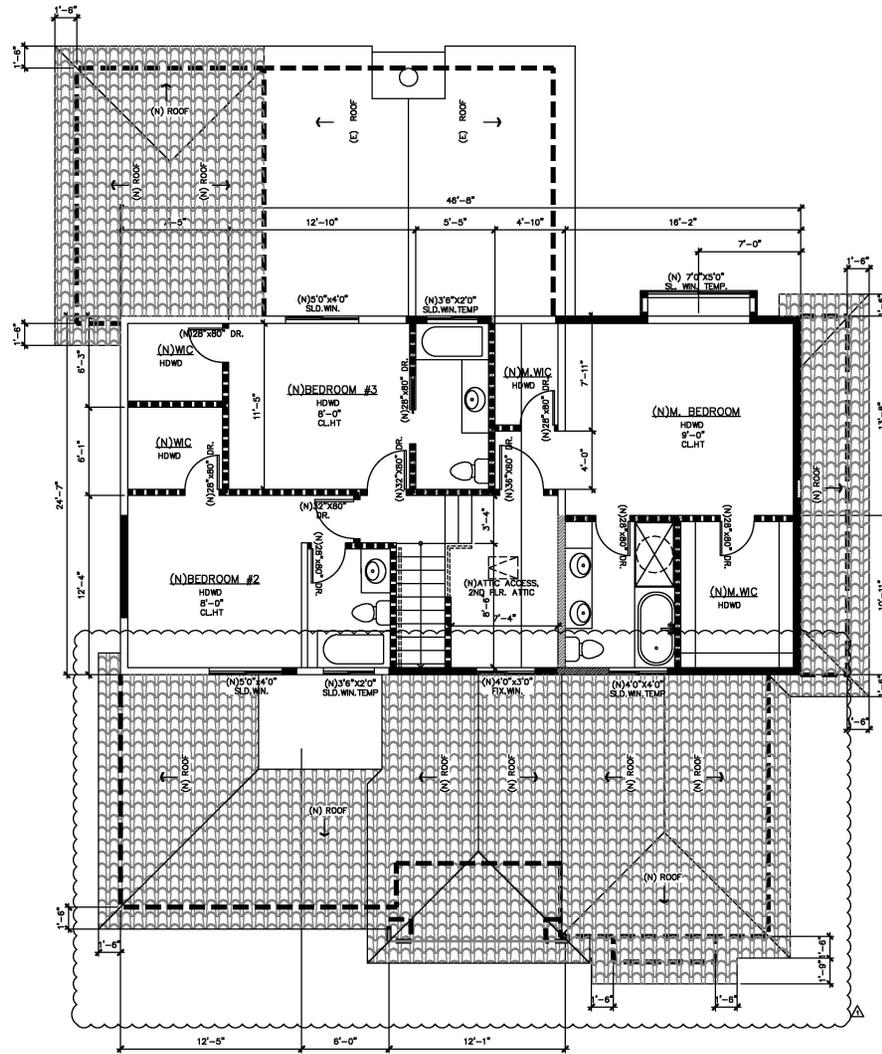

**PROPOSED 2ND FLOOR PLAN**  
SCALE: 1/4" = 1'-0" 

REVISIONS	DATE
SUBMITTAL	06/20/25
RE-SUBMITTAL 	09/26/25


**PROJECT:**  
**RESIDENCE ADDITION**  
2892 Mesquite Dr, Santa Clara, CA 95051

**SHEET TITLE:**  
**PROPOSED 2ND FLOOR PLAN**


**DRAWN BY:** *Fiona Wong*  
**REVIEWED BY:** -  
**DATE:** -  
**SCALE:** -

**SHEET NO.:**  
**A2.3**  
OF SHEETS

REVISIONS	DATE
SUBMITTAL	06/30/25
RE-SUBMITTAL $\Delta$	09/26/25

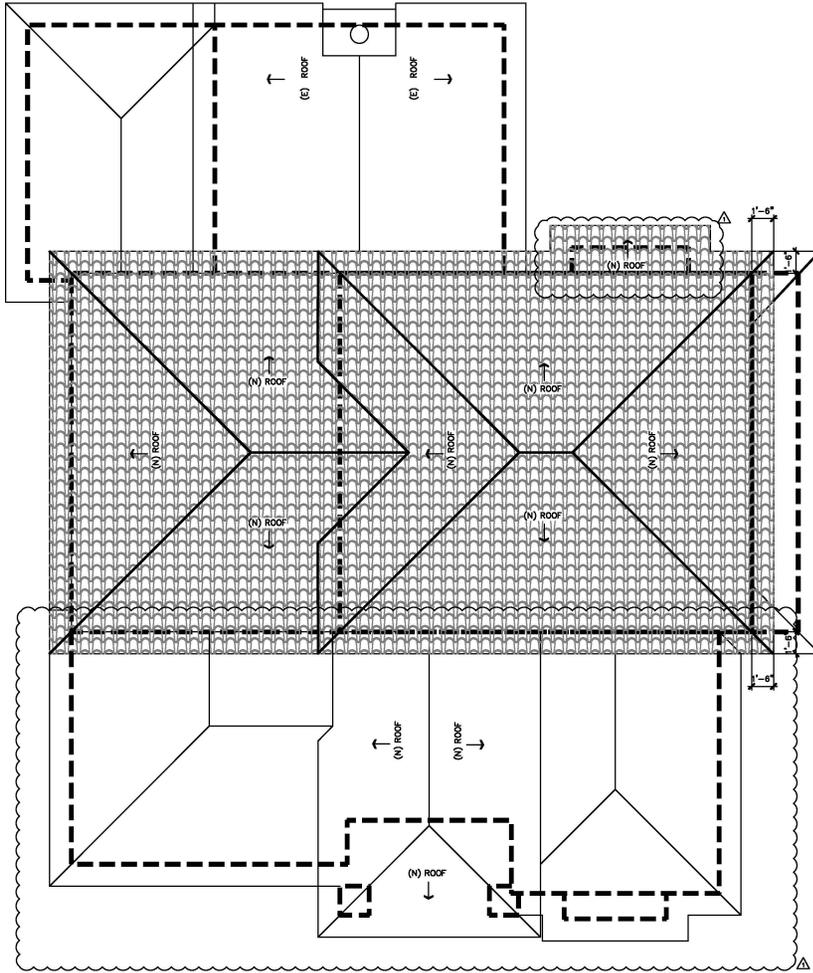

**PROPOSED ROOF PLAN**  
SCALE: 1/4" = 1'-0"

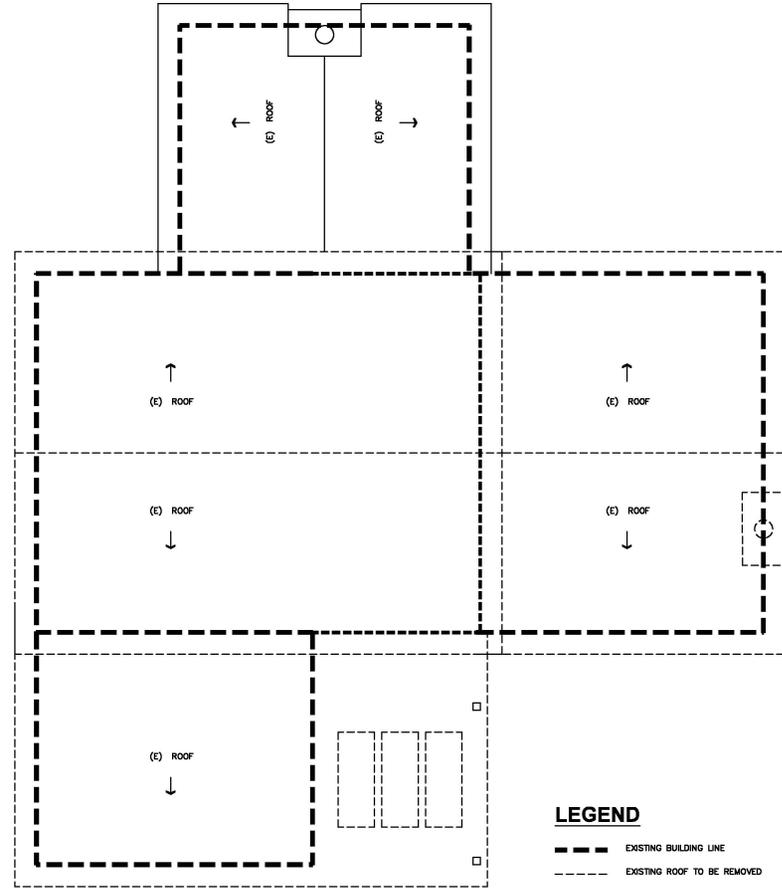


**EXISTING ROOF PLAN**  
SCALE: 1/8" = 1'-0"

**RESIDENCE ADDITION**  
2892 Mesquite Dr, Santa Clara, CA 95051


PROJECT: **RESIDENCE ADDITION**  
SHEET TITLE: **EXISTING & PROPOSED ROOF**

DRAWN BY: *Fiona Wong*  
REVIEWED BY: -  
DATE: -  
SCALE: -


SHEET NO.: **A2.4**  
OF SHEETS

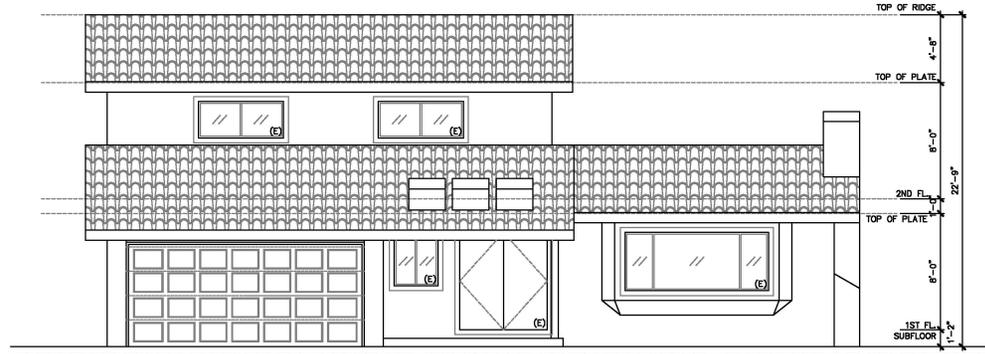

**1 NORTH EXISTING ELEVATION**  
SCALE : 1/4" = 1'-0"

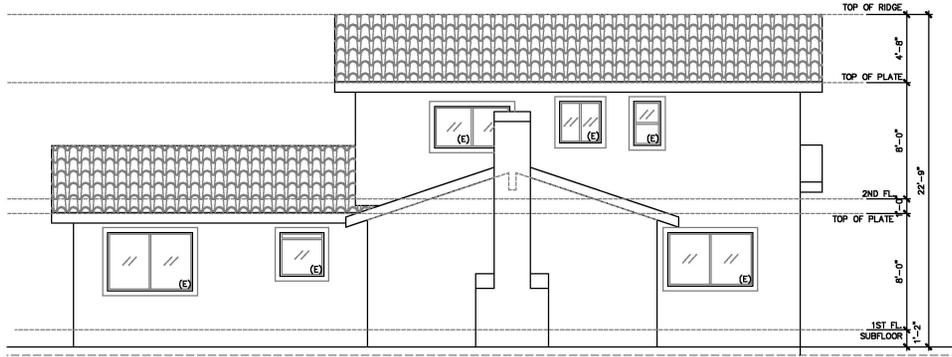

**2 SOUTH EXISTING ELEVATION**  
SCALE : 1/4" = 1'-0"

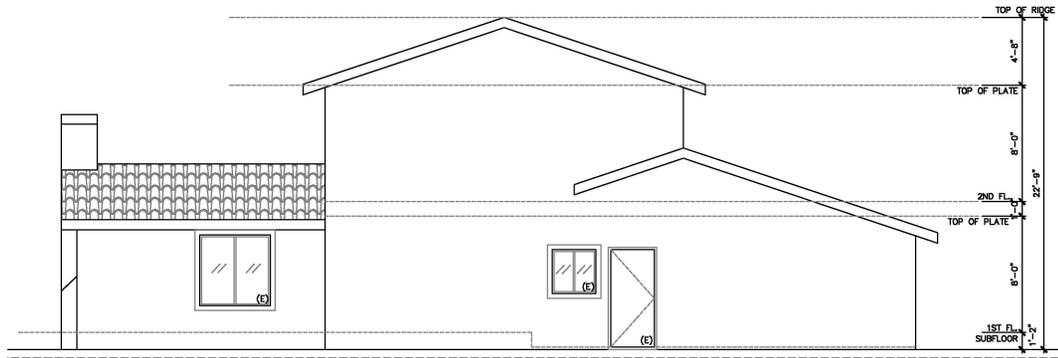

**3 EAST EXISTING ELEVATION**  
SCALE : 1/4" = 1'-0"

REVISIONS	DATE
SUBMITTAL	06/30/25
RE-SUBMITTAL $\Delta$	09/26/25

**RESIDENCE ADDITION**  
2892 Mesquite Dr, Santa Clara, CA 95051

PROJECT: **EXISTING ELEVATIONS**

SHEET TITLE: **EXISTING ELEVATIONS**

DRAWN BY: *Fiona Wong*

REVIEWED BY: -

DATE: -

SCALE: -


SHEET NO.: **A3.1**

OF SHEETS




R1

Best Buy Metals  
 DECRA VILLA STONE COATED METAL TILE ROOFING  
 RUSTICA CLAY

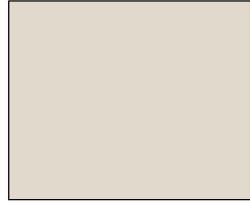



C1

BEHR  
 MASONRY STUCCO & BRICK PAINTS  
 MISTY COVE MS-48\*

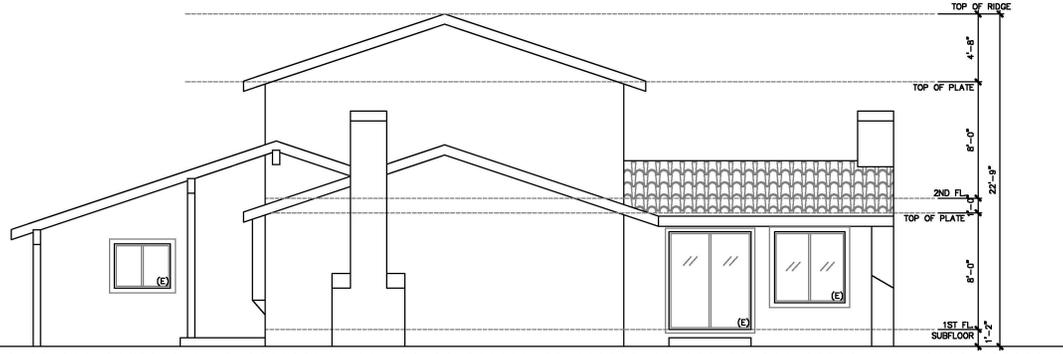

REVISIONS	DATE
SUBMITTAL	08/30/25
RE-SUBMITTAL $\Delta$	09/28/25

**4 WEST EXISTING ELEVATION**  
 SCALE: 1/4" = 1'-0"

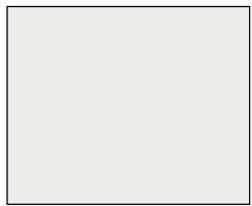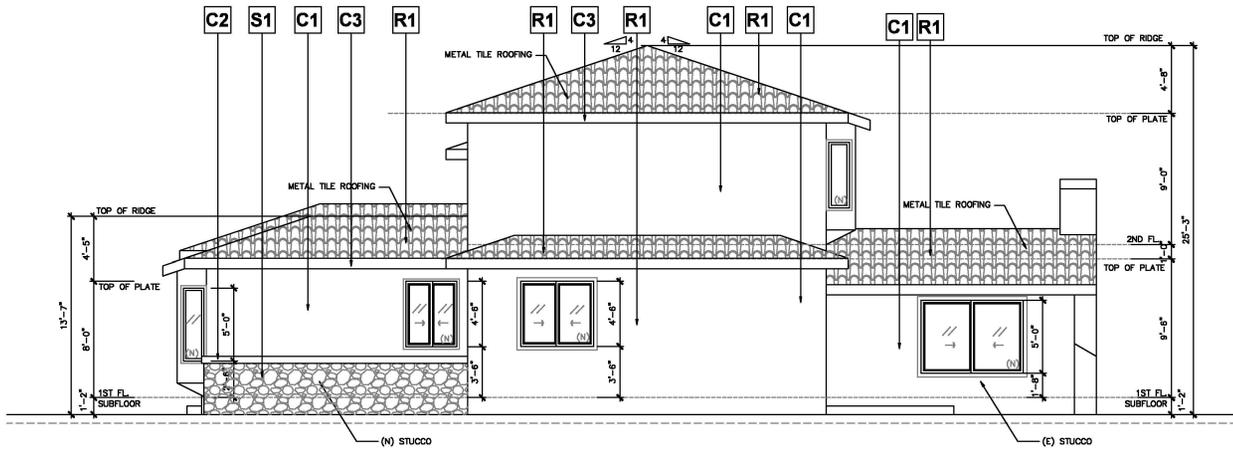

C2  
 BEHR  
 MASONRY STUCCO & BRICK PAINTS  
 MOUNTAIN SUMMIT MS-47\*




C3  
 BEHR  
 OIL-BASE & ENAMELS URETHANE ALKYD  
 WHITE 7900 (URETHANE ALKYD SATIN)

**5 WEST PROPOSED ELEVATION**  
 SCALE: 1/4" = 1'-0"



S1  
 M-ROCK  
 GEORGETOWN COBBLE STONE CONCRETE STONE VENER  
 TRADITIONAL 1.5 IN. TO 4 IN. X 5 IN. TO 9 IN.

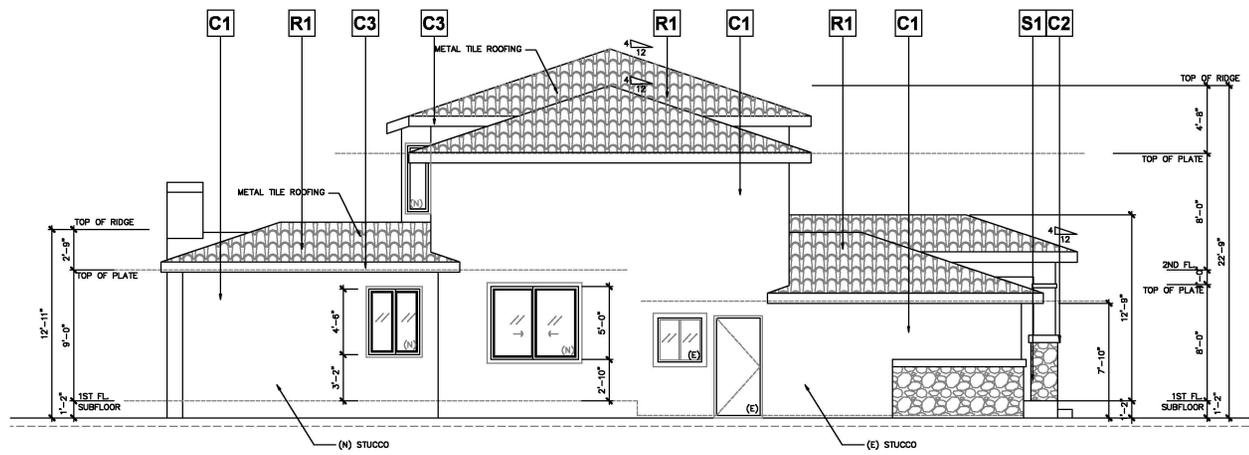

**6 EAST PROPOSED ELEVATION**

**RESIDENCE ADDITION**  
 2892 Mesquite Dr, Santa Clara, CA 95051


PROJECT: **PROPOSED ELEVATIONS**

DRAWN BY: *Fina Way*


REVIEWED BY: -  
 DATE: -  
 SCALE: -

SHEET NO.: **A3.2**

OF SHEETS

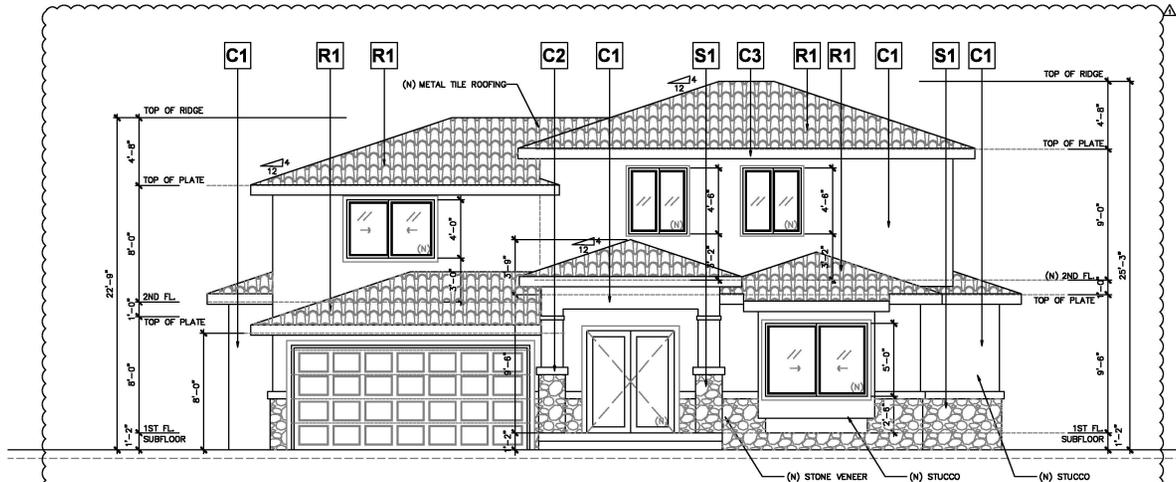

**7 NORTH PROPOSAL ELEVATION**  
SCALE: 1/4" = 1'-0"

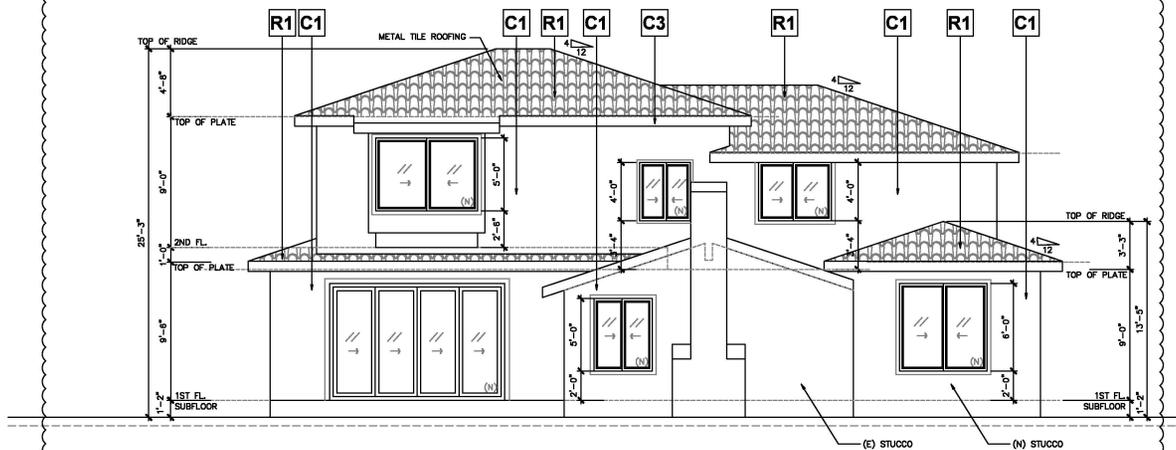

SCALE: 1/4" = 1'-0"


REVISIONS	DATE
SUBMITTAL	06/30/25
RE-SUBMITTAL $\Delta$	09/26/25

**PROJECT:**  
**RESIDENCE ADDITION**  
2892 Mesquite Dr, Santa Clara, CA 95051


**SHEET TITLE:**  
**PROPOSED ELEVATIONS**

**DRAWN BY:** *Fiona Wong*  
**REVIEWED BY:** -  
**DATE:** -  
**SCALE:** -

**SHEET NO.:**  
**A3.3**  
OF SHEETS

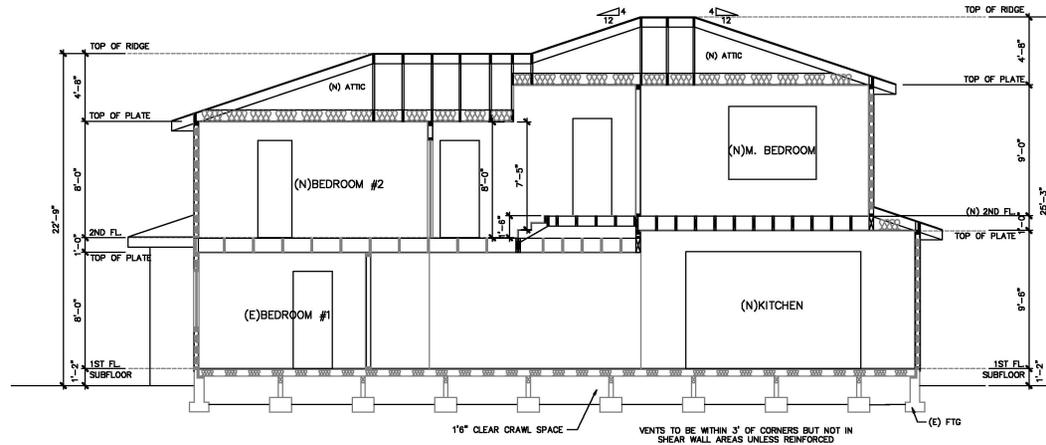

**9** PROPOSED SECTION 1  
SCALE: 1/4" = 1'-0"

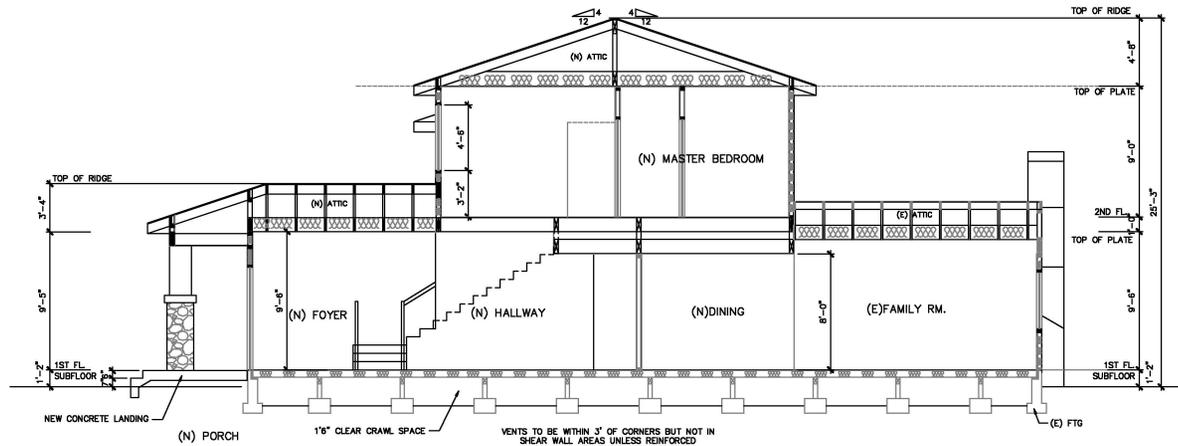

**10** PROPOSED SECTION 2  
SCALE: 1/4" = 1'-0"

REVISIONS	DATE
SUBMITAL	06/30/25
RE-SUBMITAL $\Delta$	09/26/25

**PROJECT:**  
**RESIDENCE ADDITION**  
 2892 Mesquite Dr, Santa Clara, CA 95051

**SHEET TITLE:**  
**PROPOSED SECTIONS**

**DRAWN BY:** *Fiona Wong*  
**REVIEWED BY:** -  
**DATE:** -  
**SCALE:** -

**SHEET NO.:**  
**A3.4**  
 OF SHEETS



**Attachment 2: Project Data/Compliance**

**Project Address: 2892 Mesquite Drive  
Zoning: R1-6L**

**Project Number: PLN25-00295**

<b>Standard</b>	<b>Existing</b>	<b>Proposed</b>	<b>Requirement</b>	<b>Complies? (Y/N)</b>
<b>Lot Area (SF) (min):</b>	7,351	7,351	6,000	Y
<b>Lot Area per Dwelling Unit (SF):</b>	7,351	7,351	--	--
<b>Building Square Footage (SF)</b>				
<b>1<sup>st</sup> Floor:</b>	1,363	1,984	--	--
<b>2<sup>nd</sup> Floor:</b>	718	1,116	--	--
<b>Garage:</b>	500	500	600 SF max	Y
<b>Porch/Patio:</b>	76	64	--	--
<b>Total:</b>	2,657	3,663	--	--
<b>Floor Area Ratio:</b>	0.36	0.49	--	--
<b>% of 2<sup>nd</sup> floor to 1<sup>st</sup> floor:</b>	0.52	0.56	66% max	Y
<b>Building Coverage (%)</b>				
<b>Building Coverage (All):</b>	0.26	0.34	40% max	Y
<b>Rear Yard Accessory Building Coverage:</b>	--	--	40% max	--
<b>Main Building Setbacks (FT)</b>				
<b>Front (1<sup>st</sup> floor):</b>	17	20	20	Y
<b>(2<sup>nd</sup> floor):</b>	34	37	25	Y
<b>Left Side (1<sup>st</sup> floor):</b>	5'-0	5'	5	Y
<b>(2<sup>nd</sup> floor):</b>	9'-3	9'-3	10	Y
<b>Right Side (1<sup>st</sup> floor):</b>	6' – 11"	7	5	Y
<b>(2<sup>nd</sup> floor):</b>	32' – 11"	8' – 3"	10	Y
<b>Side, Corner:</b>	--	--	--	--
<b>Rear (1<sup>st</sup> floor):</b>	22' – 9"	22' – 9"	20	Y
<b>(2<sup>nd</sup> floor):</b>	39' – 9"	39' – 9"	20	Y
<b>Height (FT)</b>				
<b>Main building:</b>	22' – 9"	25' – 3"	25	N (Conditioning Height to 25')
<b>Accessory building:</b>	--	--	--	--
<b># of Bedrooms/Bathrooms:</b>	4/2	5/5	--	--
<b>Parking:</b>				
<b>Is the site Gov. Code 65863.2 (AB 2097) eligible?</b>				N
<b>Off-street</b>	2	2	2	Y
<b>Common Living Area (SFR)</b>	35%	47%	Min 25%	Y
<b>Open Landscaped Area (Front):</b>	2,900	3,100	--	--

## Conditions of Architectural Review Approval

### PLN25-00295/ 2892 Mesquite Drive

**Architectural Review** for the construction of a 621 square foot first floor addition and a 397 square foot second floor addition in an existing two-story 2,081 square foot single-family residence with a 500 square foot attached garage in a 7,351 square foot lot.

#### GENERAL

- G1. **Permit Expiration.** This Permit shall automatically be revoked and terminated if not used within **two years** of original grant or within the period of any authorized extensions thereof. The date of granting of this Permit is the date this Permit is approved by the Development Review Officer and all appeal periods have been exhausted. The expiration date is December 17, 2027
- G2. **Conformance with Plans.** Prior to the issuance of Building Permit, the development of the site and all associate improvements shall substantially conform to the approved plans on file with the Community Development Department, Planning Division. No change to the plans will be made without prior review by the Planning Division through approval of a Minor Amendment or through an Architectural Review, at the discretion of the Director of Community Development or designee. Each change shall be identified and justified in writing.
- G3. **Conditions on Plans.** All conditions of approval for this Permit shall be reprinted and included within the first three sheets of the building permit plan sets submitted for review and approval. At all times these conditions of approval shall be on all grading and construction plans kept on the project site.
- G4. **Code Compliance.** Comply with all requirements of Building and associated codes (the California Building Code, California Electric Code, California Mechanical Code, California Plumbing Code, California Green Building Code, the California Energy Code, etc.) current at the time of application for Building Permit, that includes grading and site utility permits.

#### DESIGN / PERFORMANCE – PRIOR TO BUILDING PERMIT ISSUANCE

- P1. **Tree Protection (On-site).** Trees on-site shall be protected from construction activity through ISA tree care best practices.
- P2. **Roof Height.** The roof shall be 25 feet as required by the R1-6L zoning code.
- P3. **Guest Bedroom Setback:** The proposed guest bedroom shall adhere to the prevailing development pattern in the subdivision by reducing the footprint of the proposed guest room by providing a greater front and side setback. The setbacks shall preserve the existing sight line of the adjacent property.
- P4. **Front Yard Landscape:** Bushes and code-compliant hedges shall be added to the front yard.

#### DURING CONSTRUCTION

- P5. **Construction Hours.** Construction activity shall be limited to the hours of 7:00 a.m. to 6:00 p.m. weekdays and 9:00 a.m. to 6:00 p.m. Saturdays for projects within 300 feet of a residential use and shall not be allowed on recognized State and Federal holidays.
- P6. **Construction Trash/Debris.** During construction activities, the owner or designee is responsible for collection and pick-up of all trash and debris on-site and adjacent public right-of-way.
- P7. **Landscape Water Conservation.** The owner or designee shall ensure that landscaping installation meets City water conservation criteria in a manner acceptable to the Director of Community Development.
- E1. **Stormwater Control Measures.** The owner or designee shall incorporate Best Management Practices (BMPs) into construction plans in accordance with the City's Urban Runoff Pollution Prevention Program for construction-related water runoff measures prior to issuance of permits.

#### **OPERATIONAL CONDITIONS**

- P8. **Use of Garage.** The owner or designee shall ensure that the garage always be maintained free and clear for vehicle parking use. It shall not be used only for storage.
- P9. **Landscaping Installation & Maintenance.** The owner or designee shall ensure that the landscaping installed and accepted with this project shall be maintained on the site as per the approved plans. Any alteration or modification to the landscaping shall not be permitted unless otherwise approved by the Director of Community Development.
- P10. **Landscaping.** The owner or designee shall maintain the front yard landscaping between the house and sidewalk. New landscape areas of 500 square feet or more or rehabilitated landscape areas of 2,500 square feet or more shall conform to the California Department of Water Resources Water Efficient Landscape Ordinance.
- E2. **Stormwater Control Measures.** The owner or designee shall incorporate Best Management Practices (BMPs) into construction plans in accordance with the City's Urban Runoff Pollution Prevention Program for post-construction water runoff measures prior to issuance of a building permit.

#### **KEY:**

G = General

P = Planning Division

E = Public Works Engineering (Stormwater)

**ACKNOWLEDGEMENT AND ACCEPTANCE OF CONDITIONS OF APPROVAL**

*Permittee/Property Owner*

The undersigned agrees to each condition of approval and acknowledges and hereby agrees to use the project property on the terms and conditions set forth in this permit.

Signature: \_\_\_\_\_

Printed Name: \_\_\_\_\_

Relationship to Property: \_\_\_\_\_

Date: \_\_\_\_\_

Pursuant to Santa Clara City Code 18.128.100, the applicant shall return this document to the Department, properly signed and dated, within 30-days following the date of the Acknowledgement.

# GREEN BUILDING NOTES

**WATER EFFICIENCY AND CONSERVATION**  
 PLUMBING FIXTURES (WATER CLOSETS AND URINALS) SHALL COMPLY WITH THE FOLLOWING:  
 1. THE EFFECTIVE FLUSH VOLUME OF ALL WATER CLOSETS SHALL NOT EXCEED 1.28 GAL./FLUSH (CGC 403.1.1)  
 2. THE EFFECTIVE FLUSH VOLUME OF URINALS SHALL NOT EXCEED 0.5 GAL./FLUSH (CGC 403.1.2)  
 3. FITTINGS (FAUCETS AND SHOWERHEADS) HAVE ALL REQUIRED STANDARDS LISTED ON PLANS AND ARE IN ACCORDANCE TO CGC 4.303.1.3 AND CGC 403.1.4  
 4. AUTOMATIC IRRIGATION SYSTEM CONTROLLER FOR LANDSCAPING PROVIDED BY THE BUILDER AND INSTALLED AT THE TIME OF FINAL INSPECTION SHALL COMPLY WITH CGC 4.304

**ENHANCED DURABILITY AND SERVICE MAINTENANCE**  
 5. ANNUAL SPACES AROUND PIPES, ELECTRIC CABLES, CONDUITS OR OTHER OPENINGS IN SOLE/BOTTOM PLATES AT EXTERIOR WALLS SHALL BE RODENT PROOFED BY CLOSING SUCH OPENINGS WITH CEMENT MORTAR, CONCRETE MASONRY, OR SIMILAR METHOD ACCEPTABLE TO THE ENFORCING AGENCY PER CGC 4.406.1

**BUILDING MAINTENANCE AND OPERATION**  
 6. AN OPERATION AND MAINTENANCE MANUAL WILL BE PROVIDED TO THE BUILDING OCCUPANT OR OWNER PER CGC 4.410.1

**ENVIRONMENTAL QUALITY**  
 7. ANY GAS FIREPLACES SHALL BE A DIRECT-VENT SEALED-COMBUSTIBLE TYPE.  
 8. ANY WOOD STOVE OR PELLET STOVE SHALL COMPLY WITH US EPA PHASE II EMISSION LIMITS PER CGC 4.503.1

**POLLUTANT CONTROL**  
 9. AT THE TIME OF ROUGH INSTALLATION, DURING STORAGE ON THE CONSTRUCTION SITE AND UNTIL FINAL STARTUP OF THE HEATING, COOLING AND VENTILATING EQUIPMENT, ALL DUCT AND OTHER RELATED AIR DISTRIBUTION COMPONENTS OPENINGS SHALL BE COVERED WITH TAPE, PLASTIC, SHEET METALS, OR OTHER METHODS ACCEPTABLE TO THE ENFORCING AGENCY TO REDUCE THE AMOUNT OF WATER, DUST OR DEBRIS, WHICH MAY ENTER THE SYSTEM PER CGC 4.504.1

10. ADHESIVE, SEALANTS AND CAULKS SHALL MEET THE VOC OR OTHER TOXIC COMPOUND LIMITS PER CGC 4.504.2.1.

11. PAINTS AND COATINGS SHALL COMPLY WITH VOC LIMITS PER CGC 4.504.2.2.

12. AEROSOL PAINTS AND COATINGS SHALL MEET THE PRODUCT-WEIGHTED MIR LIMITS FOR ROC AND OTHER REQUIREMENTS PER CGC 4.504.2.3.

13. DOCUMENTATION WILL BE PROVIDED, AT THE REQUEST OF THE BUILDING DIVISION, TO VERIFY COMPLIANCE WITH VOC FINISH MATERIALS PER CGC 4.504.2.4.

14. CARPET SYSTEM INSTALLED IN THE BUILDING INTERIOR SHALL MEET THE TESTING AND PRODUCT REQUIREMENT PER CGC 4.504.3.

15. WHERE RESILIENT FLOORING IS INSTALLED, AT LEAST 80% OF THE FLOOR AREA RECEIVING RESILIENT FLOORING WILL COMPLY WITH THE REQUIREMENTS PER CGC 4.504.4.

16. HARDWOOD PLYWOOD, PARTICLEBOARD AND MEDIUM DENSITY FIBERBOARD COMPOSITE WOOD PRODUCTS USED ON THE INTERIOR AND EXTERIOR OF THE BUILDING SHALL COMPLY WITH THE LOW FORMALDEHYDE EMISSION STANDARDS PER CGC 4.504.5.

**INTERIOR MOISTURE CONTROL**  
 17. A CAPILLARY BREAK SHALL BE INSTALLED IF A SLAB ON GRADE FOUNDATION SYSTEM IS USED. THE USE OF A 4" THICK BASE OF 1/2" OR LARGER CLEAN AGGREGATE UNDER A 1/8" ML VAPOR RETARDER WITH JOINT LAPPED NOT LESS THAN 6" WILL BE PROVIDED PER CGC 4.505.2 AND CRC R506.2.3. BUILDING MATERIALS WITH VISIBLE SIGNS OF WATER DAMAGE SHALL NOT BE INSTALLED. WALL AND FLOOR FRAMING SHALL NOT BE ENCLOSED WHEN THE FRAMING MEMBERS EXCEED 19% MOISTURE CONTENT. MOISTURE CONTENT SHALL BE CHECKED PRIOR TO FINISH MATERIAL BEING APPLIED PER CGC 4.505.3.

**INDOOR AIR QUALITY AND EXHAUST**  
 18. EXHAUST FANS, WHICH ARE ENERGY STAR COMPLIANT AND BE DUCTED TO TERMINATE OUTSIDE THE BUILDING SHALL BE PROVIDED IN EVERY BATHROOM PER CGC 4.506.1. ENVIRONMENTAL CONTROL HEATING AND AIR-CONDITIONING SYSTEM SHALL BE SIZED, DESIGNED AND HAVE THEIR EQUIPMENT SELECTED USING THE FOLLOWING METHODS: HEAT LOSS/HEAT GAIN VALUES IN ACCORDANCE WITH ANSI/ACCA 2 MANUAL, 4-2004 OR EQUIVALENT; DUCT SYSTEMS ARE SIZED ACCORDING TO ANSI/ACCA 1, MANUAL D-2009 OR EQUIVALENT; SELECT HEATING AND COOLING EQUIPMENT IN ACCORDANCE WITH ANSI/ACCA 3, MANUAL S-2004 OR EQUIVALENT.

**INSTALLER AND SPECIAL INSPECTOR QUALIFICATION**  
 19. HVAC SYSTEM INSTALLERS SHALL BE TRAINED AND CERTIFIED IN THE PROPER INSTALLATION OF HVAC SYSTEMS AND EQUIPMENT BY A RECOGNIZE TRAINING OR CERTIFICATION PROGRAM PER CGC 702.1.

**VERIFICATION**  
 20. UPON REQUEST, VERIFICATION OF COMPLIANCE WITH THIS CODE MAY INCLUDE CONSTRUCTION DOCUMENTS, PLAN SPECIFICATIONS, BUILDER OR INSTALLER CERTIFICATION, INSPECTION REPORTS, OR OTHER METHODS ACCEPTABLE TO THE BUILDING DEPARTMENT WHICH WILL SHOW SUBSTANTIAL CONFORMANCE.

# SCOPE OF WORK

- ON THE FIRST FLOOR:
  - ADD ONE NEW BEDROOM AND ONE NEW BATHROOM IN THE FRONT YARD.
  - ADD NEW OFFICE IN THE REAR YARD.
  - RELOCATE KITCHEN.
  - REMOVE GARAGE PARTITION WALL.
- ON THE SECOND FLOOR:
  - RECONFIGURE LAYOUT.
  - ADD NEW BATHROOM.
- GENERAL:
  - RELOCATE FURNACE.
  - UPGRADE EXISTING ELECTRICAL METER FROM 100AMP TO 200AMP.
- FINALIZING 4/25/19 INSPECTION CORRECTION NOTICE.

# SYMBOLS

 COLUMN GRID LINE NO.	 EXISTING DOOR
 SECTION NO.	 DOOR NO.
 SECTION SHEET NO.	 DOOR SCHEDULE
 ELEVATION NO.	 DOOR TYPE
 ELEVATION SHEET NO.	 INTERIOR ELEVATIONS
 DETAIL NO.	 INDICATOR
 DETAIL SHEET NO.	 ROOM NAME
	 FLOOR FINISH

# BLDG DATA

LOT SIZE: 7,351 S.F.  
 CURRENT ZONING: R1-BL  
 PROPOSED USE: 289A  
 EXISTING PROPERTY BUILT: 1952 SFR  
 (E) BUILDING FLOOR AREA:  
 (E) 1st FLOOR: 1,363 S.F.  
 (E) 2ND FLOOR: 718 S.F.  
 (E) GARAGE: 500 S.F.  
 (E) PORCH: 76 S.F.  
 (E) TOTAL HABITABLE AREA: 2,081 S.F.  
 (E) TOTAL BUILDING AREA: 2,581 S.F.  
 PROPOSED BUILDING FLOOR AREA:  
 (E) 1st FLOOR: 1,363 S.F.  
 (N) 1ST NEW ADDITION: 621 S.F.  
 (E) 2ND FLOOR: 718 S.F.  
 (N) 2ND NEW ADDITION: 307 S.F.  
 (N) PORCH: 64 S.F.  
 (E) GARAGE: 500 S.F.  
 (N) TOTAL HABITABLE AREA: 3,099 S.F.  
 (N) TOTAL BUILDING AREA: 3,599 S.F.  
 (N) LOT COVERAGE = 2,599 / 7,351 = 0.3535 -> 34.83% > 40%  
 (N) 2ND YST = 1,157 / 1,364 = 0.849 -> 84.9%  
 (N) OPEN LANDSCAP AREA: 3,109 S.F.  
 OCCUPANCY: R37U  
 CONSTRUCTION TYPE: VB  
 STORY (CS): 2  
 AUTO. FIRE SPRINKLER: NO  
 DESIGN COMPLY WITH:  
 CITY OF SANTA CLARA MUNICIPAL CODE  
 2022 CALIFORNIA BUILDING CODE  
 2022 CALIFORNIA RESIDENTIAL CODE  
 2022 CALIFORNIA ELECTRICAL CODE  
 2022 CALIFORNIA MECHANICAL CODE  
 2022 CALIFORNIA PLUMBING CODE  
 2022 CALIFORNIA FIRE CODE  
 2022 CALIFORNIA GREEN BUILDING STANDARDS CODE  
 2022 CALIFORNIA ENERGY CODE

# VICINITY MAP



# SHEET INDEX

ARCHITECTURAL	
A1.1	TITLE SHEET & PROPOSED SITE PLAN
A1.2	EXISTING SITE PLAN & AREA CALC.
A2.0	DEMOLISH NOTE EXISTING 1ST FLOOR PLAN
A2.1	NOTE EXISTING 2ND FLOOR PLAN
A2.2	PROPOSED 1ST FLOOR PLAN
A2.3	PROPOSED 2ND FLOOR PLAN
A2.4	EXISTING & PROPOSED ROOF PLAN
A3.1	EXISTING ELEVATIONS
A3.2	PROPOSED ELEVATIONS
A3.3	PROPOSED ELEVATIONS
A3.4	PROPOSED SECTION
CBCL	GREEN BUILDING CHECK LIST

# RESIDENCE ADDITION

2892 Mesquite Dr, Santa Clara, CA 95051

APN: 296-31-032

1ST FLOOR  
 NEW ADDITION:  
 220 SQ FT

2ND FLOOR  
 NEW ADDITION:  
 379 SQ FT

1ST FLOOR  
 NEW ADDITION:  
 401 SQ FT


NEW PORCH:  
 64 SQ FT

# SITE NOTE

- LOT DRAINAGE WILL BE 5% AWAY FROM THE BUILDING AND 2% TOWARDS THE PUBLIC RIGHT-OF-WAY. LOT DRAINAGE SHALL NOT CROSS A PROPERTY LINE. CRC R401.3, CPC 1101.2
- ALL WET AND DRY UTILITIES TO SERVICE PROPOSED ADDITION ARE TO COME FROM EXISTING ON-SITE UTILITIES. CONNECTION WITHIN THE CITY ROW AND EASEMENTS IS NOT PERMITTED.
- CONSTRUCTION RELATED MATERIALS, EQUIPMENT, ETC. MUST BE STORED ON SITE UNLESS PERMITTED IN ADVANCE BY THE PUBLIC WORKS DEPARTMENT. THIS IS TO AVOID CAUSING SAFETY AND/OR OPERATIONAL ISSUES FOR THE MOVEMENTS OF PEDESTRIANS, CYCLISTS AND VEHICULAR TRAFFIC.
- PRIOR TO ANY WORK IN THE PUBLIC RIGHT-OF-WAY, OBTAIN AN ENCROACHMENT PERMIT ALONG WITH INSURANCE REQUIREMENTS FOR ALL PUBLIC IMPROVEMENTS INCLUDING A TRAFFIC CONTROL PLAN PER THE LATEST CALIFORNIA MANUAL ON UNIFORM TRAFFIC CONTROL DEVICES (MUTCD) STANDARDS TO BE REVIEWED AND APPROVED BY THE DEPARTMENT OF PUBLIC WORKS.
- INCREMENTAL WATER AND SEWER CONNECTION FEES ARE NOT TO BE COLLECTED AS COUNTY RECORDS INDICATE EXISTING DWELLING UNIT IS AT STANDARD OCCUPANCY WITH 4 BEDROOMS.
- IF THE MAIN WATER SERVICE LINE WILL BE PLASTIC, INSTALL BLUE INSULATED 18 AWG COPPER TRACER WIRE SUITABLE FOR DIRECT BURIAL ADJACENT TO THE PIPE AND SHALL TERMINATE ABOVE GROUND AT BOTH ENDS.
- NO TREES OF 38" OR GREATER IN CIRCUMFERENCE ARE TO BE REMOVED.

# LEGEND

---	PROPERTY LINE
---	ROOF LINE
---	SETBACK LINE
---	EASEMENT
---	2ND FLOOR LINE
	(N) 1ST FLOOR ADDITION
	(N) 2ND FLOOR ADDITION
	(N) PORCH

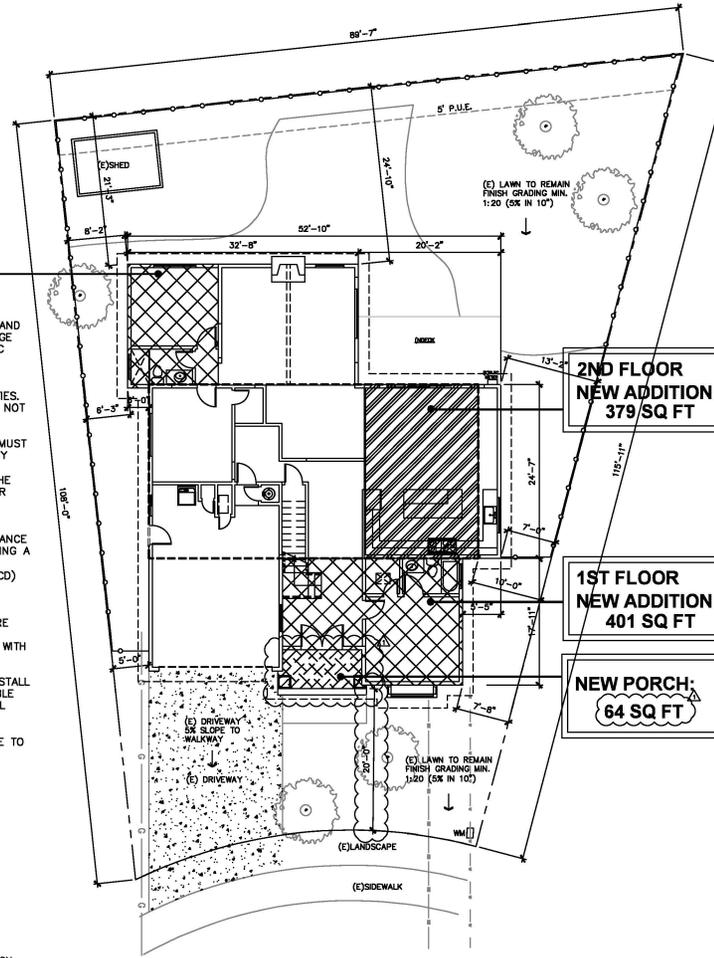

PROPOSED SITE PLAN  
 SCALE: 1/8" = 1'-0"



REVISIONS	DATE
SUBMITAL	06/20/25
RE-SUBMITAL	09/26/25

**RESIDENCE ADDITION**  
 2892 Mesquite Dr, Santa Clara, CA 95051  
 PROJECT:


SHEET TITLE:  
**TITLE SHEET  
 PROPOSED  
 SITE PLAN**

DRAWN BY: *Fiona Wong*  
 REVIEWED BY: -  
 DATE: -  
 SCALE: -  
 SHEET NO.:  
**A1.1**  
 OF SHEETS



## DEMOLITION NOTES

1. THE GENERAL CONTRACTOR SHALL FURNISH ALL LABOR AND MATERIALS AS REQUIRED TO COMPLETE DEMOLITION AND REMOVAL OF ALL ITEMS INDICATED ON TSGG DRAWINGS OR AS OTHERWISE DIRECTED BY THE OWNER.
2. THE CONTRACTOR IS TO VIEW AND VERIFY ACTUAL CONDITIONS AT ALL LOCATIONS WHERE ALTERATIONS TO THE EXISTING BUILDING OCCUR. WHEN WALLS, PARTITIONS, AND OTHER WORK EXISTS WHERE NEW WORK IS INDICATED, ALL SUCH EXISTING WORK SHALL BE REMOVED. VERIFY ALL SUCH CONDITIONS AT THE SITE.
3. THE CONTRACTOR SHALL REPORT TO ARCHITECT ANY AND ALL CONDITIONS WHICH MAY INTERFERE WITH OR OTHERWISE AFFECT OR PREVENT THE PROPER EXECUTION AND COMPLETION OF THE WORK OF THIS CONTRACT.
4. THE GENERAL CONTRACTOR SHALL EXECUTE ALL WORK WITHIN THE REGULATIONS OF THE BUILDING FOR DEMOLITION AND REMOVAL OF DEBRIS, INCLUDING OVERTIME WORK REQUIRED.
5. THE GENERAL CONTRACTOR SHALL AT ALL TIMES PROTECT THE PROPERTY OF THE BUILDING LANDLORD INCLUDING, BUT NOT LIMITED TO FLOOR COVERING, CEILING GRID AND TILE, LIGHT FIXTURES, DOORS, WINDOWS, FRAMES, HARDWARE, CABINETRY, PLUMBING FIXTURES, ELECTRICAL AND AIR CONDITIONING EQUIPMENT, PERIPHERAL ENCLOSURES, ETC.
6. THE GENERAL CONTRACTOR SHALL ERECT ALL NECESSARY PLASTIC DROP CLOTH BARRIERS TO PROTECT ADJACENT BUILDING PROPERTY WHILE DEMOLITION AND CONSTRUCTION ARE IN PROGRESS.
7. THE GENERAL CONTRACTOR SHALL SURVEY ALL EXISTING FINISHED SURFACES TO INCLUDE CORNER BEADS, STOPS, ETC. FOR CHIPS, CRACKS, HOLES, DAMAGED SURFACES, AND ANY OTHER DEFECTS CAUSING AN APPEARANCE DIFFERENT FROM A NEW FINISHED INSTALLATION. THESE DEFECTIVE SURFACES SHALL BE REPAIRED OR, IF BEYOND REPAIR, THE GENERAL CONTRACTOR SHALL REMOVE ALL EXISTING AND INSTALL NEW SURFACES TO THE SATISFACTION OF TSGG AND THE OWNER.
8. THE GENERAL CONTRACTOR SHALL INSPECT ALL EXISTING SURFACES AND WHERE AS A RESULT OF DEMOLITION, FINISHED SURFACES DO NOT ALIGN, THE EXISTING SURFACE SHALL BE CUT AND PATCHED.
9. ALL DAMAGED EXISTING AREAS TO REMAIN AND EXISTING AREAS AFFECTED BY DEMOLITION OR NEW CONSTRUCTION WORK SHOWN ON DRAWINGS SHALL BE PATCHED AS REQUIRED TO MATCH IMMEDIATE EXISTING ADJACENT AREAS IN MATERIAL, FIRE-RATING, FINISH, AND COLOR, UNLESS OTHERWISE NOTED.
10. ALL WORK DEMOLISHED SHALL BE REMOVED FROM THE PREMISES EXCEPT ITEMS TO BE REUSED OR RETURNED TO THE OWNER OR AS OTHERWISE DIRECTED.
11. IN ALL AREAS WHERE DEMOLITION (REMOVAL OF TILE, PARTITIONS, ETC. CAUSES AN UNEVENNESS IN THE SLAB, THE CONTRACTOR SHALL PATCH TO LEVEL THE SLAB TO RECEIVE NEW FINISH FLOORING.
12. ALL EXPOSED LIGHT FIXTURES, WIRING, SWITCHES, CONDUIT, AND METAL MOLDING NOT BEING REUSED SHALL BE REMOVED AND EITHER STORED OR DISPOSED OF BY THE GENERAL CONTRACTOR AS INSTRUCTED BY THE OWNER.
13. THE GENERAL CONTRACTOR SHALL FURNISH A SYSTEM OF TEMPORARY LIGHTS THROUGHOUT THE SPACE UNDER DEMOLITION AS REQUIRED.
14. THE GENERAL CONTRACTOR SHALL CAP OFF BEHIND FINISHED SURFACES ALL PROJECT PLUMBING, FLOOR ELECTRICAL, TELEPHONE OUTLETS, AND ALL OTHER PROJECTING ITEMS THAT ARE BEING ABANDONED.
15. THE GENERAL CONTRACTOR SHALL REMOVE ALL WALL CONDUITS LEFT AFTER WALL DEMOLITION INCLUDING SWITCH BOXES, PLATES, BRIDGES, OR ANY OTHER TELEPHONE OR ELECTRICAL WIRING OR EQUIPMENT. VERIFY WITH TENANT REUSE OF EXISTING CABLING PRIOR TO REMOVAL.
16. ALL "EXISTING TO REMAIN", "EXISTING", "RELOCATED", OR "NEW" ITEMS INSTALLED BY THE GENERAL CONTRACTOR, IN ADDITION TO BEING AMPPLY PROTECTED THROUGHOUT THE PERIOD OF CONSTRUCTION, SHALL BE THOROUGHLY CLEANED TO THE SATISFACTION OF TSGG PRIOR TO BEING TURNED OVER TO THE OWNER.
17. REFER TO ENGINEERING DRAWINGS FOR REMOVAL AND/OR RELOCATION IF REQUIRED OF HAVOC DUCTS, DIFFUSERS, SPRINKLER HEADS, EXOT LIGHTS, ETC.
18. SOME DOORS AND FRAMES TO BE REMOVED SHALL BE RETURNED TO OWNER. HANDLE CAREFULLY AND STORE ON SITE.

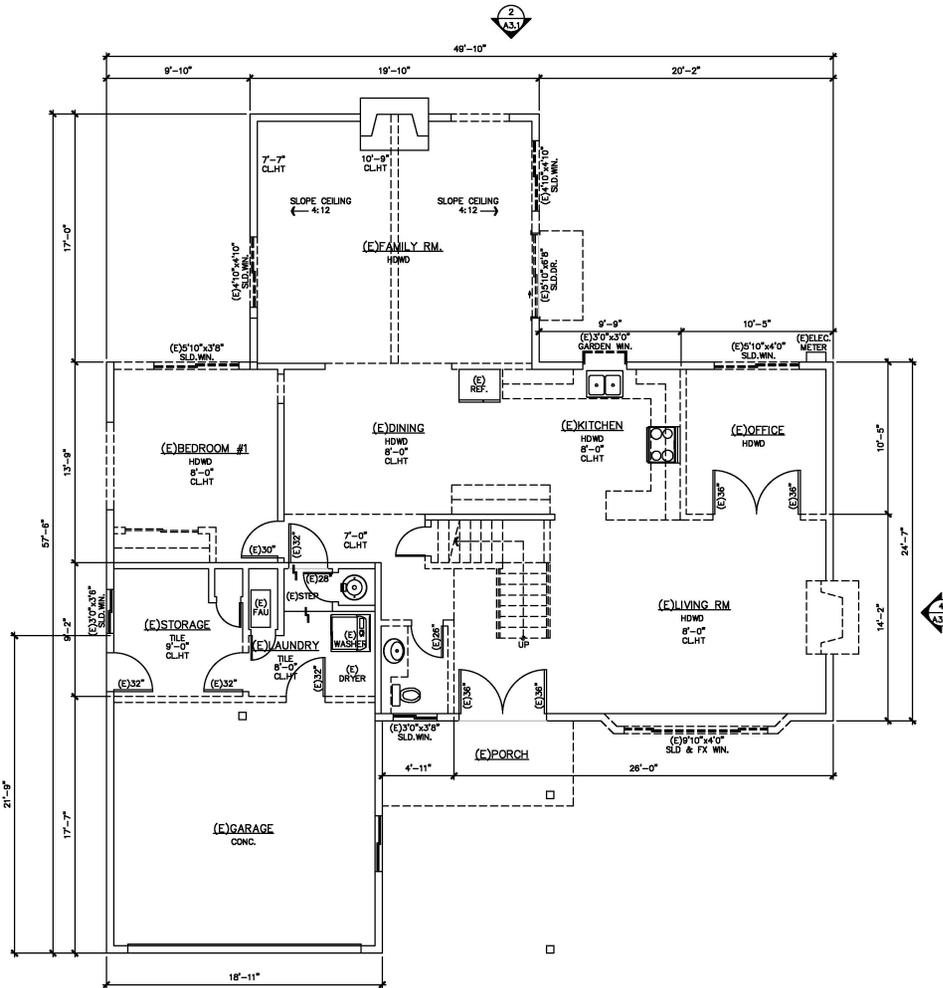

### LEGEND

- ==== EXISTING WALLS TO REMAIN REPAIR AS REQUIRED
- EXISTING WINDOWS WALLS AND DOORS TO BE REMOVED

### EXISTING 1ST FLOOR PLAN

SCALE: 1/4" = 1'-0"

REVISIONS	DATE
SUBMITTAL	06/20/25
RE-SUBMITTAL	09/26/25

**RESIDENCE ADDITION**  
2892 Mesquite Dr, Santa Clara, CA 95051

PROJECT:	RESIDENCE ADDITION
SHEET TITLE:	DEMOLITION NOTES

DRAWN BY:	Fima Wong
REVIEWED BY:	-
DATE:	-
SCALE:	-
SHEET NO.:	A2.0
OF SHEETS	

## NOTES TO WINDOW AND DOOR

- EMERGENCY EGRESS WINDOWS  
2022 CRC SECTION R310-EMERGENCY ESCAPE AND RESCUE OPENINGS  
A. PROVIDE AT LEAST ONE WINDOW IN EACH SLEEPING ROOM, BASEMENT, AND HABITABLE ATTIC.  
B. R310.2.1 MINIMUM OPENING AREA. ALL EMERGENCY ESCAPE AND RESCUE OPENINGS SHALL HAVE A MINIMUM NET CLEAR OPENING OF 5.7 SQUARE FEET.  
C. WHERE EMERGENCY ESCAPE AND RESCUE OPENINGS HAVE A MINIMUM NET CLEAR OPENING OF 5 SQUARE FEET.  
D. WHERE EMERGENCY ESCAPE AND RESCUE OPENINGS ARE PROVIDED THEY SHALL HAVE A SILL HEIGHT OF NOT MORE THAN 44 INCHES. MINIMUM OPENING HEIGHT, THE MINIMUM NET CLEAR OPENING HEIGHT SHALL BE 24 INCHES. MINIMUM OPENING WIDTH SHALL BE 20 INCHES.  
E. R310.1.1 OPERATIONAL CONSTRAINTS. EMERGENCY ESCAPE AND RESCUE OPENINGS SHALL BE MAINTAINED FREE OF ANY OBSTRUCTIONS OTHER THAN THOSE ALLOWED BY THIS SECTION AND SHALL BE OPERATIONAL FROM THE INSIDE OF THE ROOM WITHOUT THE USE OF KEYS, TOOLS OR SPECIAL KNOWLEDGE.  
F. R310.2.2 WINDOW SILL HEIGHT: WHERE A WINDOW IS PROVIDED AS AN EMERGENCY ESCAPE AND RESCUE OPENING, IT SHALL HAVE A BOTTOM OF THE CLEAR OPENING NOT GREATER THAN 44 INCHES MEASURED FROM THE FLOOR. WHERE THE SILL HEIGHT IS BELOW GRADE, IT SHALL BE PROVIDED WITH A WINDOW WELL IN ACCORDANCE WITH SEC. R310.2.3.
- FALL PROTECTION (CBC 1015.1 AND CRC R312.2)  
WHERE THE WINDOW OPENING (MEASURED AT THE WINDOW SILL) IS LOCATED MORE THAN 72 INCHES ABOVE THE EXTERIOR FINISHED GRADE, ANY WINDOW LOCATED LESS THAN 24 INCHES ABOVE THE FINISHED FLOOR OR THE INTERIOR SHALL BE EITHER FIXED GLAZING OR HAVE A PROTECTIVE GUARDRAIL WITH OPENINGS LESS THAN 4 INCHES.
- 2022 CRC SECTION R308 - SAFETY OR TEMPERED GLASS WILL BE REQUIRED FOR THE FOLLOWING LOCATIONS AND OTHER HAZARDOUS LOCATIONS REQUIRED BY CRC SECTION R308:  
A. GLAZING WITHIN 24" OF A DOOR AND WHERE BOTTOM EDGE IS LESS THAN 60" ABOVE FLOOR OR WALKING SURFACE OR WHERE THE GLAZING IS NOT PERPENDICULAR TO THE PLANE OF THE DOOR IN A CLOSED POSITION AND WITHIN 24 INCHES OF THE HINGE SIDE.  
B. WHERE THE GLAZING IS LESS THAN 36" ABOVE THE PLANE OF THE ADJACENT WALKING SURFACE AND WITHIN 36" HORIZONTALLY FROM THE WALKING SURFACE OF STAIRWAYS, LANDINGS AND RAMPS AND WITHIN A 60-DEGREE ARC LESS THAN 180 DEGREES FROM THE BOTTOM TREAD NOSING.
- TEMPERED GLAZING LABEL (2022 CRC SEC. 2406)  
WHERE REQUIRED, TEMPERED GLAZING (EXCEPT TEMPERED SPARKING GLASS) SHALL BE PERMANENTLY IDENTIFIED BY A MANUFACTURER MARKING THAT IS PERMANENTLY APPLIED AND CANNOT BE REMOVED WITHOUT BEING DESTROYED (E.G. SAND BLASTED, ADD ETCHED, CERAMIC FIRED, LASER ETCHED, OR EMBOSSED). STICKERS ATTACHED TO THE WINDOW ARE NOT SUFFICIENT.
- 2022 CRC SECTION R303 - ALL HABITABLE ROOMS SHALL HAVE AN AGGREGATE GLAZING AREA OF NOT LESS THAN 8 PERCENT OF THE FLOOR AREA OF SUCH ROOMS. THE KITCHEN IS A HABITABLE ROOM. (2022 CRC SECTION R303.1) AMEND THE PLANS TO SPECIFY AND SHOW HOW NATURAL LIGHT SHALL BE PROVIDED FOR THE KITCHEN OR SHOW THAT THE KITCHEN MEETS ONE OF THE EXCEPTIONS OF 2022 CRC, SEC. R303.10 OR SHOW THAT NATURAL LIGHT SHALL BE PROVIDED FROM AN ADJOINING ROOM IN ACCORDANCE. (2022 CRC, SEC. R303.2).
- PLEASE SEE TITLE 24 ENERGY REPORT CF-1R FORMS FOR REAL U VALUES OF WINDOWS OR DOORS.

## NOTES TO BUILDING

- BRACED WALL PANELS SHALL BEGIN NO MORE THAN 8 FEET (2440 MM) FROM EACH END OF A BRACED WALL LINE AND SHALL BE SPACED AT A MAXIMUM OF 25 FEET (7620 MM) ON CENTER. (2022 CRC R602.12.5)
- IN R-3 AND U OCCUPANCIES, NO OPENINGS ARE ALLOWED IN WALLS 3 FEET OR CLOSER TO PROPERTY LINE. OPENINGS IN WALLS BETWEEN 3 FEET AND UP TO 5 FEET FROM PROPERTY LINE CAN BE UP TO 25% OF AREA. WALLS LESS THAN 5 FEET FROM THE PROPERTY LINE MUST BE FIRE RESISTIVE CONSTRUCTION. (2022 CRC TABLE 301.1) FIRE RESISTIVE CONSTRUCTION SHALL NOT EXTEND INTO THE AREA WHERE OPENINGS ARE PROHIBITED. THIS MEANS THAT AN EAVE CAN EXTEND TO A POINT 24 INCHES FROM THE PROPERTY LINE, BUT NO CLOSER.
- PROVIDE 2X6 @ ALL PLUMBING WALL LOAD BEARING WALL AS INDICATED ON STRUCTURE DWG.
- PLATE WASHERS, A MINIMUM OF 0.229 INCH BY 3 INCHES (5.8 MM BY 76 MM BY 76 MM) IN SIZE SHALL BE PROVIDED BETWEEN THE FOUNDATION SILL AND THE NUT EXCEPT WHERE APPROVED ANCHOR STRAPS ARE USED. (2022 CRC R602.11.1)
- SURFACE DRAINAGE SHALL BE DIVERTED TO A STORM SEWER CONVEYANCE OR OTHER APPROVED POINT OF COLLECTION THAT DOES NOT CREATE A HAZARD. LOTS SHALL BE GRADED TO DRAIN SURFACE WATER AWAY FROM FOUNDATION WALLS. THE GRADE SHALL FALL A MINIMUM OF 6 INCHES (152 MM) WITHIN THE FIRST 10 FEET (3048 MM). (2022 CRC R401.3)
- DUCT PENETRATION: DUCTS IN THE GARAGE AND DUCTS PENETRATING THE WALLS OR CEILING SEPARATING THE DWELLING FROM GARAGE SHALL BE CONSTRUCTED OF A MIN. NO. 26 GAGE SHEET STEEL OR OTHER PROVIDED MATERIALS AND SHALL NOT HAVE OPENINGS INTO THE GARAGE. (2022 CRC SEC. R302.5.2)
- MIN. ROOM AREA: HABITABLE ROOMS, EXCEPT KITCHENS, SHALL HAVE A MIN. OF 70 SQUARE FEET OF FLOOR AREA. MIN. DIMENSION: HABITABLE ROOMS SHALL BE NOT LESS THAN 7 FT IN ANY DIMENSION (2022 CRC SEC. R304)
- PROVIDE CORRECT TYPE GLAZING FOR ALL GLAZING LOCATED IN HAZARDOUS LOCATIONS AS SPECIFIED IN (2022 CRC SEC. R306.4.)
- BATHUBS AND SHOWERS IN ALL OCCUPANCIES SHALL BE FINISHED WITH A NONABSORBENT SURFACE TO A HEIGHT OF 6- FEET ABOVE THE FLOOR. (2022 CRC SEC. R307)
- PROVIDE AN APPROVED ATTIC ACCESS 22"x30" WITH 30 INCHES MINIMUM VERTICAL HEADROOM. (2022 CRC SEC. R807.1)
- ENCLOSED ACCESSIBLE SPACE NUDDER STAIRS SHALL HAVE WALLS, UNDER-STAR SURFACES, AND ANY SOFFITS PROTECTED ON THE ENCLOSED SIDE WITH 1/2 INCH GYPSUM BOARD. (2022 CRC SEC. R302.7)
- PROVIDE ATTIC VENTILATION AS PER (2022 CRC SEC. R806 AND THE CALIFORNIA ENERGY STANDARDS COMMISSION.)
- FACTORY BUILT FIREPLACES AND FACTORY BUILT CHIMNEYS SHALL BE LISTED AND INSTALLED IN ACCORDANCE WITH LISTING AND THE MANUFACTURER'S INSTRUCTIONS AS PER (2022 CRC SEC. R1004 AND R1005.)
- PROVIDE UNDER FLOOR CLEARANCES AS PER 2013 CRC SECTION R317, A MINIMUM OF 12" CLEARANCE TO UNDER FLOOR GRIDDERS AND 18" CLEARANCE TO FLOOR JOISTS IS REQUIRED UNLESS PRESERVATIVE-TREATED WOOD OR WOOD NATURALLY DURABLE TO DECAY IS UTILIZED. A MINIMUM 18-INCH BY 24-INCH ACCESS OPENING SHALL BE PROVIDED TO THE DRAIN. SPACE. (2022 CRC SEC. R406.4.)
- FIRE BLOCKING AND DRAFT STOPPING SHALL BE INSTALLED ACCORDING. (2022 CRC SEC. R302.1.1)
- ALL GYPSUM BOARD, STUCCO, PLASTER, AND LATH SHALL BE INSTALLED. (2022 CRC CHAPTER 7.)
- EXTERIOR WALL COVERINGS SHALL BE APPLIED. (2022 CRC SEC. R703.)
- ALL CHIMNEYS ATTACHED TO ANY APPLIANCE OR FIREPLACE THAT BURNS SOLID FUEL SHALL BE EQUIPPED WITH AN APPROVED SPARK ARRESTER. (2022 CRC R1003.9.2)
- FIXTURES SHALL BE SPACED IN ACCORDANCE WITH THE CALIFORNIA PLUMBING CODE. (2022 CRC R307.1)

- SURFACE DRAINAGE SHALL BE DIVERTED TO A STORM SEWER CONVEYANCE OR OTHER APPROVED POINT OF COLLECTION THAT DOES NOT CREATE A HAZARD. LOTS SHALL BE GRADED TO DRAIN SURFACE WATER AWAY FROM FOUNDATION WALLS. THE GRADE SHALL FALL A MINIMUM OF 6 INCHES (152 MM) WITHIN THE FIRST 10 FEET (3048 MM). (2022 CRC R401.3)

## NOTES TO BATHROOM

- TUB/SHOWER REQUIREMENTS  
FOLLOWING IS A LISTING OF THE GENERAL REQUIREMENTS BASED ON THE 2022 CALIFORNIA BUILDING CODE, 2022 CALIFORNIA RESIDENTIAL CODE, 2016 CALIFORNIA ELECTRIC CODE, 2022 CALIFORNIA GREEN BUILDING STANDARDS (CALGREEN), AND 2022 CALIFORNIA ENERGY EFFICIENCY STANDARDS. THIS BROCHURE IS INTENDED TO PROVIDE GENERAL INFORMATION, CONTACT THE BUILDING SAFETY DIVISION FOR ANY QUESTIONS OR ADDITIONAL INFORMATION.
- THE MIXING VALVE IN A SHOWER (INCLUDING A TUB) SHALL BE PRESSURE BALANCING SET AT A MAXIMUM 120°F. THE WATER-FILLER VALVE IN BATHUBS AND SHOWERS SHALL HAVE A TEMPERATURE LIMITING DEVICE SET AT A MAXIMUM OF 120°F. THE WATER HEATER THERMOSTAT CANNOT BE USED TO MEET THESE PROVISIONS. (2022 CPC 408.3, 409.4)
  - NEW OR RECONFIGURED SHOWER STALLS SHALL BE A MINIMUM FINISHED INTERIOR OF 1/24 SQUARE INCHES, BE CAPABLE OF ENCOMPASSING A 30 INCH DIAMETER CIRCLE. ANY DOORS SHALL SWING OUT OF THE ENCLOSURE HAVE A CLEAR OPENING OF 22 INCHES MINIMUM. (2022 CPC 408.5, 408.6)
  - SHOWER STALLS AND BATHUBS WITH SHOWER HEADS INSTALLED, SHALL HAVE WALLS FINISHED WITH A NONABSORBENT SURFACE FOR A MINIMUM OF 6 FEET ABOVE THE FLOOR. (2022 CBC 1210 AND CRC R307.2)
  - HYDRO-MASSAGE TUBS (I.E. JACUZZI TUBS) SHALL HAVE ACCESS TO THE MOTOR BE SUPPLIED BY A GFCI PROTECTED DEDICATED CIRCUIT, AND BE LISTED BY A RECOGNIZED TESTING AGENCY (I.E. UL.) ALL METAL GAS, FITTINGS, PIPING, OR OTHER METAL SURFACES, WITHIN 5 FEET OF THE INSIDE WALL OF THE HYDRO-MASSAGE TUB SHALL BE PROPERLY BONDED. HYDRO-MASSAGE TUBS SHALL BE BONDED WITH A MINIMUM #8 AWG BARE COPPER WIRE AND THE BONDING SHALL BE ACCESSIBLE. (2022 CPC 600.70)
  - UNDERLAYMENT MATERIAL USED AS BACKERS FOR WALL TILE OR SOLID SURFACE MATERIAL IN TUB AND SHOWER ENCLOSURES SHALL BE EITHER GLASS MAT/FIBER-REINFORCED GYPSUM BOARDING PANELS (I.E. DENSSHELD, DENS ARMOR PLUS), NON-ASBESTOS FIBER-CEMENT/FIBER MAT BACK BOARD (I.E. HARDIBOARD, CEMENT BOARD). ALL MATERIAL SHALL BE INSTALLED IN ACCORDANCE WITH THE MANUFACTURER'S RECOMMENDATIONS. WATER-RESISTANT GYPSUM BOARD (I.E. PURPLE BOARD) MAY BE USED WHERE ATTACHED DIRECTLY TO STUDS, OVERLAY WITH MINIMUM GAGE 8 BUILDING PAPER AND WIRE LATH. TILE SHALL BE ATTACHED TO THE WIRE LATH. (2022 CBC 2702.4) SHOWER FLOORS SHALL BE LINED WITH AN APPROVED SHOWER PAN OR AN ON-SITE BUILT WATERIGHT APPROVED LINING (I.E. HOT MPO). ON-SITE BUILT SHOWER UNITS SHALL EXTEND A MINIMUM OF 3 INCHES VERTICALLY UP THE WALL AND SHALL BE SLOPED 1/4" PER FOOT TO POLE HOLES. (2022 CPC 408.7)

- WHEN A CURB IS PROVIDED AT A SHOWER, IT SHALL BE A MINIMUM OF 1 INCH ABOVE THE SHOWER FLOOR AND BETWEEN 2 INCHES AND 9 INCHES ABOVE THE TOP OF THE DRAIN. A WATER-TIGHT NAILING FLANGE THAT EXTENDS A MINIMUM OF 1 INCH HIGH SHALL BE INSTALLED WHERE THE SHOWER FLOOR MEETS THE VERTICAL SURFACE OF THE SHOWER COMPARTMENT. THE FINISHED FLOOR OF THE SHOWER COMPARTMENT SHALL BE UNIFORMLY SLOPED BETWEEN 1/4" AND 1/2" PER FOOT TOWARDS THE DRAIN. (2022 CPC 408.5) WHERE A CURB IS NOT PROVIDED AT THE SHOWER COMPARTMENT, THE ENTIRE BATHROOM SHALL BE CONSIDERED A WET LOCATION. THE FLOORING IN THE ENTIRE BATHROOM SHALL COMPLY WITH THE WATER PROOFING REQUIREMENTS DESCRIBED ABOVE FOR SHOWER FLOORS (PREVIOUS BULLET) AND ALL LIGHTING FIXTURES SHALL BE APPROVED FOR WET LOCATIONS.

- WATER CLOSET REQUIREMENTS
- THE WATER CLOSET SHALL HAVE A CLEARANCE OF 30 INCHES WIDE (15 INCHES ON CENTER) AND 24 INCHES IN FRONT. (2022 CPC 402.3)
  - WHERE THE WATER CLOSET (OR OTHER PLUMBING FIXTURE) COMES INTO CONTACT WITH THE WALL OR FLOOR, THE JOINT SHALL BE CALKED AND SEALED TO BE WATERTIGHT. (2022 CPC 402.2)

- TEMPERED GLAZING (2022 CRC 2406.4, 2403.1 AND CRC 308.1, R308.4)  
TEMPERED GLAZING SHALL BE PERMANENTLY IDENTIFIED BY A MANUFACTURER MARKING THAT IS PERMANENTLY APPLIED AND CANNOT BE REMOVED WITHOUT BEING DESTROYED (E.G. SAND BLASTED, ADD ETCHED, CERAMIC FIRED, LASER ETCHED, OR EMBOSSED).

- WITHIN A PORTION OF WALL ENCLOSING A TUB/SHOWER WHERE THE BOTTOM EXPOSED EDGE OF THE GLAZING IS LESS THAN 60 INCHES ABOVE THE STANDING SURFACE AND DRAIN LINE.
- WITHIN 60 INCHES OF A TUB/SHOWER WHERE THE GLAZING IS LESS THAN 80 INCHES ABOVE THE WALKING SURFACE.
- GLAZING ON THE HINGE-SIDE OF AN IN-SWINGING DOOR THAT IS INSTALLED PERPENDICULAR TO A DOOR IN A CLOSED POSITION AND WITHIN 24 INCHES OF THE DOOR.

## GREEN BUILDING

WATER EFFICIENCY AND CONSERVATION  
PLUMBING FIXTURES (WATER CLOSETS AND URINALS) SHALL COMPLY WITH THE FOLLOWING:

- THE EFFECTIVE FLUSH VOLUME OF ALL WATER CLOSETS SHALL NOT EXCEED 1.28 GAL/FLUSH (COC 403.1.1)
  - THE EFFECTIVE FLUSH VOLUME OF URINALS SHALL NOT EXCEED 0.5 GAL/FLUSH (COC 403.1.2)
  - FITTINGS (FAUCETS AND SHOWERHEADS) HAVE ALL REQUIRED STANDARDS LISTED ON PLANS AND ARE IN ACCORDANCE TO COC 4.303.1.3 AND COC 403.1.4
  - AUTOMATIC IRRIGATION SYSTEM CONTROLLER FOR LANDSCAPING PROVIDED BY THE BUILDER AND INSTALLED AT THE TIME OF FINAL INSPECTION SHALL COMPLY WITH COC 4.304
- ENHANCED DURABILITY AND REDUCED MAINTENANCE
- ANNULAR SPACES AROUND PIPES, ELECTRIC CABLES, CONDUITS OR OTHER OPENINGS IN SOLE/RESTON PLATES AT EXTERIOR WALLS SHALL BE ROBERT PROOFED BY CLOSING SUCH OPENINGS WITH CEMENT MORTAR, CONCRETE MASONRY, OR SIMILAR METHOD ACCEPTABLE TO THE ENFORCING AGENCY PER COC 4.406.1

BUILDING MAINTENANCE AND OPERATION

- AN OPERATION AND MAINTENANCE MANUAL WILL BE PROVIDED TO THE BUILDING OCCUPANT OR OWNER PER COC 4.410.1

ENVIRONMENTAL QUALITY

- ANY GAS FIREPLACES SHALL BE A DIRECT-VENT SEALED-COMBUSTIBLE TYPE.

- ANY WOOD STOVE OR PELLET STOVE SHALL COMPLY WITH US EPA PHASE II EMISSION LIMITS PER COC 4.503.1.

- POLLUTANT CONTROL
- AT THE TIME OF ROUGH INSTALLATION, DURING STORAGE ON THE CONSTRUCTION SITE AND UNTIL FINAL STARTUP OF THE HEATING, COOLING AND VENTILATING EQUIPMENT, ALL DUCT AND OTHER RELATED AIR DISTRIBUTION COMPONENTS OPENINGS SHALL BE COVERED WITH TAPE, PLASTIC SHEET METALS, OR OTHER METHODS ACCEPTABLE TO THE ENFORCING AGENCY TO REDUCE THE AMOUNT OF WATER, DUST OR DEBRIS, WHICH MAY ENTER THE SYSTEM PER COC 4.504.1.

- ADHESIVE, SEALANTS AND CAULKS SHALL MEET THE VOC OR OTHER TOXIC COMPOUND LIMITS PER COC 4.504.2.1.



- PAINTS AND COATINGS SHALL COMPLY WITH VOC LIMITS PER COC 4.504.2.2.
- AEROSOL PAINTS AND COATINGS SHALL MEET THE PRODUCT-WEIGHTED MFR LIMITS FOR ROC AND OTHER REQUIREMENTS PER COC 4.504.2.3.

- DOCUMENTATION WILL BE PROVIDED, AT THE REQUEST OF THE BUILDING DIVISION, TO VERIFY COMPLIANCE WITH VOC FINISH MATERIALS PER COC 4.504.2.4.
- CARPET SYSTEM INSTALLED IN THE BUILDING INTERIOR SHALL MEET THE TESTING AND PRODUCT REQUIREMENT PER COC 4.504.3.

- WHERE RESILIENT FLOORING IS INSTALLED, AT LEAST 80% OF THE FLOOR AREA RECEIVING RESILIENT FLOORING WILL COMPLY WITH THE REQUIREMENTS PER COC 4.504.4.

- HARDWOOD PLYWOOD, PARTICLEBOARD AND MEDIUM DENSITY FIBERBOARD COMPOSITE WOOD PRODUCTS USED ON THE INTERIOR AND EXTERIOR OF THE BUILDING SHALL COMPLY WITH THE LOW FORMALDEHYDE EMISSION STANDARDS PER COC 4.504.5.

- INDOOR MOISTURE CONTROL
- A CAPILLARY BREAK SHALL BE INSTALLED IF A SLAB ON GRADE FOUNDATION SYSTEM IS USED. THE USE OF A 4" THICK BASE OF 1/2" OR LARGER CLEAR AGGREGATE UNDER A 6 MIL VAPOR BARRIER WITH JOINT LAPED NOT LESS THAN 6" WILL BE PROVIDED PER COC 4.505.2 AND CRC R506.2.3. BUILDING MATERIALS WITH VISIBLE SIGNS OF WATER DAMAGE SHALL NOT BE INSTALLED. WALL AND FLOOR FRAMING SHALL NOT BE ENCLOSED WHEN THE FRAMING MEMBERS EXCEED 100% MOISTURE CONTENT SHALL BE CHECKED PRIOR TO FINISH MATERIAL BEING APPLIED. PER COC 4.505.3.

- INDOOR AIR QUALITY AND EXHAUST
- EXHAUST FANS, WHICH ARE ENERGY STAR COMPLIANT AND ARE DUCTED TO TERMINATE OUTSIDE THE BUILDING, SHALL BE PROVIDED IN EVERY BATHROOM PER COC 4.506.1. ENVIRONMENTAL CONTROL HEATING AND AIR-CONDITIONING SYSTEM SHALL BE SIZED, DESIGNED AND HAVE THEIR EQUIPMENT SELECTED USING THE FOLLOWING METHODS: HEAT LOSS/HEAT GAIN VALUES IN ACCORDANCE WITH ANS/ACCA 2 MANUAL, J-2004 OR EQUIVALENT; DUCT SYSTEMS ARE SIZED ACCORDING TO ANS/ACCA 1, MANUAL, D-2009 OR EQUIVALENT; SELECT HEATING AND COOLING EQUIPMENT IN ACCORDANCE WITH ANS/ACCA 3, MANUAL, S-2004 OR EQUIVALENT.

INSTALLER AND SPECIAL INSPECTOR QUALIFICATION


- HVAC SYSTEM INSTALLERS SHALL BE TRAINED AND CERTIFIED IN THE PROPER INSTALLATION OF HVAC SYSTEMS AND EQUIPMENT BY A RECOGNIZED TRAINING OR CERTIFICATION PROGRAM PER COC 702.1.

VERIFICATION

ON UPON REQUEST, VERIFICATION OF COMPLIANCE WITH THIS CODE MAY INCLUDE CONSTRUCTION DOCUMENTS, PLANS, SPECIFICATIONS, BUILDER OR INSTALLER CERTIFICATION, INSPECTION REPORTS, OR OTHER METHODS ACCEPTABLE TO THE BUILDING DEPARTMENT WHICH WILL SHOW SUBSTANTIAL COMPLIANCE.

## NOTES TO THRESHOLDS & LANDINGS

- THERE SHALL BE A LANDING OR FLOOR ON EACH SIDE OF EACH EXTERIOR DOOR. THE WIDTH OF EACH LANDING SHALL BE NOT LESS THAN THE DOOR SERVED. EVERY LANDING SHALL HAVE A DIMENSION OF NOT LESS THAN 36 INCHES, MEASURED IN THE DIRECTION OF TRAVEL. (2022 CRC R311.3)
- LANDING OR FINISHED FLOORS AT THE REQUIRED EGRESS DOOR SHALL BE NOT MORE THAN 1/2 INCH LOWER THAN TOP OF THE THRESHOLD. (2016 CRC R311.3.1) DOORS OTHER THAN REQUIRED EGRESS DOOR SHALL BE PROVIDED WITH LANDING OR FLOORS NOT MORE THAN 7 1/2 INCHES BELOW THE TOP OF THE THRESHOLD. (2022 CRC R311.3.2)
- THRESHOLDS AT DOORWAYS SHALL NOT EXCEED 0.75 INCHES IN HEIGHT ABOVE THE FINISHED FLOOR OR LANDING FOR SLIDING DOORS SERVING DWELLING UNITS OR 1/2 INCH ABOVE THE FINISHED FLOOR OR LANDING FOR OTHER DOORS. AND 0.5 INCHES FOR OTHER DOORS. (2022 CBC 1010.1.7 THRESHOLDS), FOR R-2 OR R-3, AND IN ADAPTABLE OR ACCESSIBLE DWELLING UNITS SEE EXCEPTION IN CBC 1010.1.7
- LANDINGS AT DOORS, LANDINGS SHALL HAVE A WIDTH NOT LESS THAN THE WIDTH OF THE STAIRWAY, OR THE DOOR, WHICHEVER IS GREATER. DOORS IN THE FULLY OPEN POSITION MUST NOT REDUCE A REQUIRED DIMENSION BY MORE THAN 7 INCHES WHERE A LANDING SERVES AN OCCUPANT LOAD OF 50 OR MORE. DOORS IN ANY POSITION SHALL NOT REDUCE THE LANDING TO LESS THAN ONE-HALF ITS REQUIRED WIDTH. LANDING SHALL HAVE A LENGTH MEASURED IN THE DIRECTION OF TRAVEL OF NOT LESS THAN 44 INCHES (2022 CBC 1010.1.6)

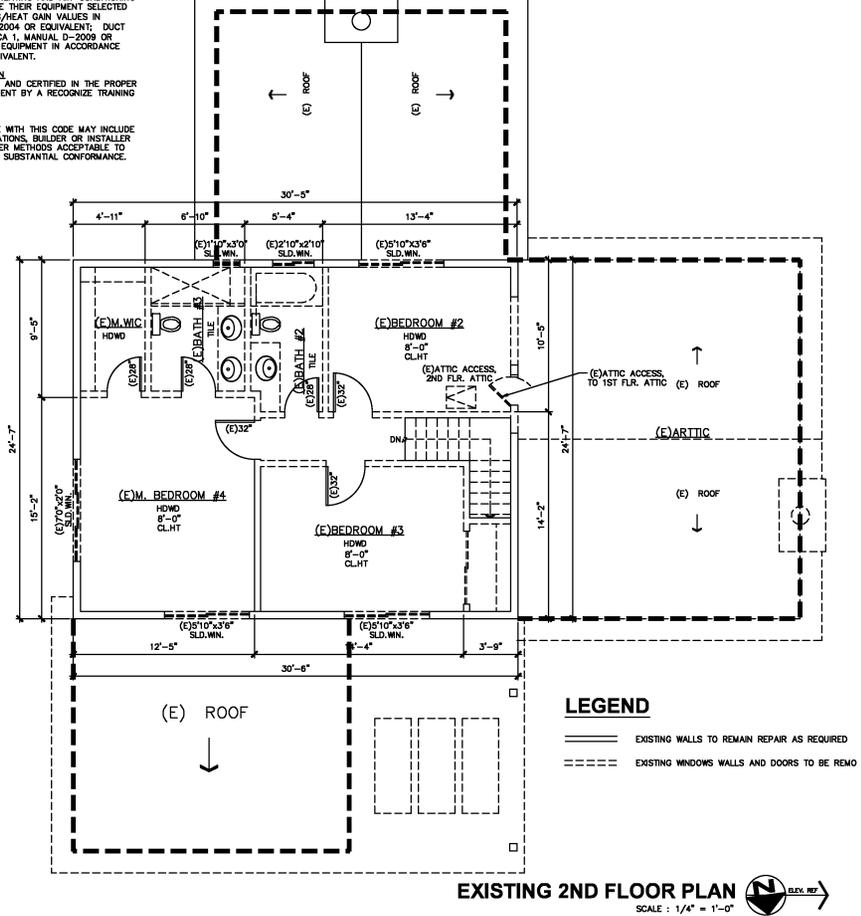

REVISIONS	DATE
SUBMITAL	06/30/25
RE-SUBMITAL $\Delta$	09/26/25

**RESIDENCE ADDITION**  
2892 Mesquite Dr, Santa Clara, CA 95051

PROJECT: **RESIDENCE ADDITION**

SHEET TITLE: **NOTES EXISTING 2N FLOOR PLAN**

DRAWN BY: *FirmaWorm*

REVIEWED BY: -

DATE: -

SCALE: -


SHEET NO.: **A2.1**

OF SHEETS

**EXISTING 2ND FLOOR PLAN**  
SCALE: 1/4" = 1'-0"

**WALL LEGEND**

-  EXISTING CONSTRUCTION TO REMAIN
-  (N) FURRED WALL / COLUMN
-  NEW WOOD FRAMING WALL OUT OF 2X4 WOOD STUDS @ 16" O.C. AND IN THE EXTERIOR STUCCO 1/8" MIN. STUCCO O/ METAL LATH O/ TWO LAYERS OF GRADE 'D' BLDG. PAPER O/ PLYWOOD.
-  NEW 2X4 WOOD STUDS @ 16" O.C. W/ 1/2" THK. GYP. BD. ON THE BOTH SIDES
-  NEW 2X4 WOOD STUDS @ 16" O.C. W/ 1/2" THK. GYP. BD. ON THE BOTH SIDES USE WOODER BD. OR GURUCK AS BACKING MATERIAL AND WATER PROOFED MATERIAL.
-  ONE HOUR RATED WALL 2X4 WOOD STUDS @ 16" O.C. W/ 5/8" TYPE 'X' GYP. BD. @ GARAGE INTERIOR SIDE.
-  S.G. SAFETY GLAZING WINDOW/TEMPERED GLASS
-  CRAWL ACCESS 16"x24" MIN. (2022 CRC SEC. R408.4)
-  ATTIC ACCESS 22"x30" MIN. (2022 CRC SEC. R807.1) ATTIC ACCESS 36"x36" MIN. WHEN FURNACE AT ATTIC. A HEAD ROOM CLEAR HEIGHT IN A ATTIC AT LEAST 30" AT THE ATTIC ACCESS
-  EXTERIOR STAIR STEPS, MAX 7-3/4" RISE
-  SKYLIGHT 2'-0" X 4'-0"

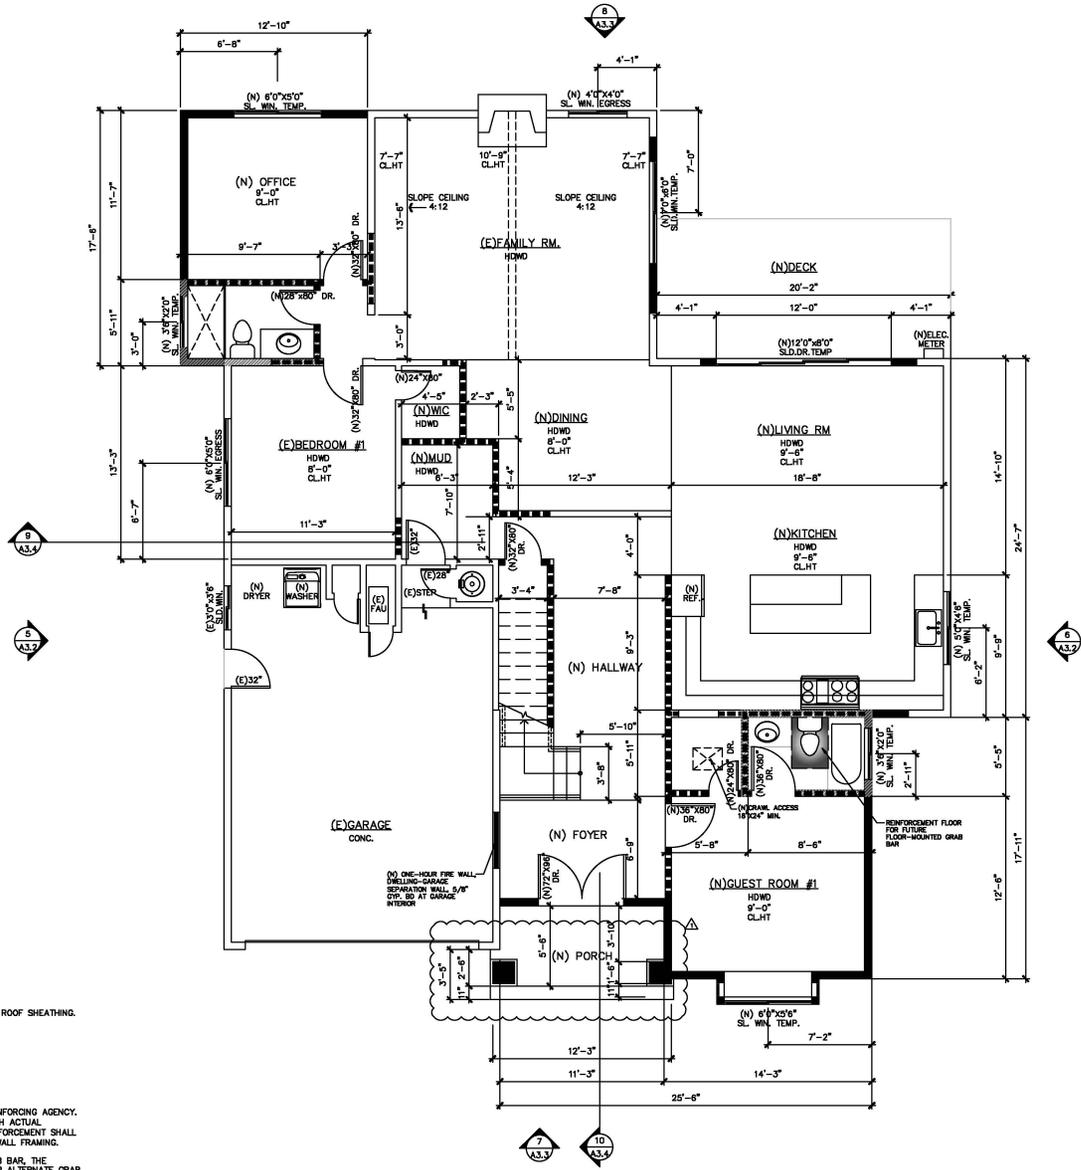

**ONE-HOUR RATED WALL NOTE:**

ONE-HOUR RATED WALL ASSEMBLY SHALL EXTEND FROM THE FOUNDATION TO THE UNDERSIDE OF THE ROOF SHEATHING.

**AGING-IN-PLACE REINFORCEMENT BATHROOM FLOOR AND WALLS INSTALLATION:**

1. REINFORCEMENT SHALL BE SOLID LUMBER OR OTHER CONSTRUCTION MATERIALS APPROVED BY THE ENFORCING AGENCY.
2. REINFORCEMENT SHALL NOT BE LESS THAN 2 BY 8 INCH NOMINAL LUMBER, [1 1/2 INCH BY 7 1/4 INCH ACTUAL DIMENSION] OR OTHER CONSTRUCTION MATERIAL PROVIDING EQUAL HEIGHT AND LOAD CAPACITY. REINFORCEMENT SHALL BE LOCATED BETWEEN 32 INCHES AND 39 1/4 INCHES ABOVE THE FINISHED FLOOR FLUSH WITH THE WALL FRAMING.
3. SHOWER REINFORCEMENT SHALL BE CONTINUOUS WHERE WALL FRAMING IS PROVIDED.
4. WHERE THE CLOSET IS NOT PLACED ADJACENT TO A SIDE WALL CAPABLE OF ACCOMMODATING A GRAB BAR, THE BATHROOM SHALL HAVE PROVISIONS FOR INSTALLATION OF FLOOR-MOUNTED, FOLD-AWAY, OR SIMILAR ALTERNATE GRAB BAR REINFORCEMENTS APPROVED BY THE ENFORCING AGENCY.

**PROPOSED FLOOR PLAN**  ELEV. REF.  
SCALE: 1/4" = 1'-0"

REVISIONS	DATE
SUBMITTAL	06/20/25
RE-SUBMITTAL 	09/26/25

**RESIDENCE ADDITION**  
2892 Mesquite Dr, Santa Clara, CA 95051


PROJECT: **PROPOSED 1ST FLOOR PLAN**

DRAWN BY: *Fiona Wong*  
REVIEWED BY: -  
DATE: -  
SCALE: -

SHEET NO.: **A2.2**  
OF SHEETS

**WALL LEGEND**

-  EXISTING CONSTRUCTION TO REMAIN
-  (N) FURRED WALL / COLUMN
-  NEW WOOD FRAMING WALL OUT OF 2X4 WOOD STUDS @ 16" O.C. AND IN THE EXTERIOR STUCCO 7/8" MIN. STUCCO O/ METAL LATH O/ TWO LAYERS OF GRADE 'D' BLDG. PAPER O/ PLYWOOD.
-  NEW 2X4 WOOD STUDS @ 16" O.C. W/ 1/2" THK. GYP. BD. ON THE BOTH SIDES
-  NEW 2X4 WOOD STUDS @ 16" O.C. W/ 1/2" THK. GYP. BD. ON THE BOTH SIDES USE WOODEN BD. OR DUROCK AS BACKING MATERIAL AND WATER PROOFED MATERIAL.
-  ONE HOUR RATED WALL 2X4 WOOD STUDS @ 16" O.C. W/ 5/8" TYPE 'X' GYP. BD. @ GARAGE INTERIOR SIDE.
-  S.G. SAFETY GLAZING WINDOW/TEMPERED GLASS
-  DRAWL ACCESS 18"x24" MIN. (2022 CRC SEC. R408.4)
-  ATTIC ACCESS 22"x30" MIN. (2022 CRC SEC. R807.1)  
ATTIC ACCESS 36"x36" MIN. WHEN FURNACE AT ATTIC. A HEAD ROOM CLEAR HEIGHT IN A ATTIC AT LEAST 30" AT THE ATTIC ACCESS\*
-  EXTERIOR STAIR STEPS, MAX 7-3/4" RISE
-  SKYLIGHT 2'-0" X 4'-0"

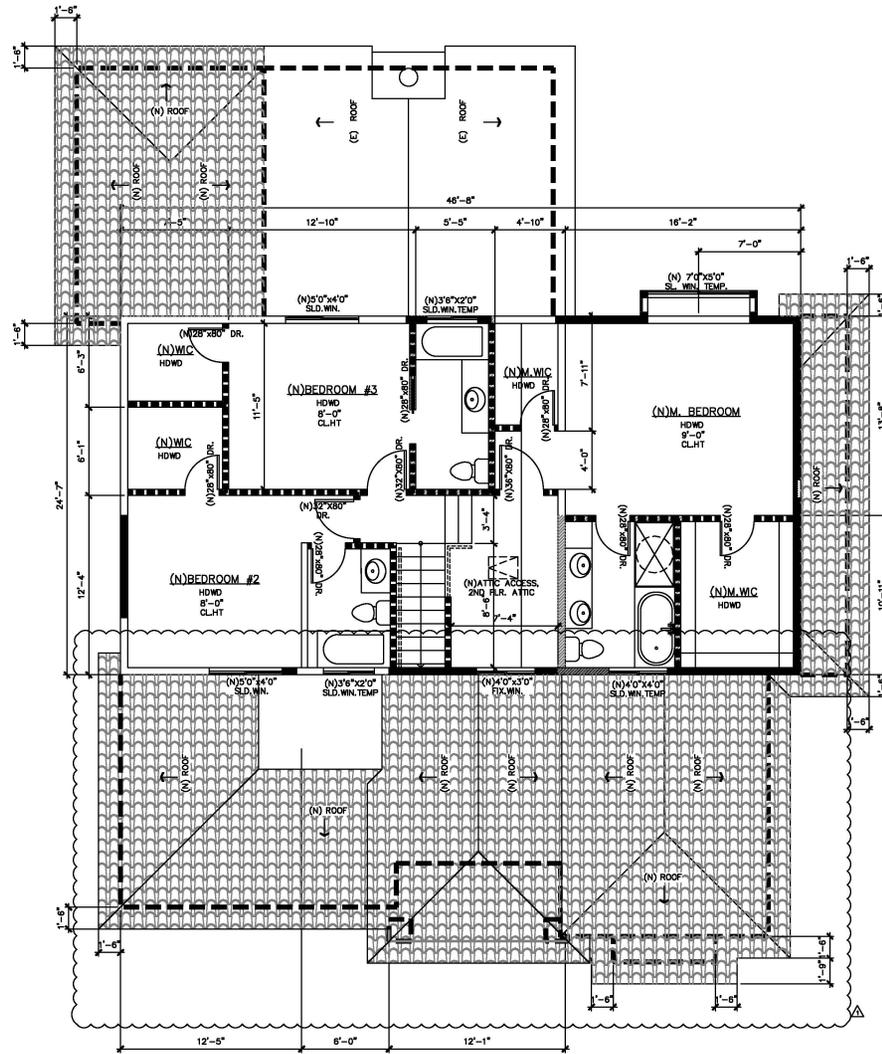

**PROPOSED 2ND FLOOR PLAN**  
SCALE : 1/4" = 1'-0" 

REVISIONS	DATE
SUBMITTAL	06/20/25
RE-SUBMITTAL 	09/26/25


**PROJECT:**  
**RESIDENCE ADDITION**  
2892 Mesquite Dr, Santa Clara, CA 95051

**SHEET TITLE:**  
**PROPOSED 2ND FLOOR PLAN**


**DRAWN BY:** *Fiona Wong*  
**REVIEWED BY:** -  
**DATE:** -  
**SCALE:** -

**SHEET NO.:**  
**A2.3**  
OF SHEETS

REVISIONS	DATE
SUBMITTAL	06/30/25
RE-SUBMITTAL $\Delta$	09/26/25

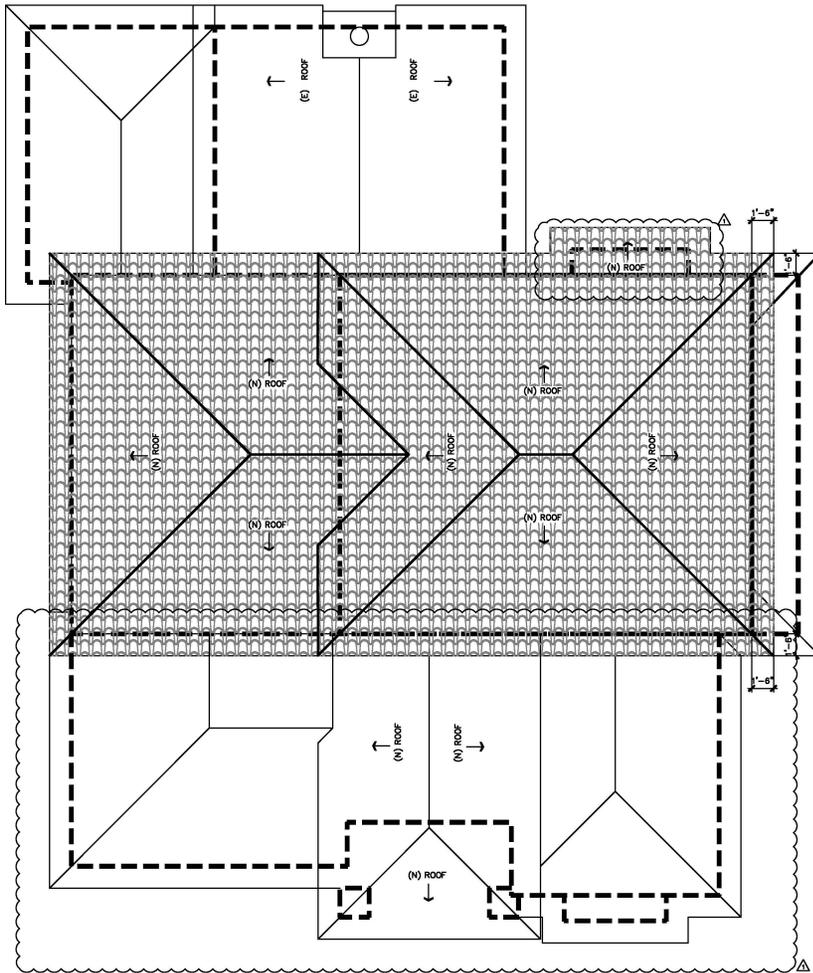

**PROPOSED ROOF PLAN**  
SCALE: 1/4" = 1'-0"

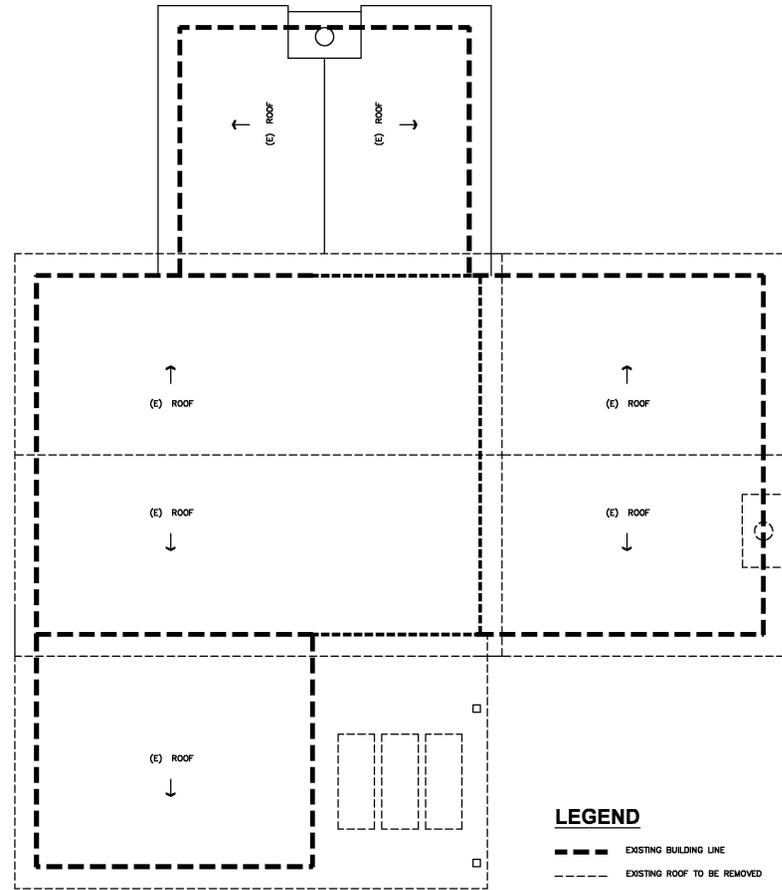


**EXISTING ROOF PLAN**  
SCALE: 1/8" = 1'-0"

**RESIDENCE ADDITION**  
2892 Mesquite Dr, Santa Clara, CA 95051


PROJECT: **RESIDENCE ADDITION**  
SHEET TITLE: **EXISTING & PROPOSED ROOF**

DRAWN BY: *Fiona Wong*  
REVIEWED BY: -  
DATE: -  
SCALE: -


SHEET NO.: **A2.4**  
OF SHEETS

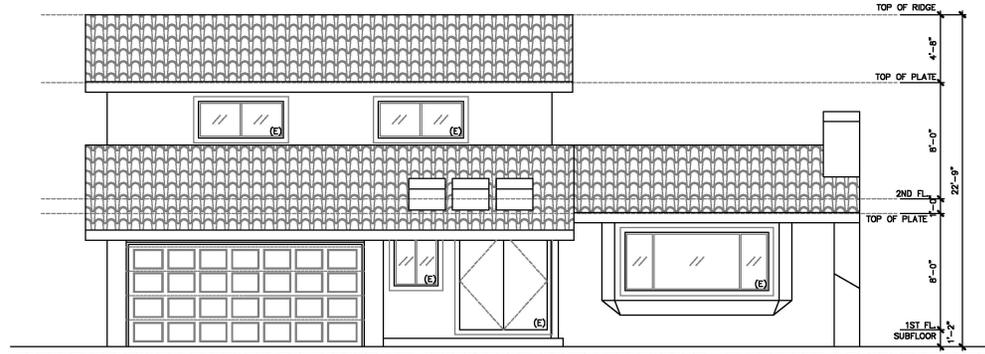

**1 NORTH EXISTING ELEVATION**  
SCALE : 1/4" = 1'-0"

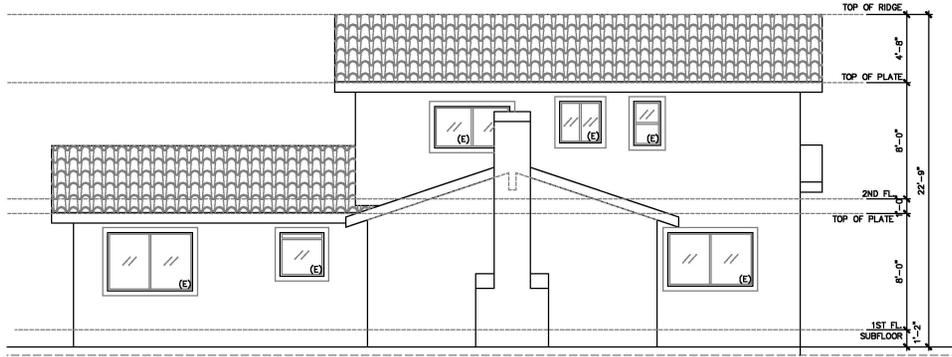

**2 SOUTH EXISTING ELEVATION**  
SCALE : 1/4" = 1'-0"

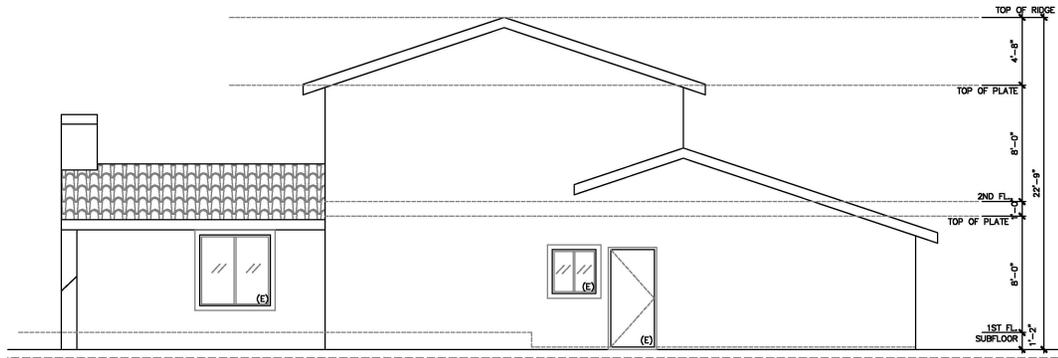

**3 EAST EXISTING ELEVATION**  
SCALE : 1/4" = 1'-0"

REVISIONS	DATE
SUBMITTAL	06/30/25
RE-SUBMITTAL $\Delta$	09/26/25

**RESIDENCE ADDITION**  
2892 Mesquite Dr, Santa Clara, CA 95051

PROJECT: **EXISTING ELEVATIONS**

SHEET TITLE: **EXISTING ELEVATIONS**

DRAWN BY: *Fiona Wong*

REVIEWED BY: -

DATE: -

SCALE: -


SHEET NO.: **A3.1**

OF SHEETS




R1

Best Buy Metals  
 DECRA VILLA STONE COATED METAL TILE ROOFING  
 RUSTICA CLAY

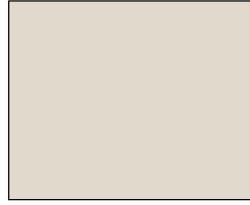


C1

BEHR  
 MASONRY STUCCO & BRICK PAINTS  
 MISTY COVE MS-48\*

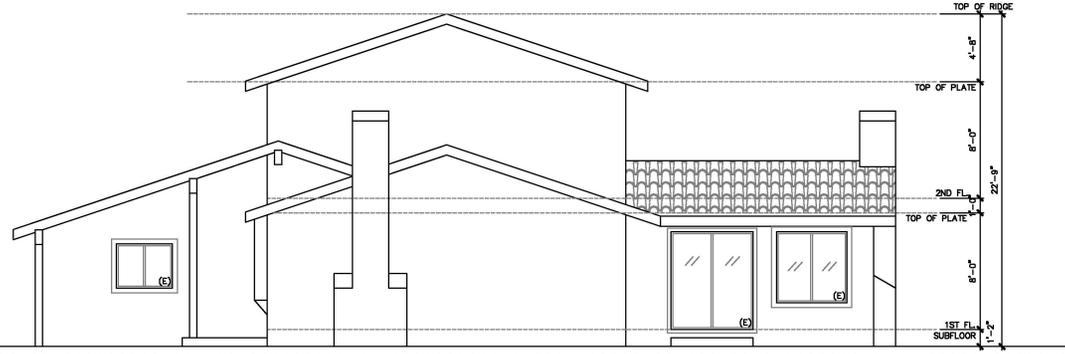


REVISIONS	DATE
SUBMITTAL	08/30/25
RE-SUBMITTAL $\Delta$	09/28/25

**4 WEST EXISTING ELEVATION**  
 SCALE: 1/4" = 1'-0"

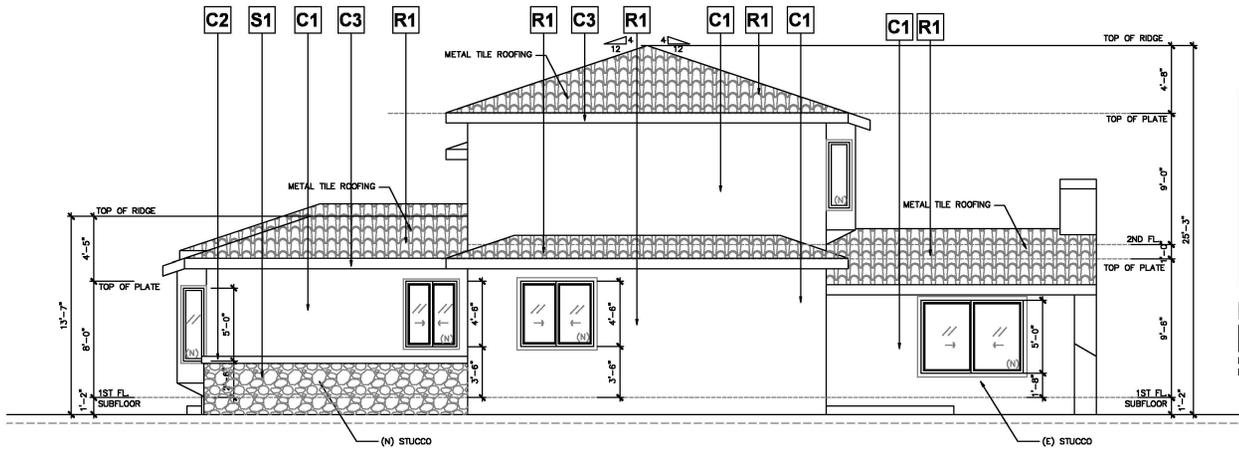

C2  
 BEHR  
 MASONRY STUCCO & BRICK PAINTS  
 MOUNTAIN SUMMIT MS-47\*

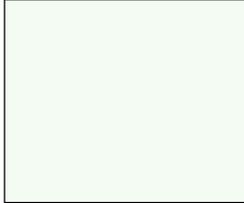


C3  
 BEHR  
 OIL-BASE & ENAMELS URETHANE ALKYD  
 WHITE 7900 (URETHANE ALKYD SATIN)

**5 WEST PROPOSED ELEVATION**  
 SCALE: 1/4" = 1'-0"



S1  
 M-ROCK  
 GEORGETOWN COBBLE STONE CONCRETE STONE VENER  
 TRADITIONAL 1.5 IN. TO 4 IN. X 5 IN. TO 9 IN.

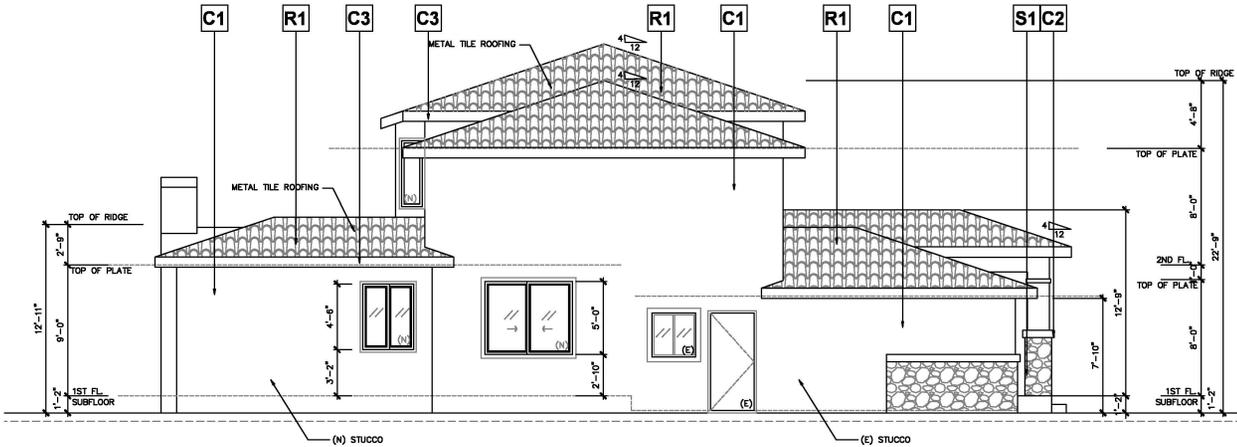


**6 EAST PROPOSED ELEVATION**

**RESIDENCE ADDITION**  
 2892 Mesquite Dr, Santa Clara, CA 95051


PROJECT:  
 SHEET TITLE:  
**PROPOSED ELEVATIONS**

DRAWN BY: *Fina Way*  
 REVIEWED BY: -  
 DATE: -  
 SCALE: -

SHEET NO.:  
**A3.2**  
 OF SHEETS

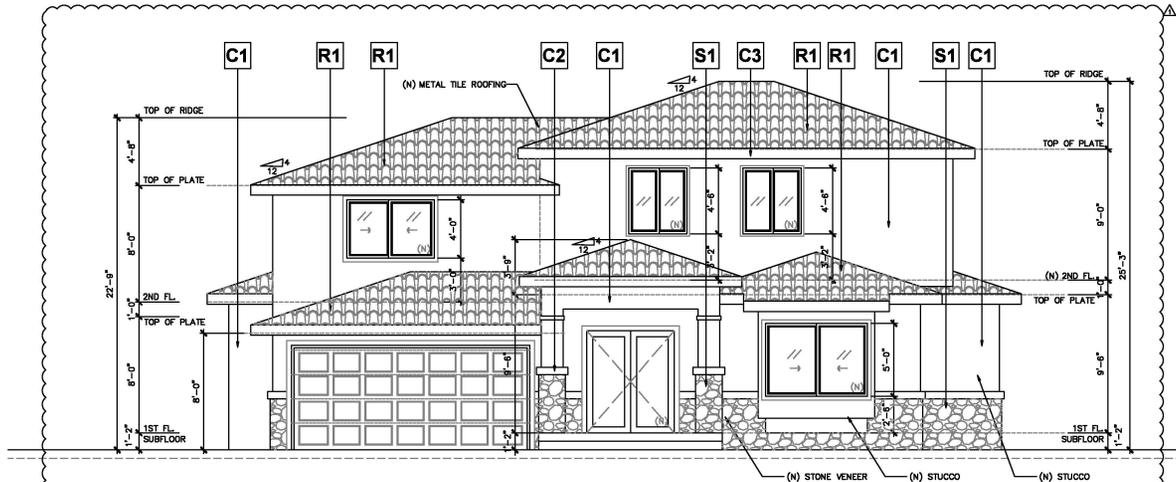

**7 NORTH PROPOSAL ELEVATION**  
SCALE: 1/4" = 1'-0"

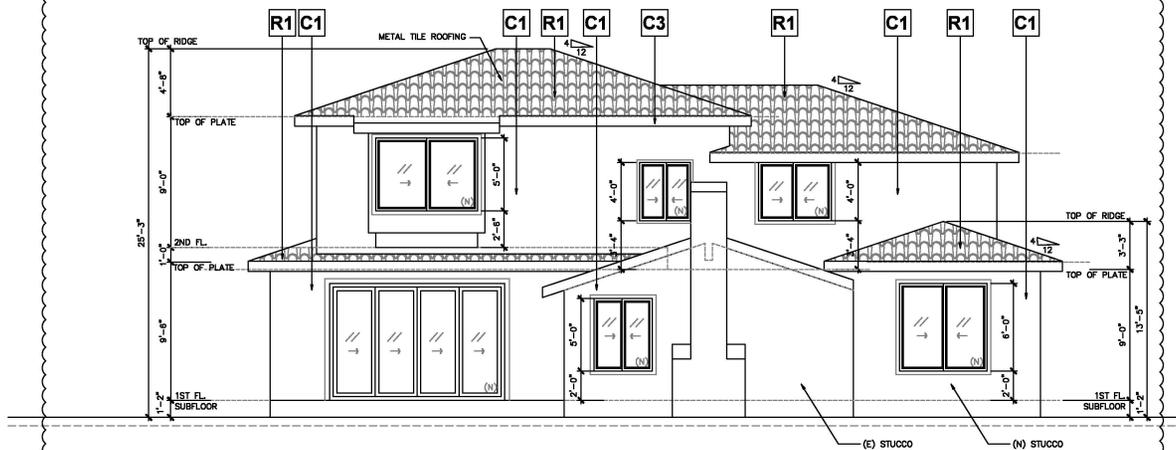

**8 NORTH PROPOSAL ELEVATION**  
SCALE: 1/4" = 1'-0"


REVISIONS	DATE
SUBMITAL	06/30/25
RE-SUBMITAL	09/26/25

**PROJECT:**  
**RESIDENCE ADDITION**  
2892 Mesquite Dr, Santa Clara, CA 95051


**SHEET TITLE:**  
**PROPOSED ELEVATIONS**

**DRAWN BY:** *Fiona Wong*  
**REVIEWED BY:** -  
**DATE:** -  
**SCALE:** -

**SHEET NO.:**  
**A3.3**  
OF SHEETS

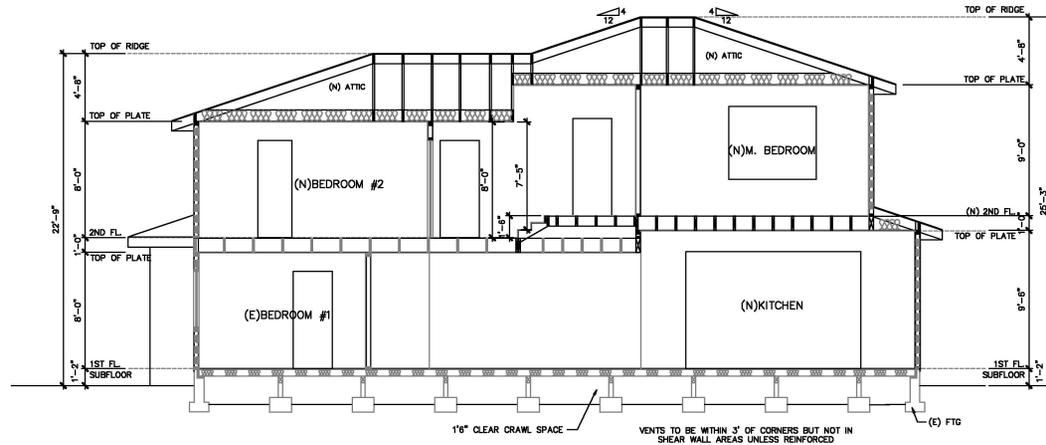

**9** PROPOSED SECTION 1  
SCALE: 1/4" = 1'-0"

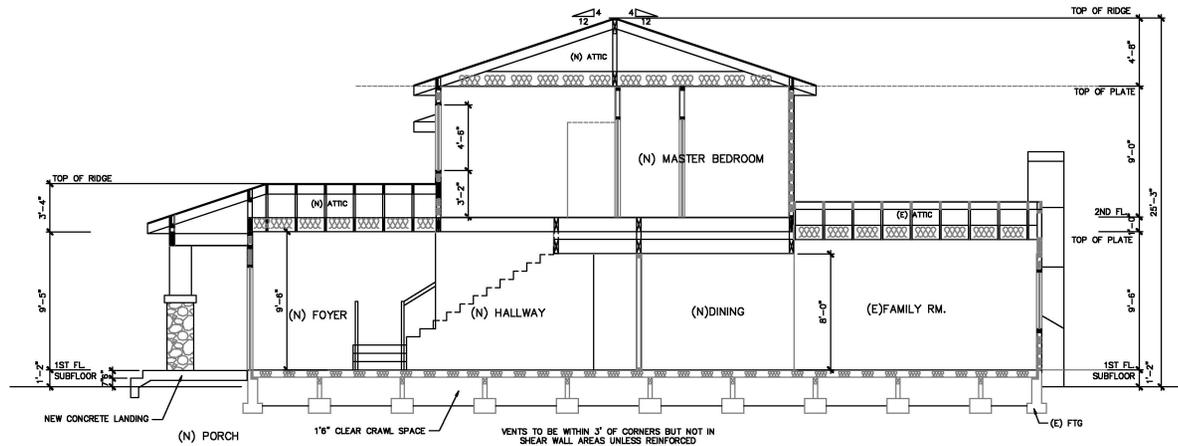

**10** PROPOSED SECTION 2  
SCALE: 1/4" = 1'-0"

REVISIONS	DATE
SUBMITAL	06/30/25
RE-SUBMITAL $\Delta$	09/26/25

**PROJECT:**

**RESIDENCE ADDITION**  
2892 Mesquite Dr, Santa Clara, CA 95051

**SHEET TITLE:**

**PROPOSED SECTIONS**

**DRAWN BY:** *Fiona Wong*

**REVIEWED BY:** -

**DATE:** -

**SCALE:** -

**SHEET NO.:**

**A3.4**

OF SHEETS

**City of Santa Clara**  
The Center of Where Possible

Building Division: 408-615-2440  
Email: [Buildings@santacruz.gov](mailto:Buildings@santacruz.gov)  
Permit Center: 408-615-2400  
Email: [PermitCenter@santacruz.gov](mailto:PermitCenter@santacruz.gov)  
Automated Inspection Scheduling System: 408-615-2400

**2022 CALIFORNIA GREEN BUILDING CODE (CGC)  
RESIDENTIAL CHECKLIST – Effectively July 1<sup>st</sup>, 2024**

New residential buildings shall be designed to include the green building mandatory measures specified in this checklist. This checklist shall also be applied to additions or alterations of existing residential buildings where the addition or alteration increases the building's conditioned area, volume, or size. The requirements shall apply only to the specific area of the addition or alteration.

BUILDING PERMIT NO.: BLD 20892 Mesquite Dr, Santa Clara, CA 95051

Feature or Measure	Yes
<b>SITE DEVELOPMENT (CGC 4.106)</b>	
<b>Storm water drainage and retention during construction.</b> A plan shall be developed and shall be implemented to manage storm water drainage during construction per CGC 4.106.2.	<input checked="" type="checkbox"/>
<b>Grading and paving.</b> Construction plans shall indicate how site grading or a drainage system will manage all surface water flows to keep water from entering buildings per CGC 4.106.3.	<input checked="" type="checkbox"/>
<b>Electric vehicle (EV) charging for new one- and two-family dwellings and town-houses with attached private garages and/or parking spaces not assigned to a dwelling unit, and ADU/ADU without additional parking but with electrical panel upgrades or new panels.</b> Provide electric vehicle charging with minimum required Level 1 EV Ready, Level 2 EV Ready, Low Power Level 2 EV Ready as specified in CGC 4.109.4.1 as amended by City of Santa Clara Reach Code Ordinance No.2096 (CSC 2023 Reach Code) section 15.38.04D.	<input checked="" type="checkbox"/>
<b>Identification.</b> The receive/arrival location shall be permanently and visibly marked as "Level 2 EV-READY" per CGC 4.106.4.1.1 as amended by CSC 2023 Reach Code section 15.38.04D.	<input type="checkbox"/>
<b>Electric vehicle (EV) charging for new multifamily dwellings, affordable housing, hotels, motels, and new residential parking facilities.</b> Provide electric vehicle infrastructure and capability for electric vehicle charging with minimum required Level 2 EV Charger, Level 1 EV Ready, Level 2 EV Ready, Low Power Level 2 EV Ready, EV Capable as specified in CGC 2023 Reach Code section 15.38.04D and 2022 California Green Code section 4.108.4.2, whichever is more stringent.	<input type="checkbox"/>
<b>110V Electrical Outlet at Bicycle Parking.</b> All multifamily residential developments shall include secure bicycle parking with 110V electrical outlets per CSC 2023 Reach Code section 15.38.04D.	<input type="checkbox"/>
<b>Location.</b> EVCS shall be located adjacent to an accessible parking space, and/or on an accessible route, per CGC 4.106.4.2.2.1.1.	<input type="checkbox"/>
<b>Dimension.</b> Each EV ready space or EVCS shall be minimum 18 ft long and 5 ft wide. One in every 25 charging spaces, but not less than one, shall have an 8 ft wide access aisle. A 5 ft wide minimum aisle shall be permitted provided the minimum width of the EV space is 12 feet. Surface slope for the EV space and the aisle shall not exceed 2.083% slope in any direction, per CGC 4.106.4.2.2.1.1.	<input type="checkbox"/>
<b>Accessibility.</b> EV Ready and EVCS spaces shall comply with the accessibility provisions for EV charging stations in California Building Code Chapter 11A (Section 1108A) and Chapter 11B, per CGC 4.106.4.2.2.1.2.	<input type="checkbox"/>
<b>EV Ready Space Signage.</b> EV ready spaces shall be identified by signage or pavement markings, in compliance with California Traffic Operations Policy Directive 13-01 (Zero Emission Vehicle Signs and Pavement Markings) or its successor(s), per CGC 4.106.4.2.5.	<input type="checkbox"/>
<b>Automatic load management system (ALMS)</b> may be installed to increase the number of EV chargers or the amperage or voltage beyond the minimum requirements in this code. The code does not allow for installing less electrical panel capacity than would be required without ALMS, per CGC 4.106.4.2.2 as amended by CSC 2023 Reach Code section 15.38.04D.	<input type="checkbox"/>

R501 2022 Green Building Residential- Revised 07-2024.docx Page 1 of 4

BLD Permit No. \_\_\_\_\_

<b>Electric vehicle (EV) charging for additions or alterations of parking facilities serving existing multifamily buildings.</b> When new parking facilities are added, or electrical systems or lighting of existing parking facilities are added or altered and the work requires a permit, the work shall include the installation of electric vehicle charging spaces capable of supporting Future Level 2 electric vehicle supply equipment (EVSE) per CGC 4.109.4.3. The service panel or subpanel circuit directory shall identify the associated electric vehicle charging spaces (EVCS) reserved for future EV charging purposes as per CGC 4.109.4.3.	<input type="checkbox"/>
<b>ENERGY EFFICIENCY (CGC 4.201)</b>	<input checked="" type="checkbox"/>
<b>California Energy Code.</b> The building construction shall meet or exceed the requirements of the 2022 California Building Energy Efficiency Standards per CGC 4.201.1.	<input checked="" type="checkbox"/>
<b>WATER EFFICIENCY AND CONSERVATION</b>	
<b>INDOOR WATER USE (CGC 4.303)</b>	
<b>Water conserving plumbing fixtures and fittings.</b> Plumbing fixtures (batter closets and urinals) and fittings (faucets, showerheads, pre-rinse spray valves) shall comply with the prescriptive requirements of Section 4.303.1.1 through 4.303.1.4.5.	<input checked="" type="checkbox"/>
<b>Water closets.</b> The effective flush volume of all water closets shall not exceed 1.28 gallons per flush (CGC 4.303.1.1.1).	<input checked="" type="checkbox"/>
<b>Urinals.</b> The effective flush volume of wall-mounted urinals shall not exceed 0.125 gallons per flush, and all other urinals shall not exceed 0.5 gallons per flush (CGC 4.303.1.1.2).	<input type="checkbox"/>
<b>Showerheads.</b> The flow rate for single showerhead and multiple showerheads serving one shower shall not exceed 1.8 gallons per minute at 80 psi and shall be certified to the performance criteria of the U.S. EPA WaterSense Specification (CGC 4.303.1.3).	<input checked="" type="checkbox"/>
<b>Residential lavatory faucets.</b> The flow rate shall not be more than 1.2 gallons per minute at 80 psi, and not less than 0.8 gallons per minute at 20 psi (CGC 4.303.1.4.1).	<input type="checkbox"/>
<b>Lavatory faucets in common and public use areas.</b> The flow rate shall not exceed 0.5 gallons per minute at 80 psi (CGC 4.303.1.4.2).	<input type="checkbox"/>
<b>Matting Faucets.</b> The flow rate shall not deliver more than 0.2 gallons per cycle (CGC 4.303.1.4.3).	<input checked="" type="checkbox"/>
<b>Kitchen Faucets.</b> The flow rate shall not exceed 1.8 gallons per minute at 80 psi (CGC 4.303.1.4.4).	<input checked="" type="checkbox"/>
<b>Pre-rinse Spray Valves.</b> When installed, shall meet the requirements of Title 20 of the California Code of Regulations, and shall be equipped with an integral automatic shutoff (CGC 4.303.1.4.5).	<input checked="" type="checkbox"/>
<b>Submerses for multifamily buildings and dwelling units in mixed-use residential/commercial buildings.</b> Submerses shall be installed to measure water usage of individual residential units in accordance with the California Plumbing Code per CBC 4.303.2.	<input type="checkbox"/>
<b>Standards for plumbing fixtures and fittings.</b> Plumbing fixtures and fittings shall meet the applicable standards referenced in Table 1701.1 of the California Building Code (CGC 4.303.3).	<input checked="" type="checkbox"/>
<b>OUTDOOR WATER USE (CGC 4.304)</b>	
<b>Outdoor potable water use in landscape areas.</b> Residential developments shall comply with the City's Water Service and Rules and Regulations, Item No. 24 as adopted by Santa Clara City Code Section 13.15.160, or the California Model Water Efficient Landscape Ordinance (MWELO), whichever is more stringent, per CGC 4.304.1.	<input type="checkbox"/>
<b>ENHANCED DURABILITY AND REDUCED MAINTENANCE (CGC 4.408)</b>	
<b>Roofing profile.</b> Flat roof spaces around pipes, electric cables, conduits, or other openings in subsoilment plates at exterior walls shall be roofed/poofed by using such openings with cement mortar, concrete masonry, or similar method acceptable to the City per CGC 4.408.1.	<input type="checkbox"/>
<b>CONSTRUCTION WASTE REDUCTION, DISPOSAL AND RECYCLING (CGC 4.409)</b>	
<b>Construction waste management.</b> Recycle and/or salvage for reuse a minimum of 65% of nonhazardous construction and demolition waste in accordance with Section 4.409.2, 4.409.3, or 4.409.4, or meet a more stringent local construction and demolition waste management ordinance (CGC 4.409.1).	<input checked="" type="checkbox"/>
<b>BUILDING MAINTENANCE AND OPERATION (CGC 4.410)</b>	
<b>An operation and maintenance manual</b> shall be provided to the building occupant or owner per CGC 4.410.1.	<input checked="" type="checkbox"/>

R501 2022 Green Building Residential- Revised 07-2024.docx Page 2 of 4

BLD Permit No. \_\_\_\_\_

<b>Recycling by occupants.</b> Where 5 or more multifamily dwelling units are constructed on a building site, provide readily accessible areas that serve all buildings on the site and are identified for depositing, storage and collection of nonhazardous materials for recycling per CGC 4.410.2.	<input type="checkbox"/>
<b>ENVIRONMENTAL QUALITY (CGC 4.500)</b>	
<b>Gas fireplace.</b> Any installed gas fireplaces shall be a direct-vent sealed-combustion type per CGC 4.500.1.	<input type="checkbox"/>
<b>Woodstoves.</b> Any installed woodstove or pellet stove shall comply with U.S. EPA New Source Performance Standards (NSPS) emission limits as applicable and shall have a permanent label indicating they are certified to meet the emission limits per CGC 4.500.1. Woodstoves and pellet stoves shall also comply with Santa Clara City Code Chapter 15.65.	<input type="checkbox"/>
<b>POLLUTANT CONTROL (CGC 4.504)</b>	
<b>Covering of duct openings and protection of mechanical equipment during construction.</b> At the time of roof installation, during storage on the construction site and until final startup of the heating, cooling and ventilating equipment, all duct and other related air distribution component openings shall be covered with base, plastic, sheet metal, or other methods acceptable to the City to reduce the amount of water, dust or debris, which may enter the system per CGC 4.504.1.	<input type="checkbox"/>
<b>Adhesives, sealants and caulks</b> shall meet the VOC or other toxic compound limits per CGC 4.504.2.1.	<input checked="" type="checkbox"/>
<b>Paints, stains and other coatings</b> shall comply with VOC limits per CGC 4.504.2.2.	<input type="checkbox"/>
<b>Aerosol paints and coatings</b> shall meet the product-weighted MVR limits for VOC and other requirements per CGC 4.504.2.3.	<input checked="" type="checkbox"/>
<b>Verification.</b> Documentation shall be provided, at the request of the Building Division, to verify that compliant VOC-limit finish materials have been used per CGC 4.504.2.4.	<input type="checkbox"/>
<b>Carpet systems.</b> All carpet installed in the building interior shall meet the testing and product requirements of CGC 4.504.3.	<input type="checkbox"/>
<b>Resilient flooring systems.</b> Where resilient flooring is installed, at least 80% of the floor area receiving resilient flooring shall comply with the requirements of CGC 4.504.4.	<input type="checkbox"/>
<b>Composite wood products.</b> Hardwood plywood, particleboard and medium density fiberboard composite wood products used on the interior or exterior of the building shall comply with the formaldehyde emission standards and requirements per CGC 4.504.5.	<input type="checkbox"/>
<b>INTERIOR MOISTURE CONTROL (CGC 4.606)</b>	
<b>Concrete slab foundations.</b> Vapor retarder and capillary break shall be installed if a slab-on-grade foundation system is used. The use of a 4" thick base of 3/4" or larger clean aggregate under a 10-mil vapor retarder with joints taped not less than 6" shall be provided per CGC 4.606.2, CRC R506.2.2, CRC R506.2.3 and CBC Section 1905.	<input type="checkbox"/>
<b>Moisture content of building material.</b> Building materials with visible signs of water damage shall not be installed. Wall and floor framing shall not be installed when framing members exceed 19% moisture content. Moisture content shall be checked prior to finish material being applied per CGC 4.606.3.	<input type="checkbox"/>
<b>INDOOR AIR QUALITY AND EXHAUST (CGC 4.608)</b>	
<b>Bathroom exhaust fans.</b> Each bathroom shall be mechanically ventilated using ENERGY STAR compliant fans ducted to the exterior and equipped with humidity controls system per CGC 4.608.1.	<input type="checkbox"/>
<b>ENVIRONMENTAL COMFORT (CGC 4.607)</b>	
<b>Heating and air-conditioning system</b> shall be sized, designed and have their equipment selected using the following methods per CGC 4.607.2: 1. Heat Load/Heat Gain values in accordance with ANSI/ACCA 2 Manual J-2016, ASHRAE handbook or equivalent. 2. Duct systems are sized according to ANSI/ACCA 1 Manual D-2016, ASHRAE handbook or equivalent. 3. Select heating and cooling equipment in accordance with ASHRAE/ACCA 3 Manual S-2014 or equivalent.	<input type="checkbox"/>
<b>INSTALLER AND SPECIAL INSPECTOR QUALIFICATION (CGC 702)</b>	
<b>Installer training.</b> HVAC system installers shall be trained and certified in the proper installation of HVAC systems including ducts and equipment by a recognized training or certification program per CGC 702.1.	<input type="checkbox"/>
<b>Special inspection.</b> Special inspectors employed by the City must be qualified and able to demonstrate competence in the discipline they are inspecting per CGC 702.2.	<input type="checkbox"/>

R501 2022 Green Building Residential- Revised 07-2024.docx Page 3 of 4

BLD Permit No. \_\_\_\_\_

<b>VERIFICATION (CGC 703)</b>	
<b>Documentation.</b> Upon request, verification of compliance with this code may include construction documents, plans, specifications, builder or installer certification, inspection reports, or other methods acceptable to the building department which will show substantial performance per CGC 703.1.	<input checked="" type="checkbox"/>
<b>Responsible Designer's Declaration Statement</b>	<b>Contractor Declaration Statement</b>
I hereby certify that this project has been designed to meet the requirements of the 2022 California Green Building Standards Code.	I hereby certify, as the builder or installer under the permit listed herein, that this project will be constructed to meet the requirements of the California Green Building Standards Code.
Name: Fiona Wang	Name: _____
Signature: <i>Fiona Wang</i>	Signature: _____
Date: 06/30/2025	Date: _____
Company: Fiona Wang Design	License: _____
Address: 255 N 11th Street	Address: _____
City: San Jose State: CA Zip: 95112	City: _____ State: _____ Zip: _____

R501 2022 Green Building Residential- Revised 07-2024.docx Page 4 of 4

BLD Permit No. \_\_\_\_\_

**City of Santa Clara**  
The Center of Where Possible

**RESIDENTIAL CONDENSATE DISPOSAL REQUIREMENTS**

Building Division: 408-615-2440  
Email: [Buildings@santacruz.gov](mailto:Buildings@santacruz.gov)  
Permit Center: 408-615-2400  
Email: [PermitCenter@santacruz.gov](mailto:PermitCenter@santacruz.gov)  
Automated Inspection Scheduling System: 408-615-2400

Air conditioner cooling coils require a condensate drain with a trap in accordance with the manufacturer's instructions [CMC 310.1]. The drain must discharge by gravity to a drywell or an indirect waste, or to a condensate pump that connects to an indirect waste. An indirect waste connection can be made to a junior sink or laundry standpipe, an accessible toilet or a bathtub overflow, or to a lavatory fixture in the unit controlled by the same person controlling the air-conditioned space [CMC 310.6]. Condensate from a high efficiency (Category IV) furnace can be combined with the AC condensate. Condensate cannot be combined with the discharge of a temperature and pressure relief valve [CPC 608.5]. Condensate waste pipes must be at least 1/2 inch in diameter and slope at least 1/8 inch per foot. Condensate pumps are allowed if interlocked to prevent AC operation during pump failure. Condensate pump discharge tubing must rise vertically to a point where it is possible to connect to a gravity condensate drain [CMC 310.1.1].

Air conditioner cooling coils in an attic or over any other area where leakage could cause damage require protection to prevent damage in the event of a blocked drain. 4 methods are acceptable (1) a drain pan that extends fully beneath the area of the cooling unit and equipped with a separate drain line; (2) a separate drain line at a higher location in the AC unit's drain pan; (3) a drain pan without a discharge line but equipped with a water-level detection device interlocked to the appliance; (4) a water-level detection device interlocked to the appliance – typically located in the drain trap. For methods 1 & 2, the discharge pipe must go to a location that is readily observed – typically over a window. [CMC 310.2] These requirements also apply to high-efficiency (Category IV) furnaces.

At traps required in accordance with the manufacturer's instructions, the trap shall be sealed with a seal with the air pressure of the coil, and a vent shall be installed after the trap. An alternate to the pan or drain, an interlocked floor switch can be installed in accordance with equipment installation instructions.

Minimum slope = 1/8 inch per foot

Residential condensate is typically terminated in drywells. Drywell specifications are as follows:

- The minimum size of a residential drywell is 2-foot square by 2-foot deep.
- The nearest edge of the drywell shall be at least 3 feet from any structure or building foundation.
- The drywell shall be filled with minimum 1" rock.
- The top of the drywell shall be covered with building paper or plastic sheeting with 6" of earth or concrete above the paper.
- The condensate pipe from the cooling coil (min. 1/2") shall connect indirectly to a minimum 1 1/4" diameter. The indirect connection shall be made by an air break at the edge of the foundation.

R502 Residential Condensate Disposal Requirement- Revised 01-2023.docx Page 2 of 2

**COMMERCIAL / INDUSTRIAL REQUIREMENTS**

Terminating condensate discharge from commercial and industrial air-conditioning units must follow these specifications:

- Trap and vent the air-conditioning condensate drains per the condition of the listing of the equipment and in accordance with the requirements of the Uniform Mechanical Code.
- Terminate the condensate using one of the following methods:
  - To a landscaped area properly designed to accommodate the volume of condensate.
  - To a properly designed storm-water treatment system, e.g., a bio-retention unit.
  - Indirectly to the sanitary sewer, subject to all wastewater permitting requirements and fees. Contact the Environmental Services Department at 408-763-5300.
  - If none of the above methods is feasible, the City Building Division may allow an indirect discharge of condensate to the storm drain system. Indirect connections must be outside the building. The condensate drain line must be hard piped to the storm drain.

**Terminating the condensate to a parking lot or roof surface is not allowed.**

**PROJECT:** RESIDENCE ADDITION  
2892 Mesquite Dr, Santa Clara, CA 95051

**SHEET TITLE:** GREEN BUILDING CHECK LIST

**DRAWN BY:** Fiona Wang  
**DATE:** -  
**SCALE:** -

**SHEET NO.:** GBCL  
OF SHEETS

R502 Residential Condensate Disposal Requirement- Revised 01-2023.docx Page 2 of 2

REVISIONS	DATE
SUBMITAL	06/30/25
RE-SUBMITAL	09/26/25

**PROJECT:** RESIDENCE ADDITION  
2892 Mesquite Dr, Santa Clara, CA 95051

**SHEET TITLE:** GREEN BUILDING CHECK LIST

**DRAWN BY:** Fiona Wang  
**DATE:** -  
**SCALE:** -

**SHEET NO.:** GBCL  
OF SHEETS